



Admin. & creatively
Approved 11/2/87
(dd)

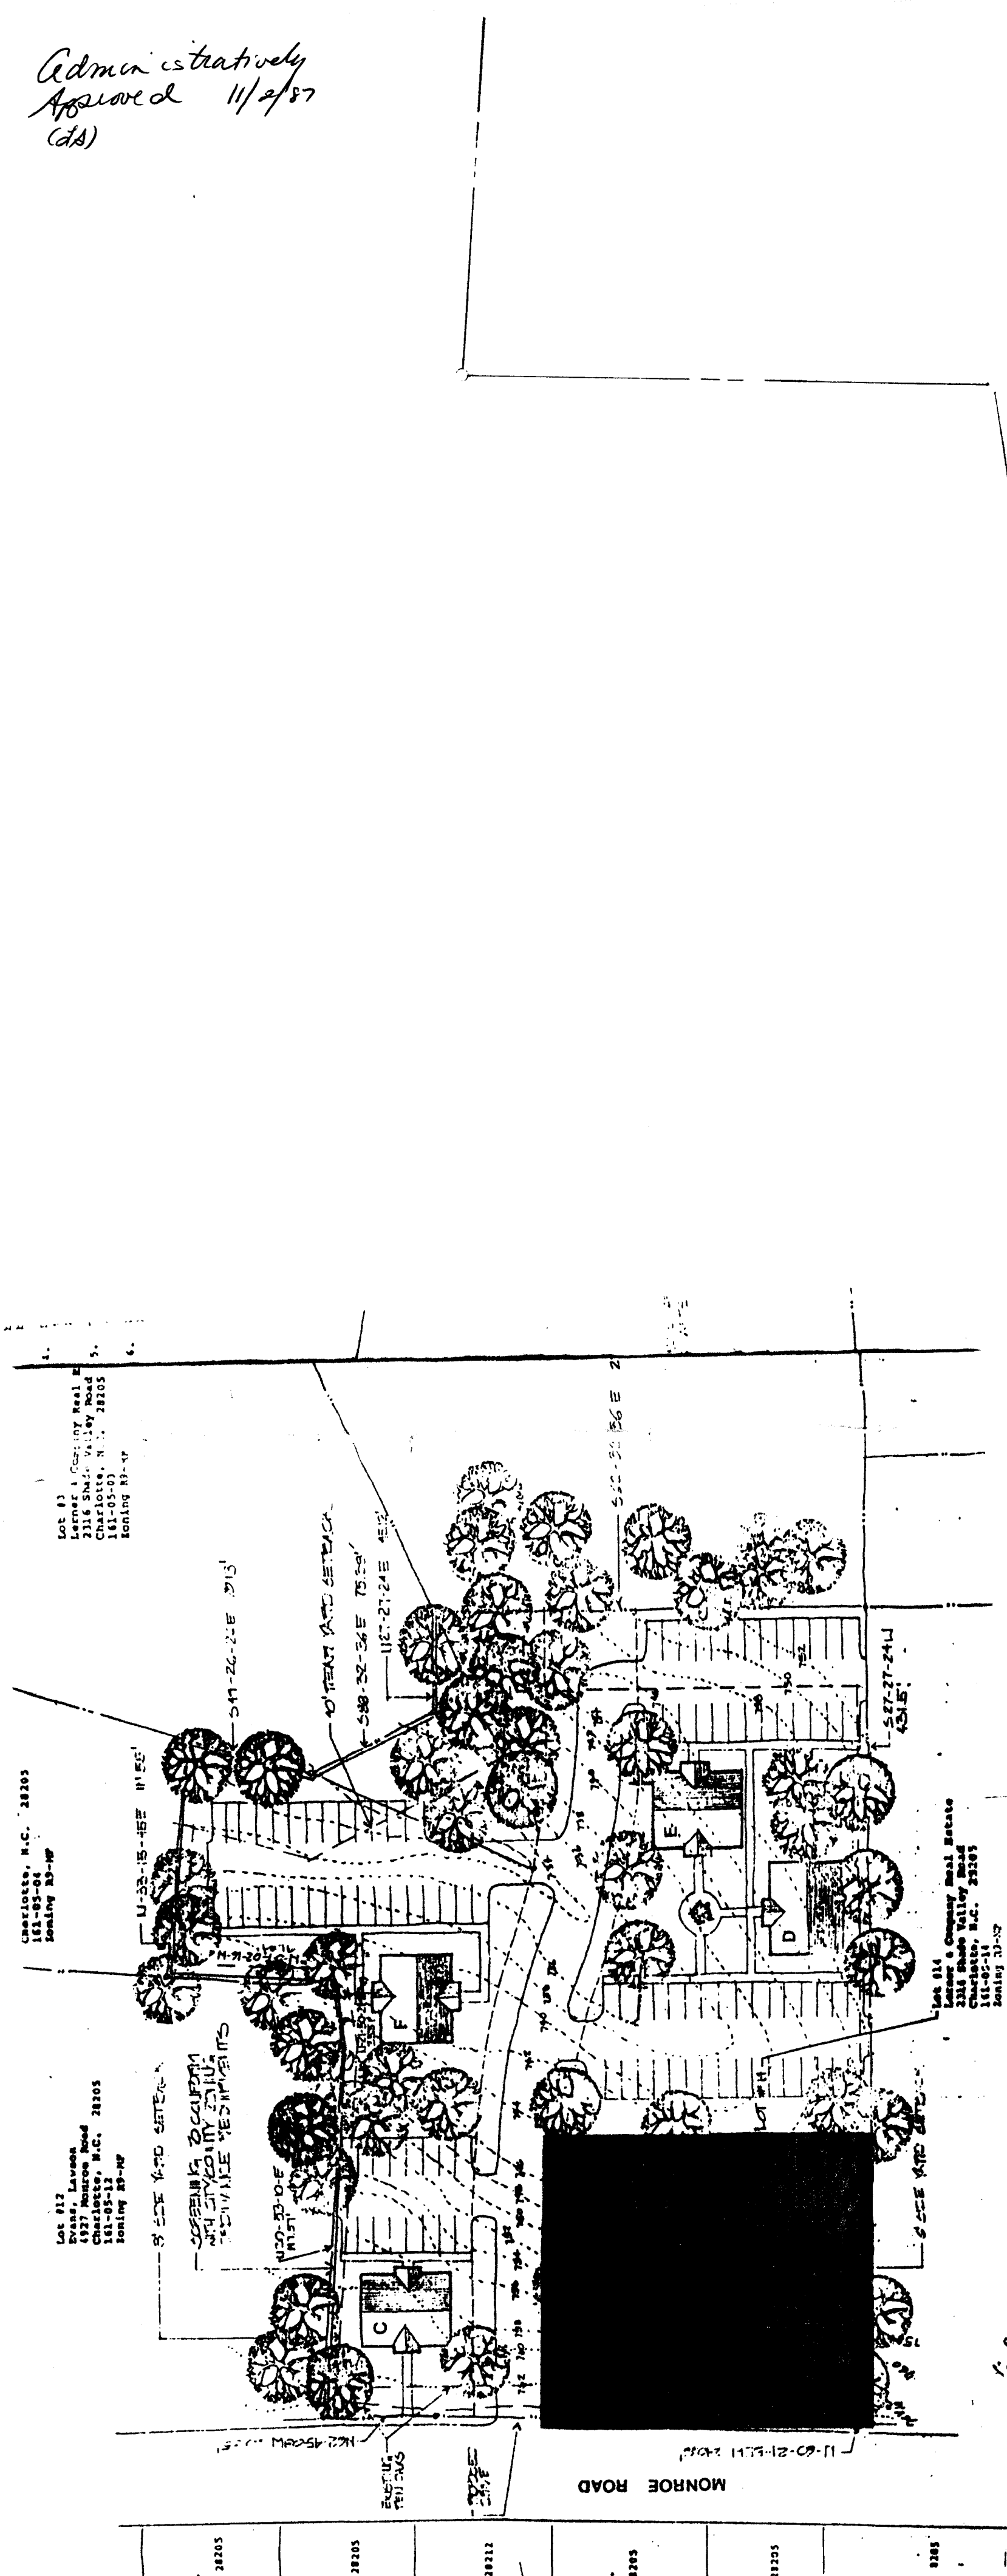

LOCATION PLAN

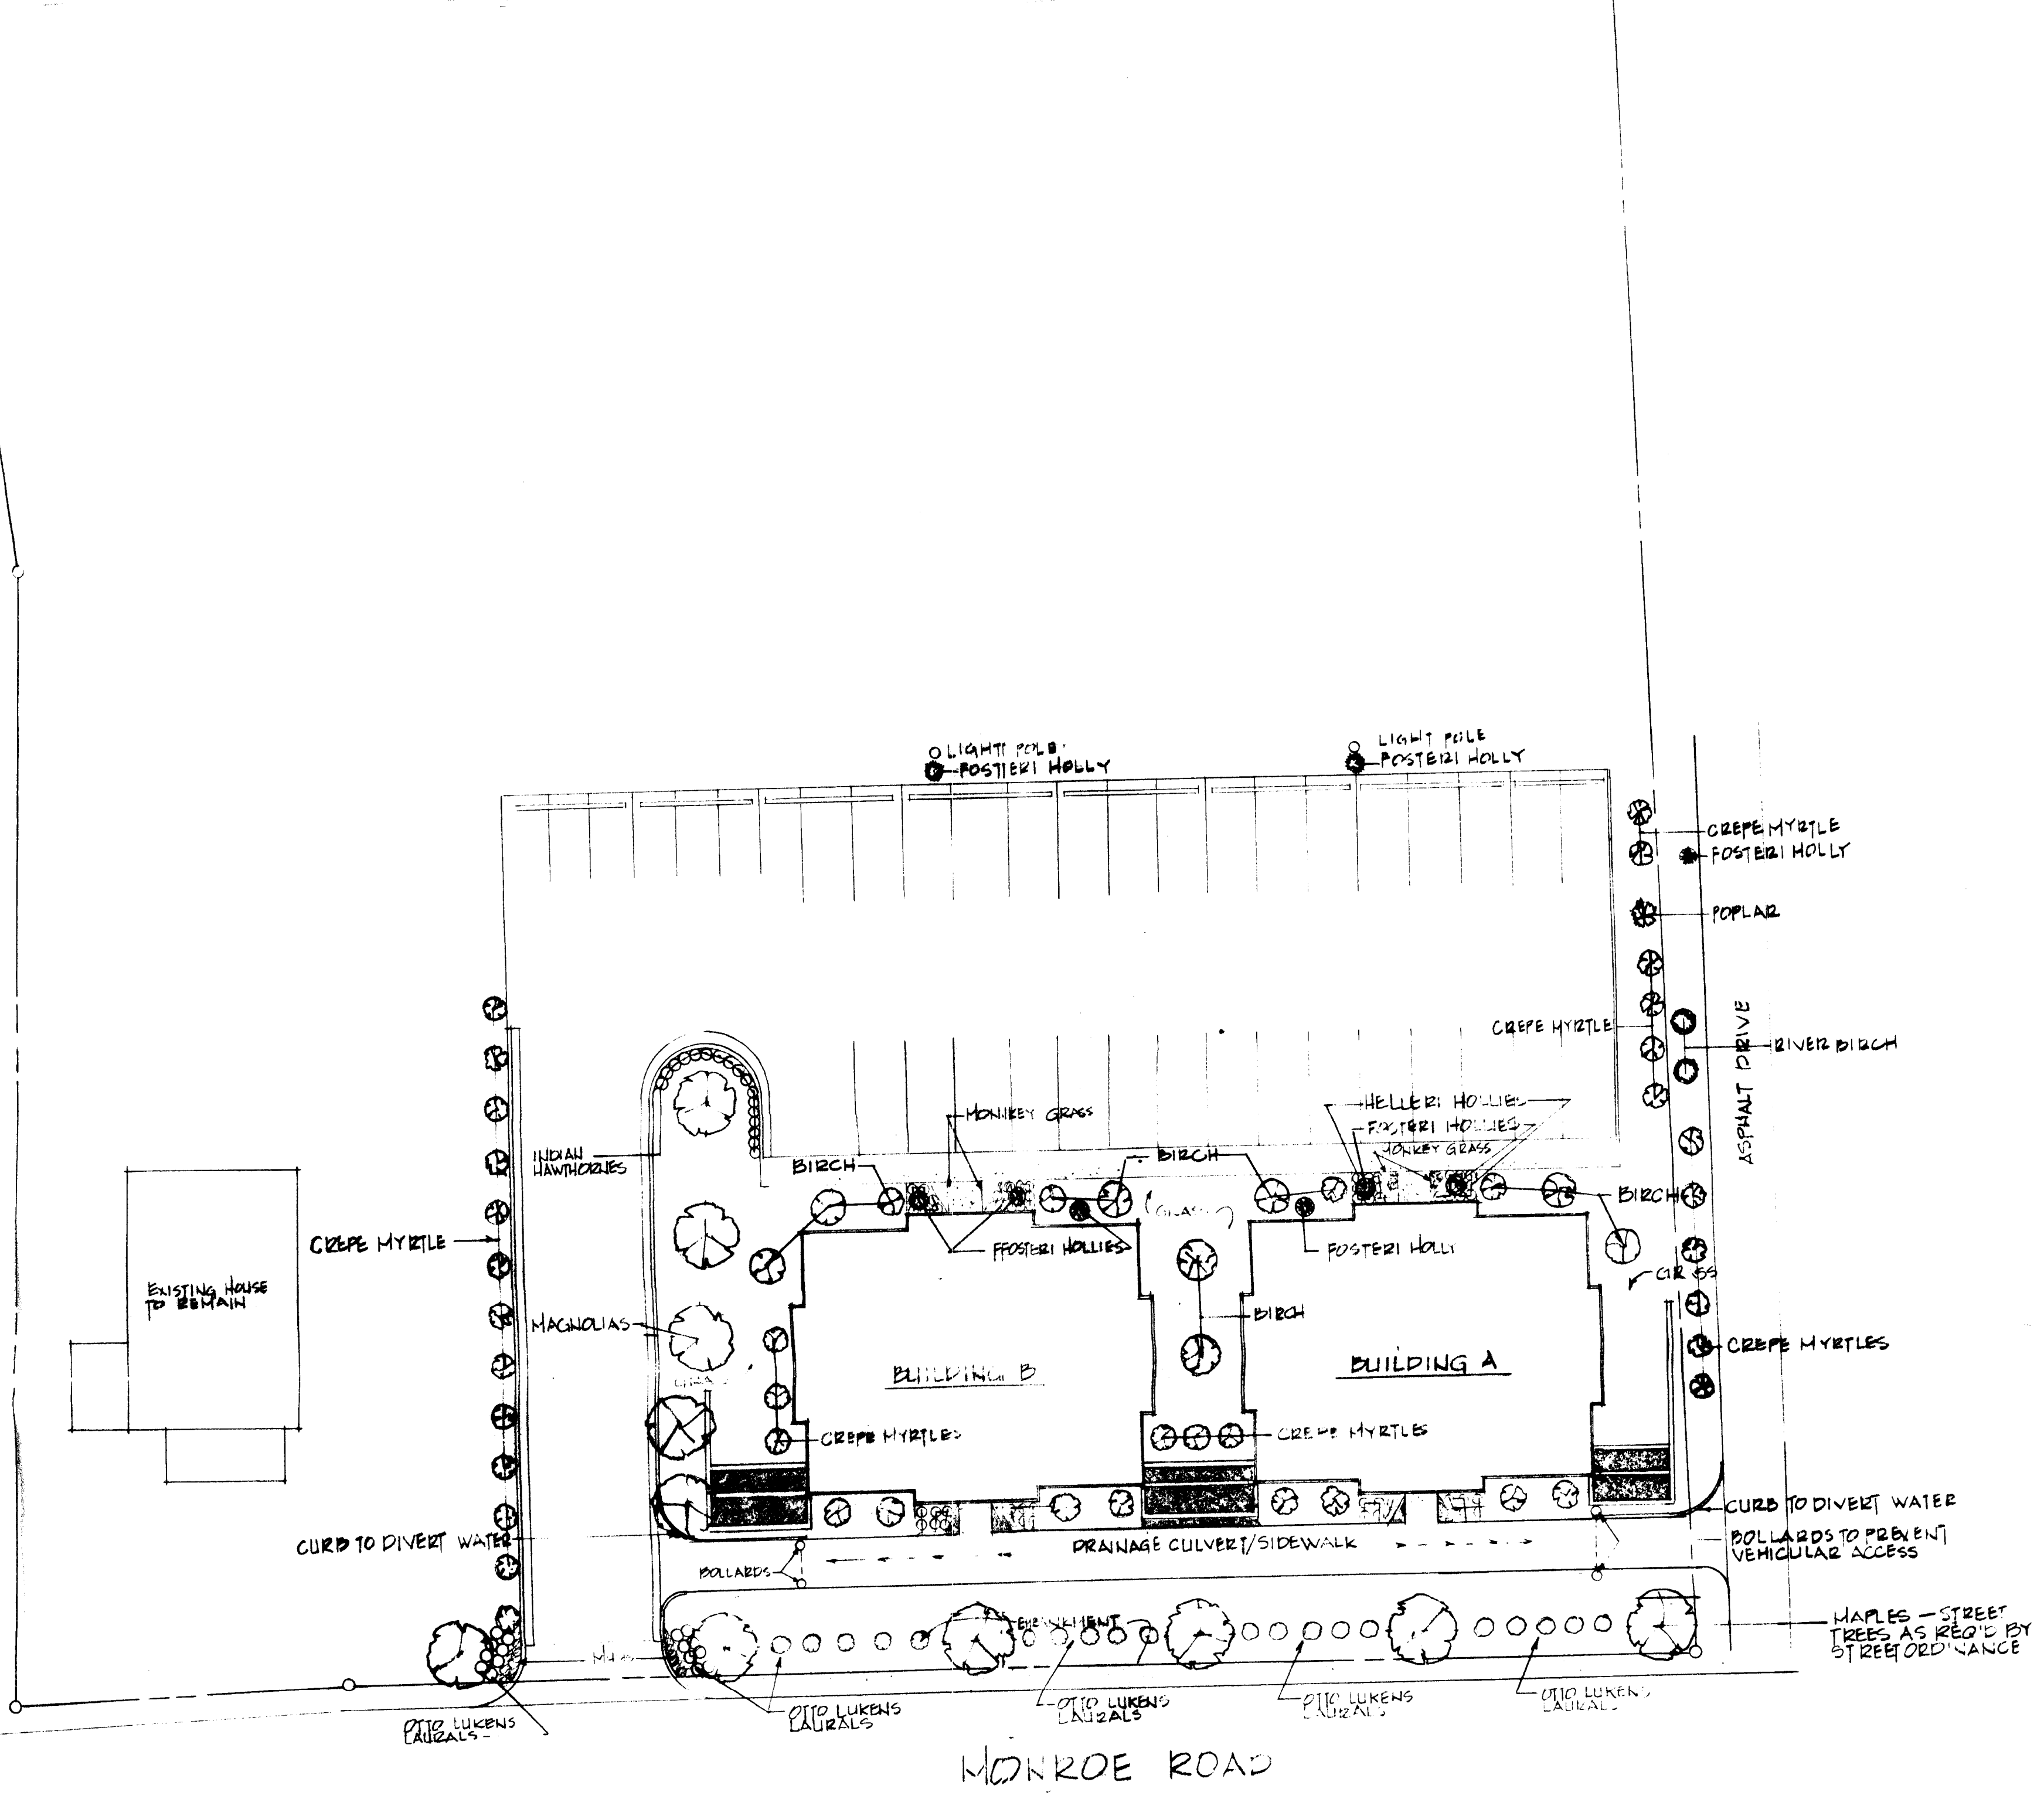

SITE PLAN (AS BUILT)
SCALE: 1" = 20'

CHARLOTTE-MECKLENBURG
PLANNING COMMISSION
INTER-OFFICE COMMUNICATION

DATE November 2, 1987

TO: Mr. Dale Long,
Zoning Administrator

FROM: Martin R. Cramton, Jr.,
Planning Director
Martin R. Cramton, Jr.
(2)

SUBJECT: Administrative Approval of Site Plan Amendment
Petition No. 85-53
Samuel Lerner

Attached please find a revised site plan for the above referenced petition. The new site plan reflects the relocation of the sidewalks along Monroe Road. Pursuant to my authority as outlined in the zoning ordinance, I am administratively approving this plan. Please use it when evaluating requests for building permits.

MRC/LS:als
Attachment
cc: Lerner and Company Real Estate