



* 0 0 B R E A K 0 0 *



**ADVANCED
IMAGING
SYSTEMS**

www.aisinc.com

An Information
Management Company

City of Charlotte – Planning Dept. Scanning Rezoning Files

Petition # _____


Document type:

- Applications
- Correspondence
- Department Comments
- Land Use Consistency
 - Mail Info
 - Mapping
 - Other
- Site Plans



* 0 0 B R E A K 0 0 *

Denied

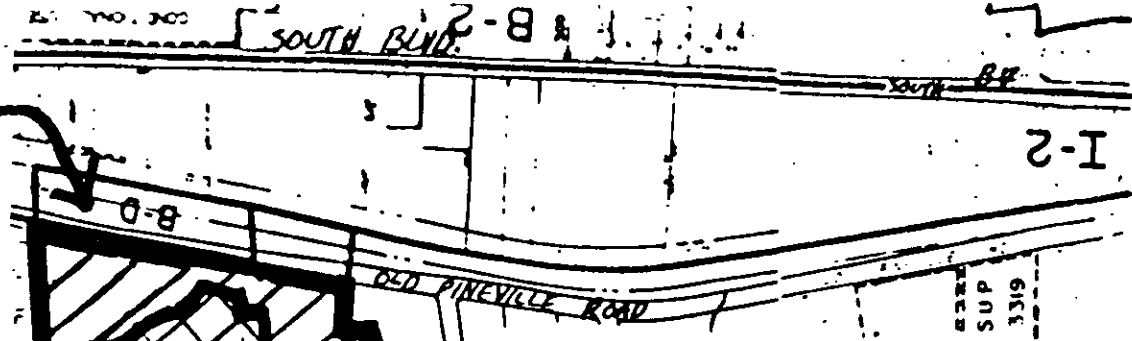

0-1 to R-4 =


Denied

Denied

REZONE 0-1 TO R-1 MF

Approved R-4

APPROVED BY CITY COUNCIL DATE Approved as indicated 6/15/92 Denied in Red

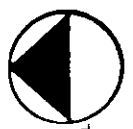

CITY (CD) 2 ARCHDALE R

Revised 2/17/92 92-11


1. Zoning Commi Hec
recommends
denial of
petition on
Gibson Smith
property

4. Zoning Commi Hec
recommends approval
of R-17MF



3. Zoning Commi Hec
recommends approval
of R-17MF in lieu
of R-4 on the
Portrait Homes
property.

4. Zoning Commi Hec
recommends approval
of R-17MF

2. Zoning Commi
recommends denial
of petition on
Gellman property.

 O-1 to R-4 =

REZONE O-1
TO R-17MF

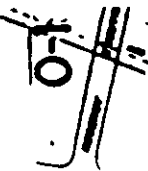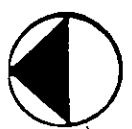

B-2000

B-1

B-1

O-1

O-1

O-1

O-8

OLD PINEVILLE ROAD

SUP 1319

I-2

CITY (CD)
ARCHDAL

Revised 2/17/92 92-

 0-15 to R-~~12~~MF property owners


 adjacent owners



PG. 19


PG. 15

BK. 167

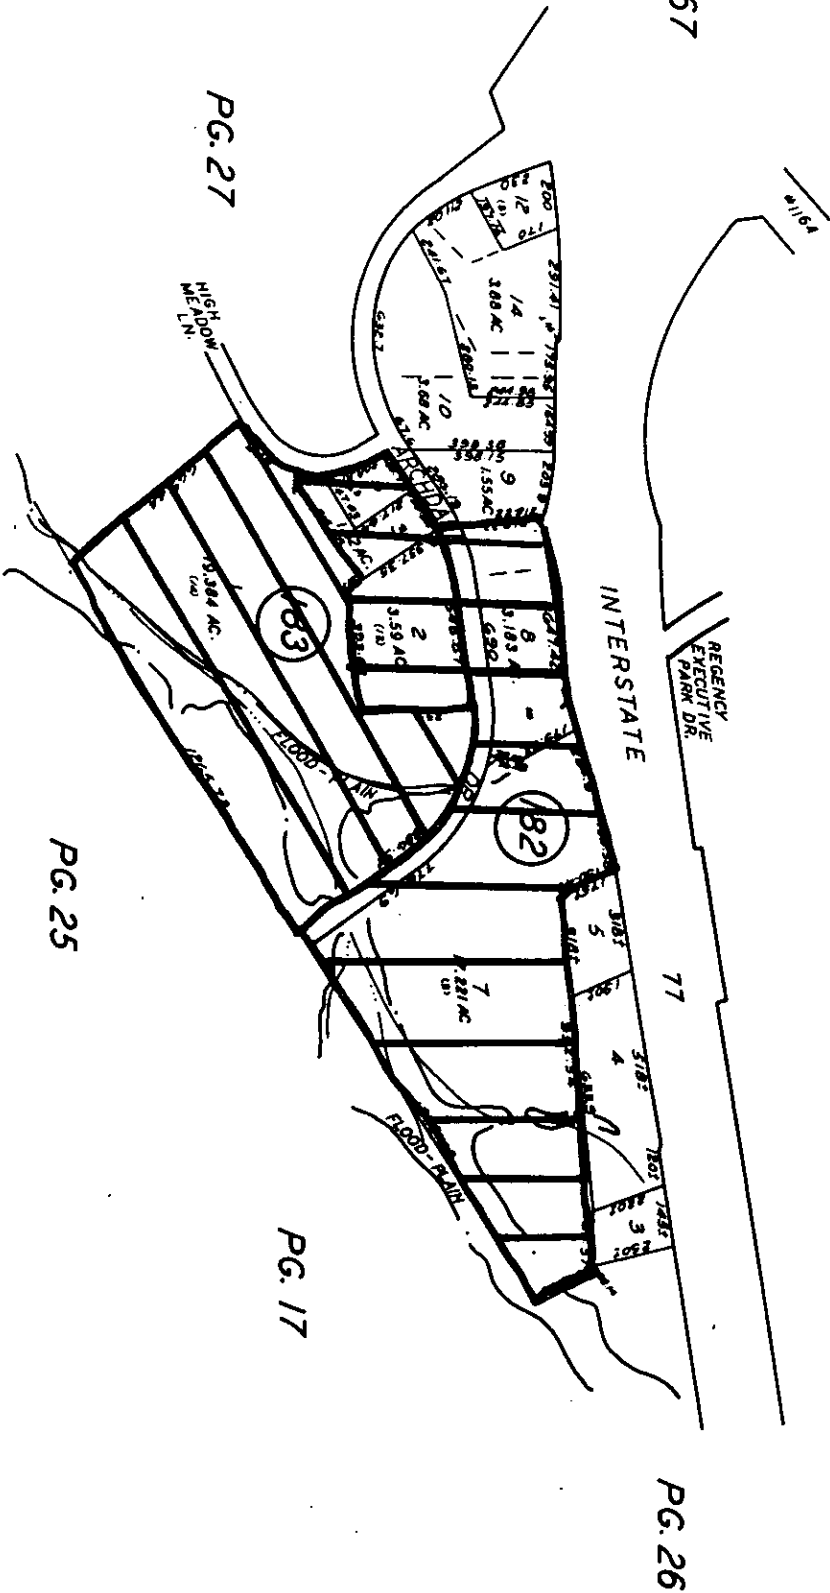

TAX LINE MAP	BOOK 169	PAGE 18
MECKLENBURG COUNTY, NORTH CAROLINA		
REVISED 5-14-90	SCALE	1" = 400'

JUN 1 1990

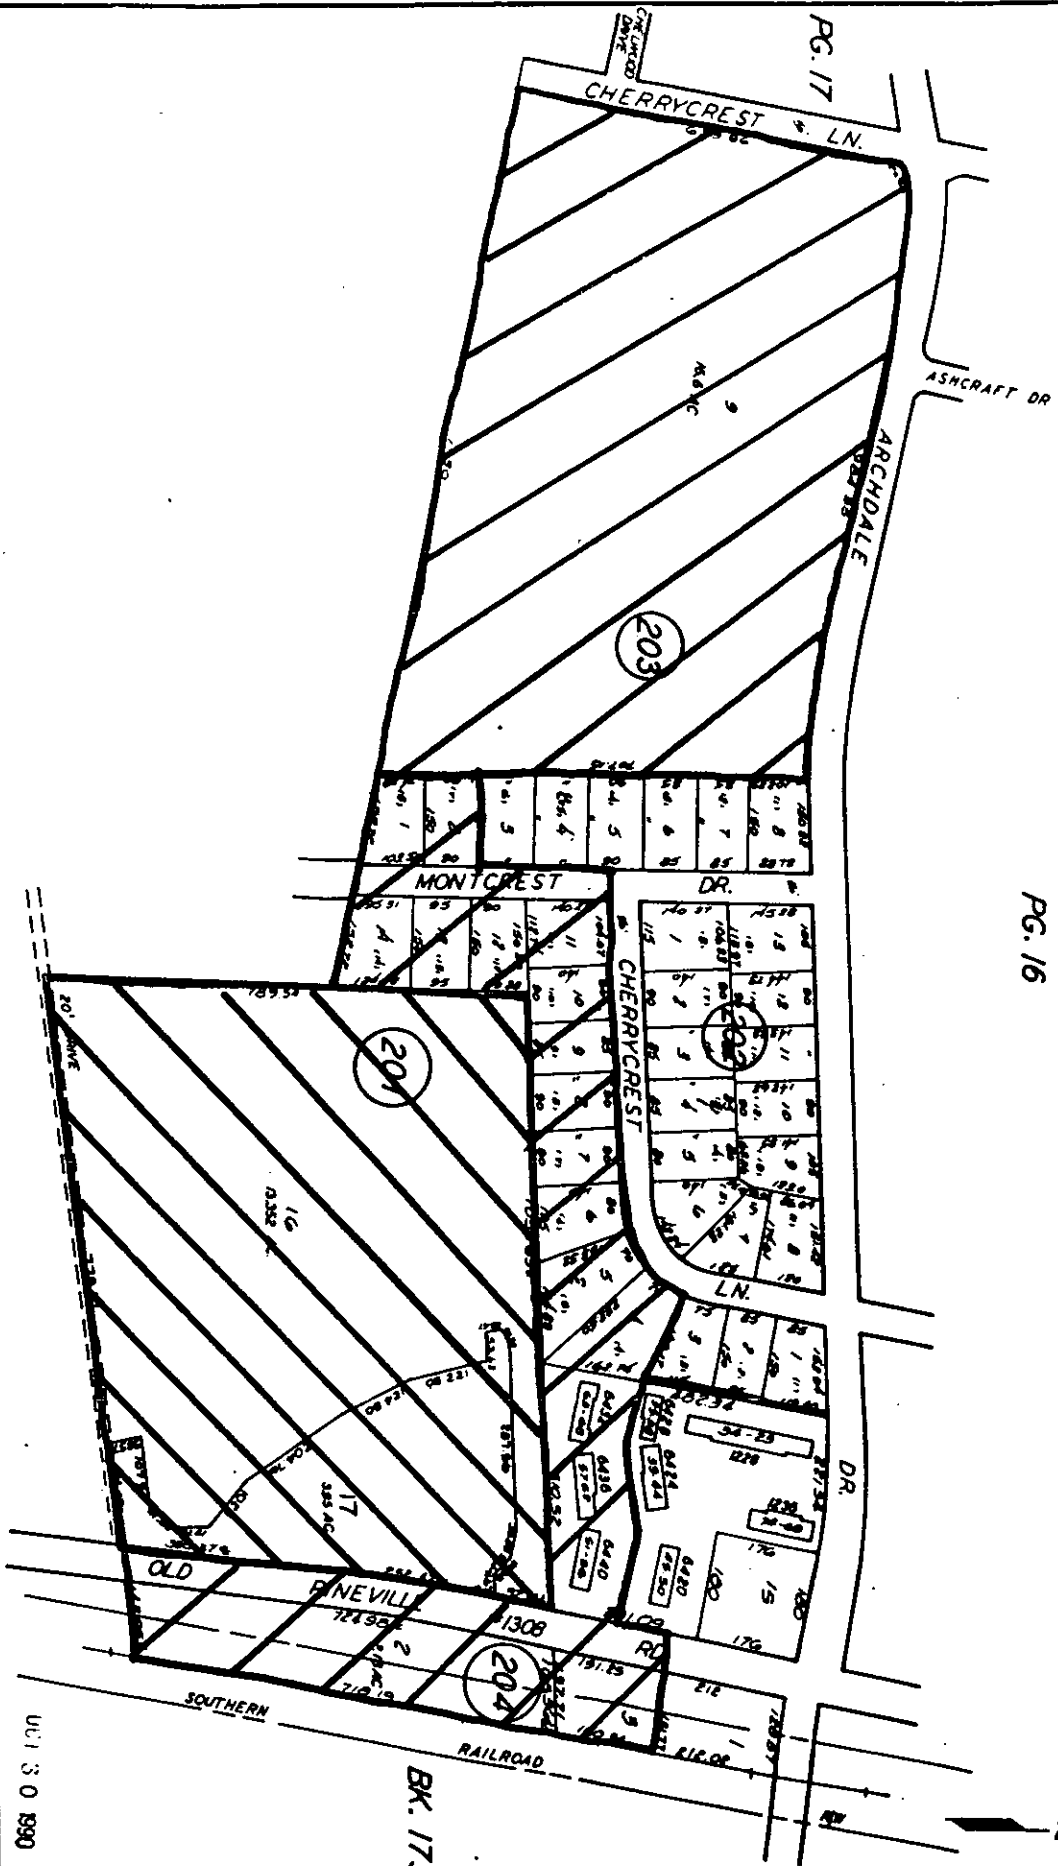



PG. 25

TAX LINE MAP BOOK 189 PAGE 20
 MECKLENBURG COUNTY, NORTH CAROLINA
 REVISED 9-26-90 SCALE 1" = 200'

U01 3 0 1990

BK. 173

 0-15 to R-~~12~~MF property owners
 adjacent owners

0-15 to R-~~MF~~MF property owners


adjacent owners

PG. 18

PG. 18

PG. 25

3K 167

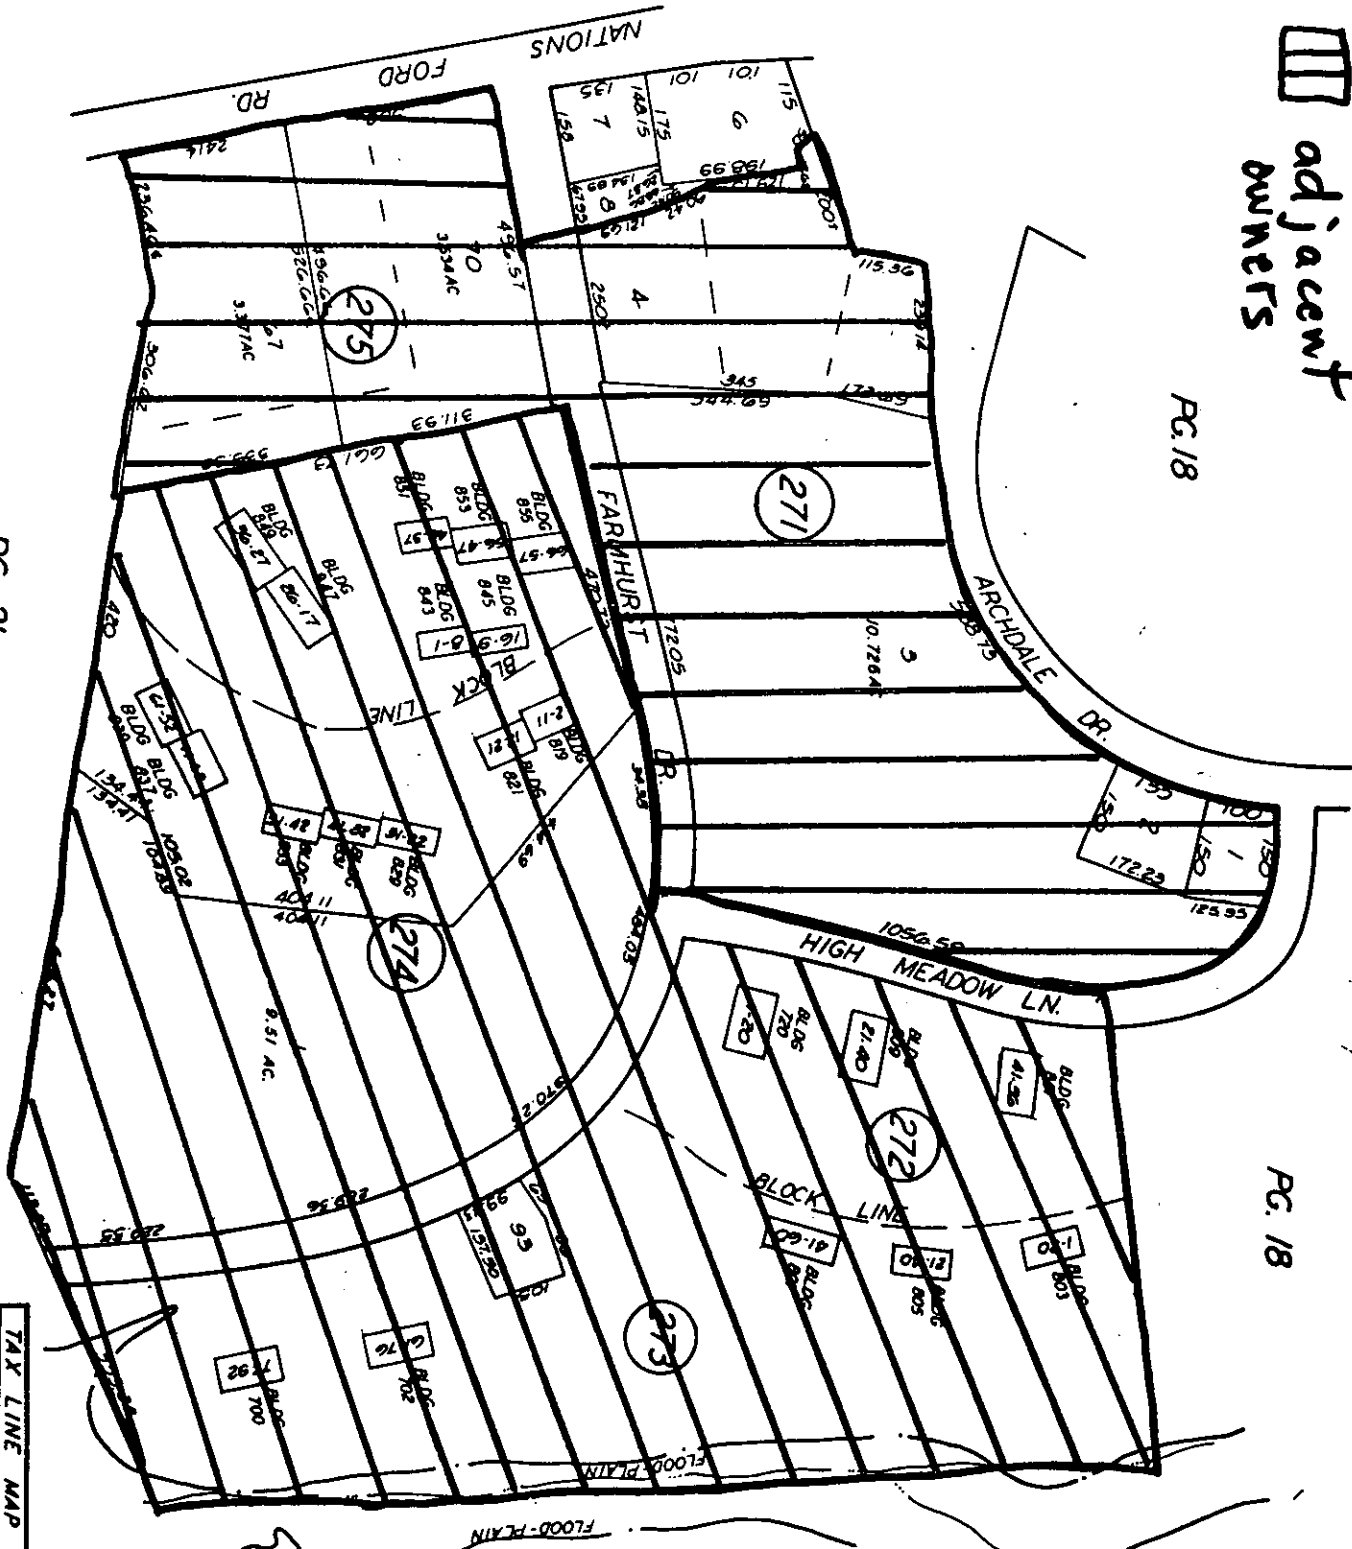

FOR TAX PURPOSES ONLY

PG. 21

TAX LINE MAP BOOK 169 PAGE 27
 MECKLENBURG COUNTY, NORTH CAROLINA
 REVISED 5-14-90 SCALE 1" = 200'

JUN 1 1990

169-27

O-15 to R-~~MF~~¹²MF  property owner

O-15 to R-~~M4~~⁴M4  property owner

 adjacent owner

PG. 18



PG. 17

PG. 20

PG. 27

PG. 21

PG. 22

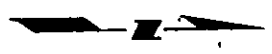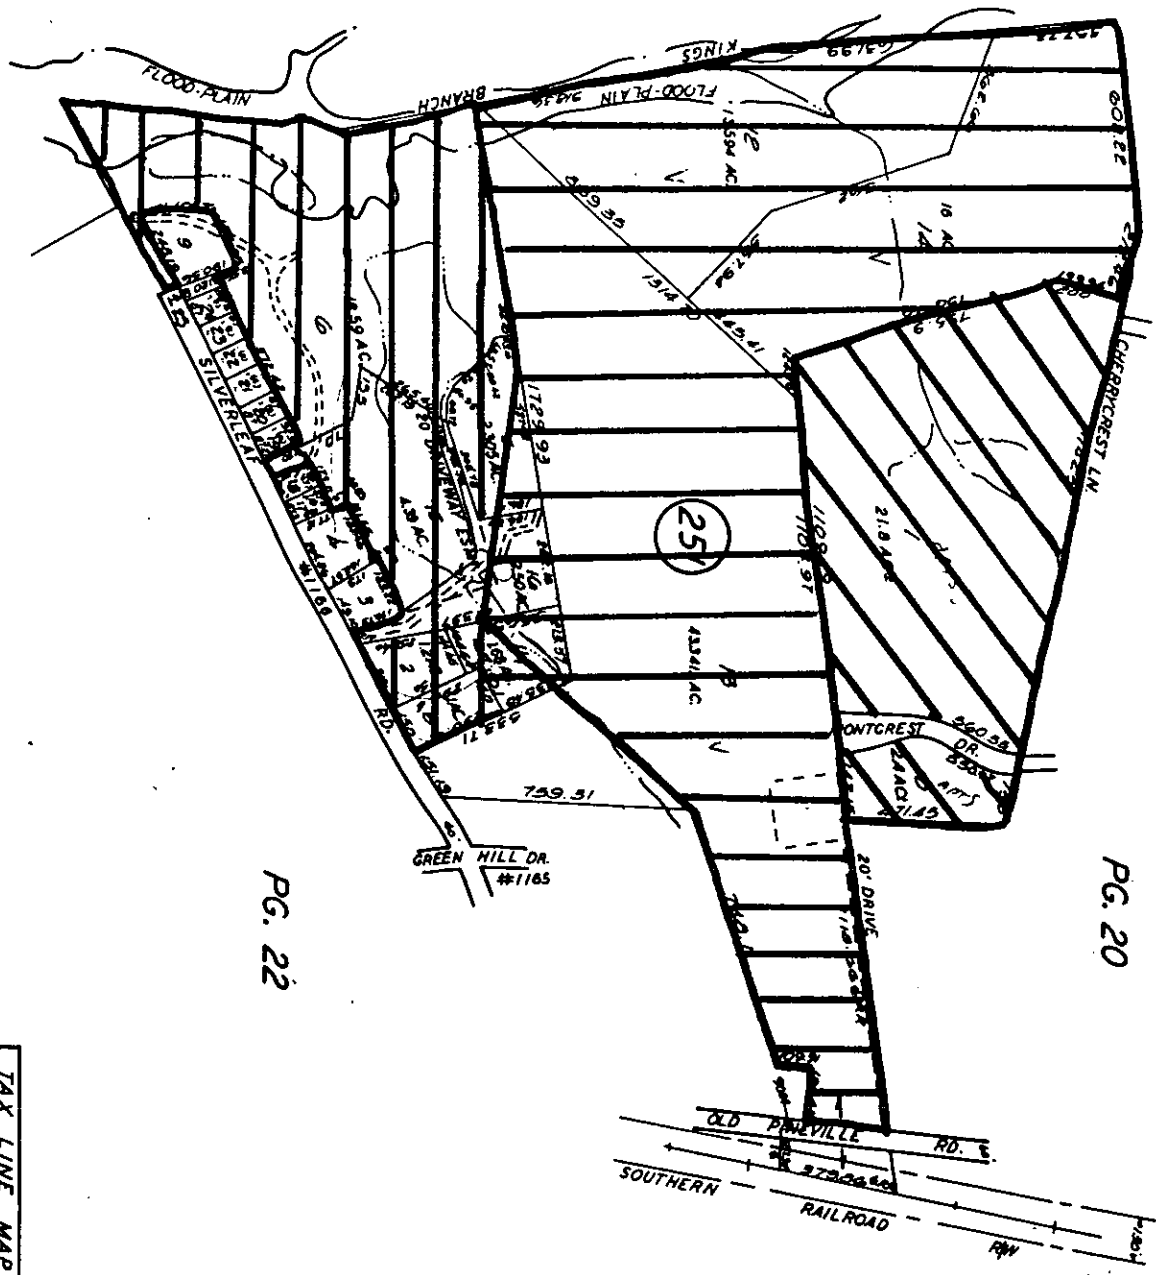

BK. 173

TAX LINE MAP	BOOK 169	PAGE 25
MECKLENBURG COUNTY, NORTH CAROLINA		
REVISED NOV 1	1989	SCALE 1" = 400'

FDP TAX DISTRICTS ONLY