
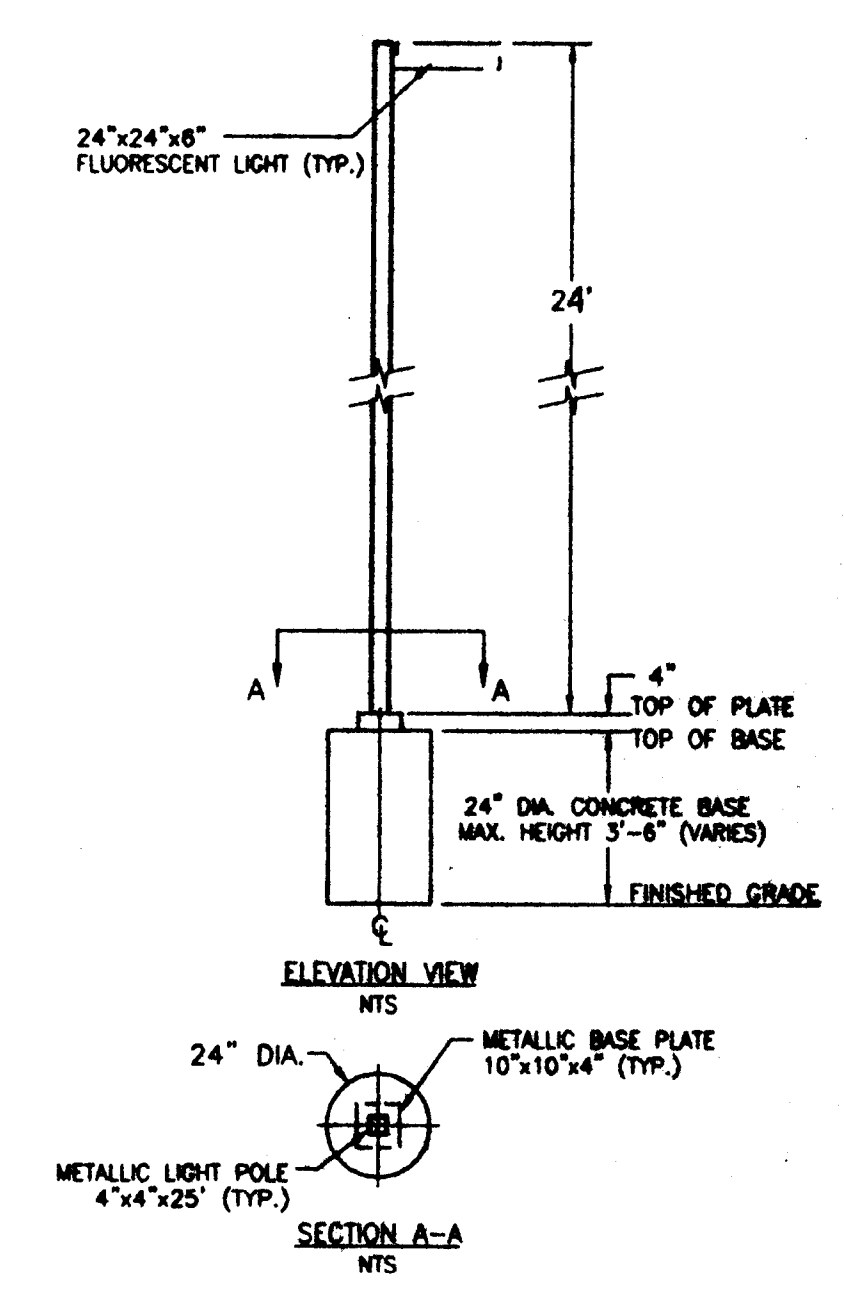
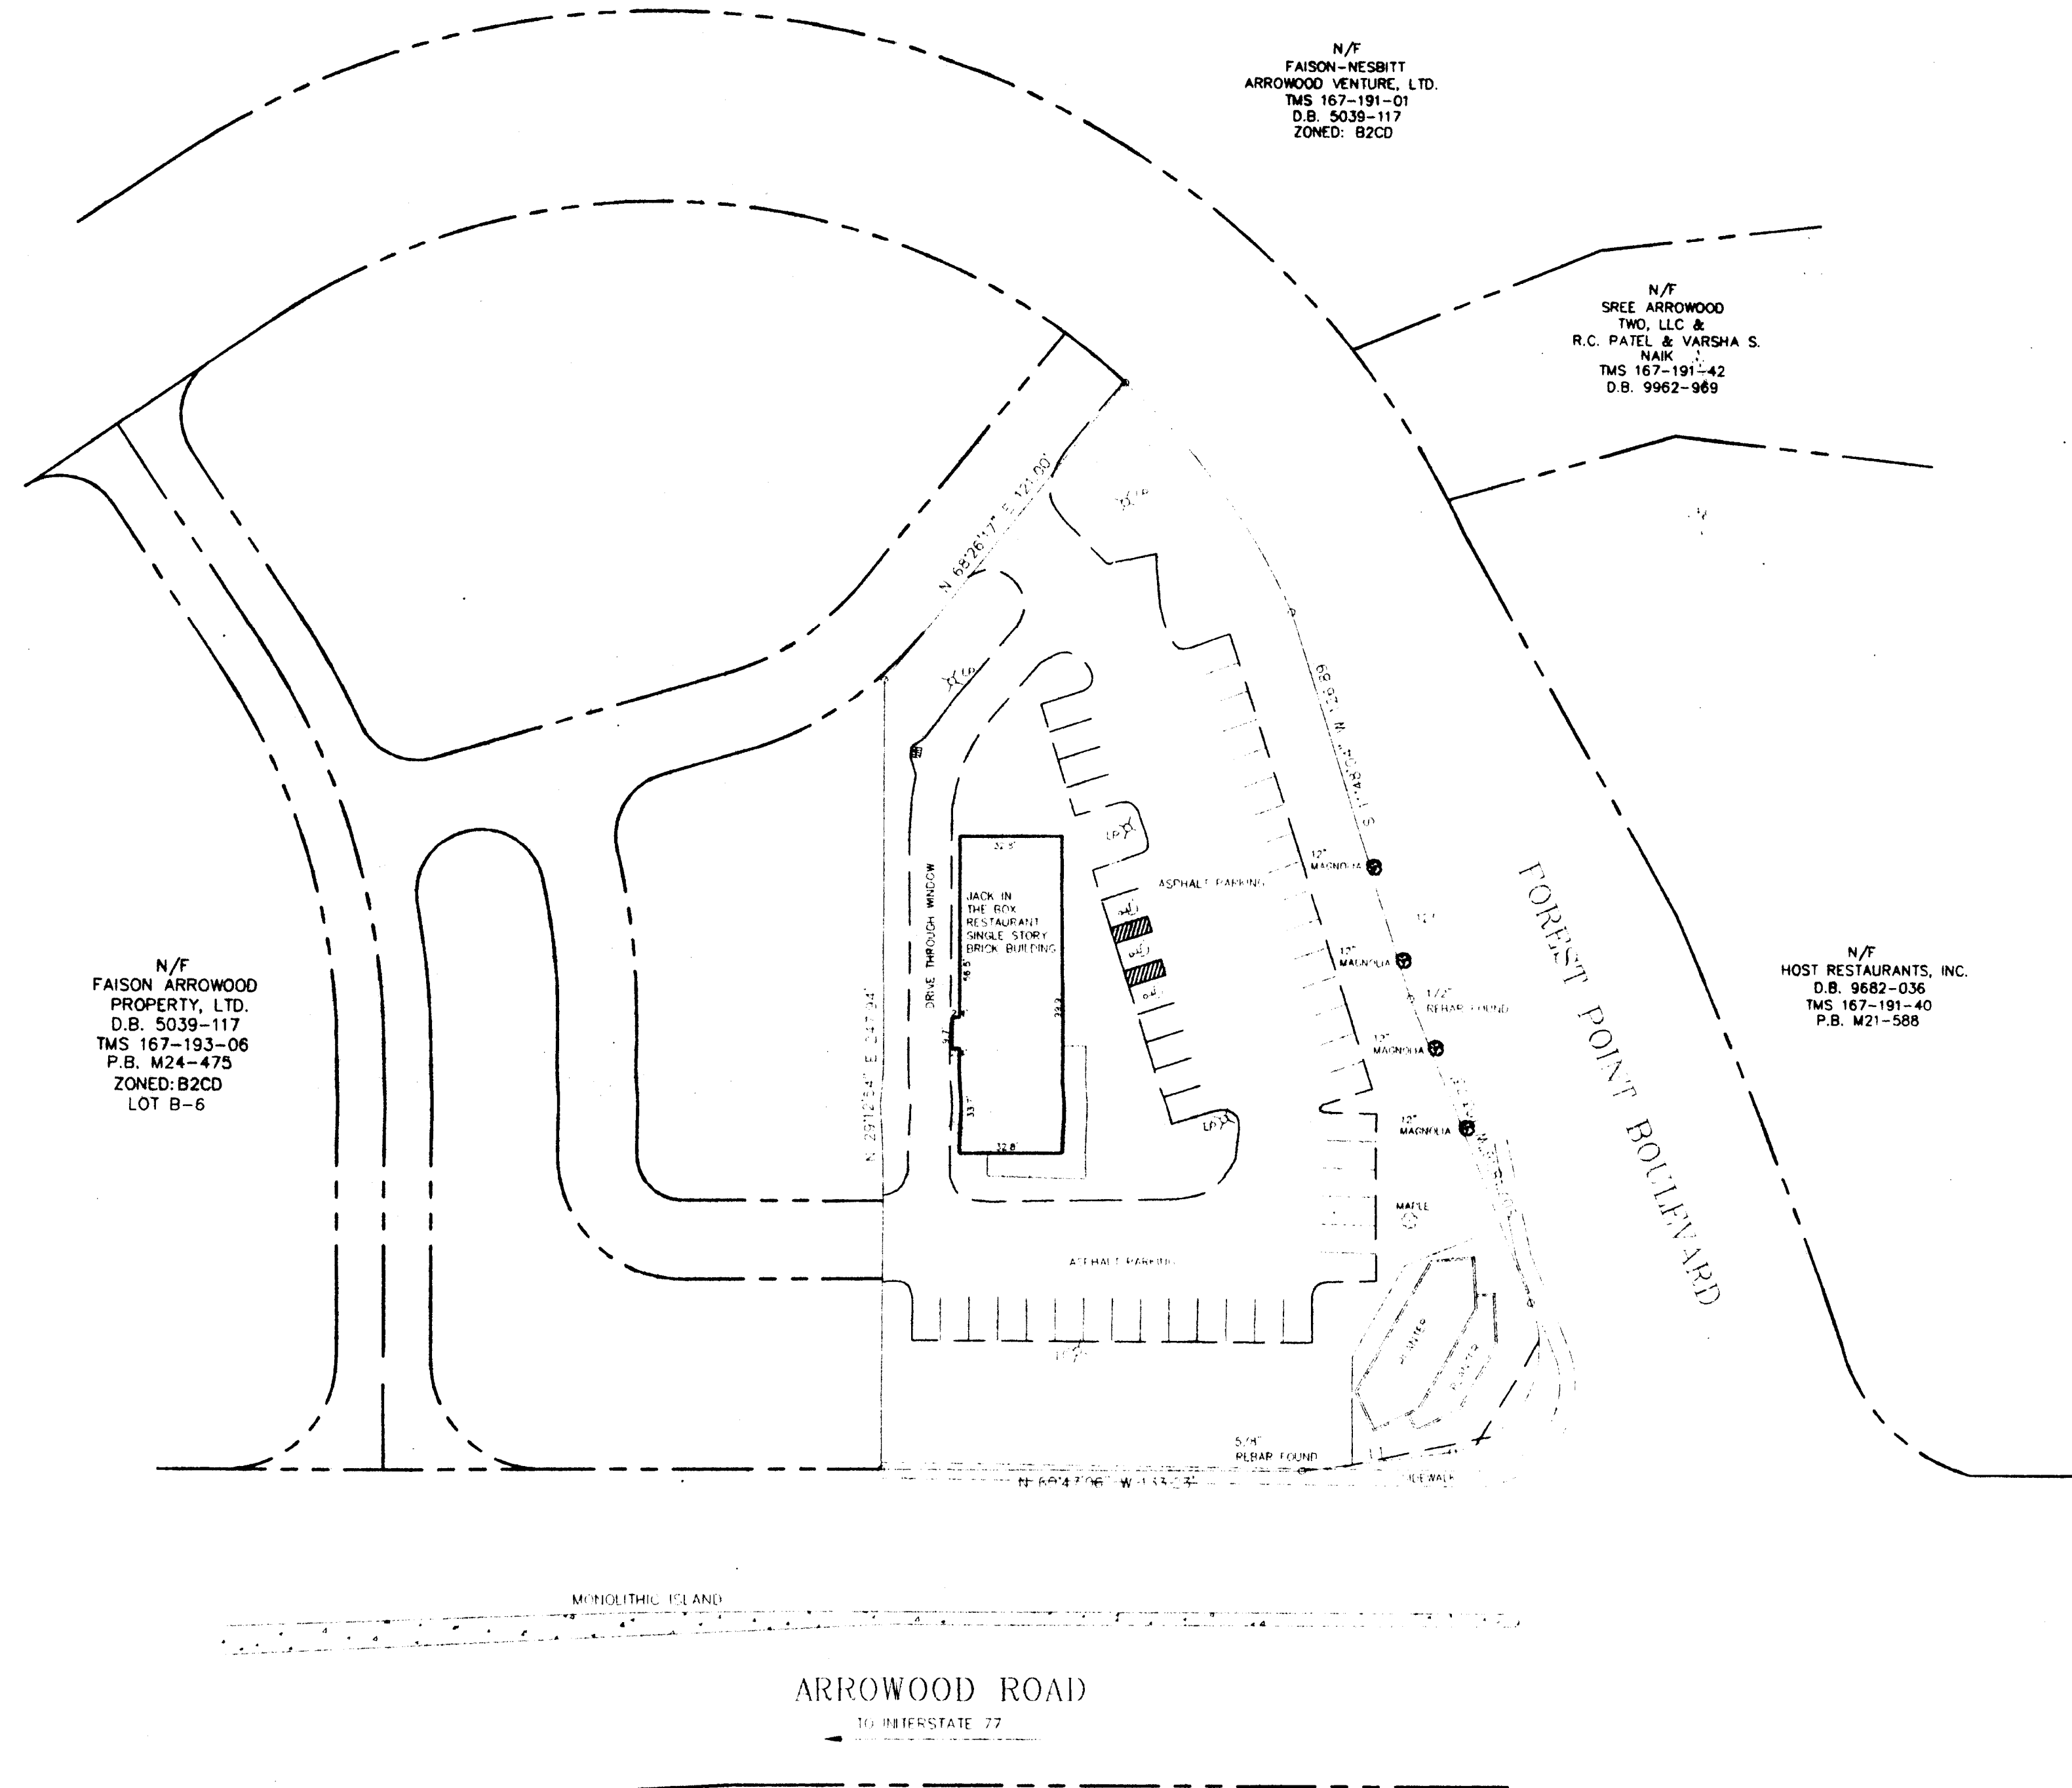



CURVE TABLE						
CURVE	LENGTH	RADIUS	DELTA	TANGENT	BEARING	CHORD LENGTH
C1	89.72	220.00	23°21'55"	43.49	N06°53'24"W	89.10
C2	60.17	33.98	101°26'59"	41.55	N57°17'08"E	32.61

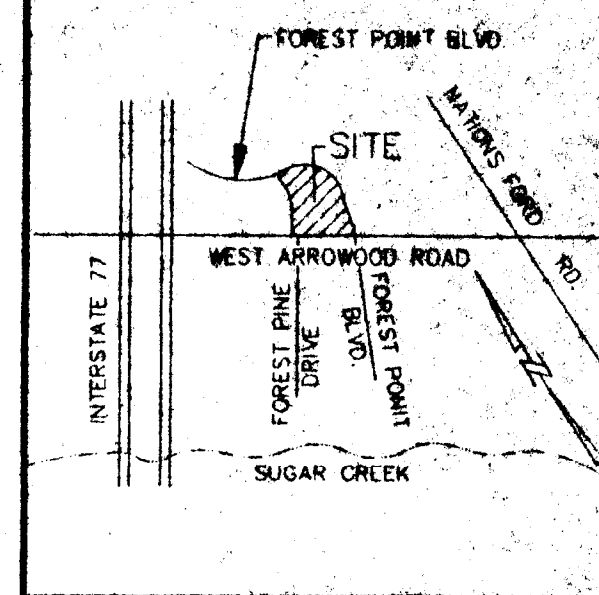

DESCRIPTION	NUMBER	DATE	BY
ADDED LIGHT POLE DETAIL	1	11/19/99	ROB

- NOTES**
- SURVEY MADE USING EXISTING PHYSICAL EVIDENCE OBSERVED ON DATE OF SURVEY.
 - THIS SURVEY WAS PREPARED WITHOUT THE BENEFIT OF A TITLE EXAMINATION BY AN ATTORNEY. PROPERTY MAY BE SUBJECT TO RECORDED OR UNRECORDED, RIGHTS-OF-WAY, EASEMENTS, OR CONDITIONS NOT OBSERVED OR SHOWN HEREON.
 - UTILITY LOCATIONS ARE APPROXIMATE, BASED ON LOCATION OF ABOVE GROUND APPURTENANCES, AS-BUILT MAPS BY OTHERS, AND LOCATIONS OF PAINT MARKINGS BY ULOCO. UNDERGROUND UTILITIES NOT SHOWN HEREON MAY EXIST.
 - NO BOUNDARY SURVEY WAS PERFORMED BY W.K. DICKSON & CO., INC.

ATTACHED TO ADMINISTRATIVE APPROVAL
 DATED: December 3, 1999
 BY: MARTIN R. CRAMTON, JR.

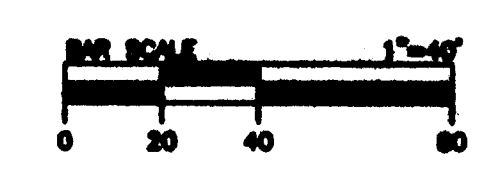

REV. NO.	DESCRIPTION	DATE
1	ADDED LIGHT POLE DETAIL	11/19/99

WK DICKSON
 Engineers Planners Surveyors
 Landscape Architects

616 COLONNADE DRIVE
 CHARLOTTE, NC
 (704) 334-5348

Raleigh, NC
 Atlanta, GA
 Winston, NC

Ashville, NC
 Columbia, SC
 Hickory, NC

PROJECT MANAGER: CJD
 DRAWING SCALE: 1"=40'
 DRAWN BY: ROB
 SURVEY DATE: 11/3/99
 CHECKED BY: CJD
 PLOT DATE: 11/5/99
 FILE NAME: 9902715-2.DWG

PREPARED FOR:
FOOD MAKER, INC.

SURVEY OF:
JACK-IN-THE-BOX RESTAURANT

LOCATED IN:
 MECKLENBURG COUNTY
 CHARLOTTE, NORTH CAROLINA

CHARLOTTE-MECKLENBURG PLANNING COMMISSION
 INTER-OFFICE COMMUNICATION

DATE: December 3, 1999

TO: Robert Brandon
 Zoning Administrator

FROM: Martin R. Cramton, Jr.
 Planning Director

SUBJECT: Administrative Approval for outparcel located on Petition No. 96-97, Faison Arrowood Property, Inc.

Attached is a specific plan for the Jack in the Box located on the above plan. This outparcel plan is being revised to allow an increase in the allowable height of lighting to 28 feet. This increased height only applies to this parcel. Since these lights are not located in an area adjoining residential uses and this change is minor, I am administratively approving this specific plan. Please use this revised plan when evaluating requests for building permits and certificates of occupancy.

96-97
 Faison

1/1A