


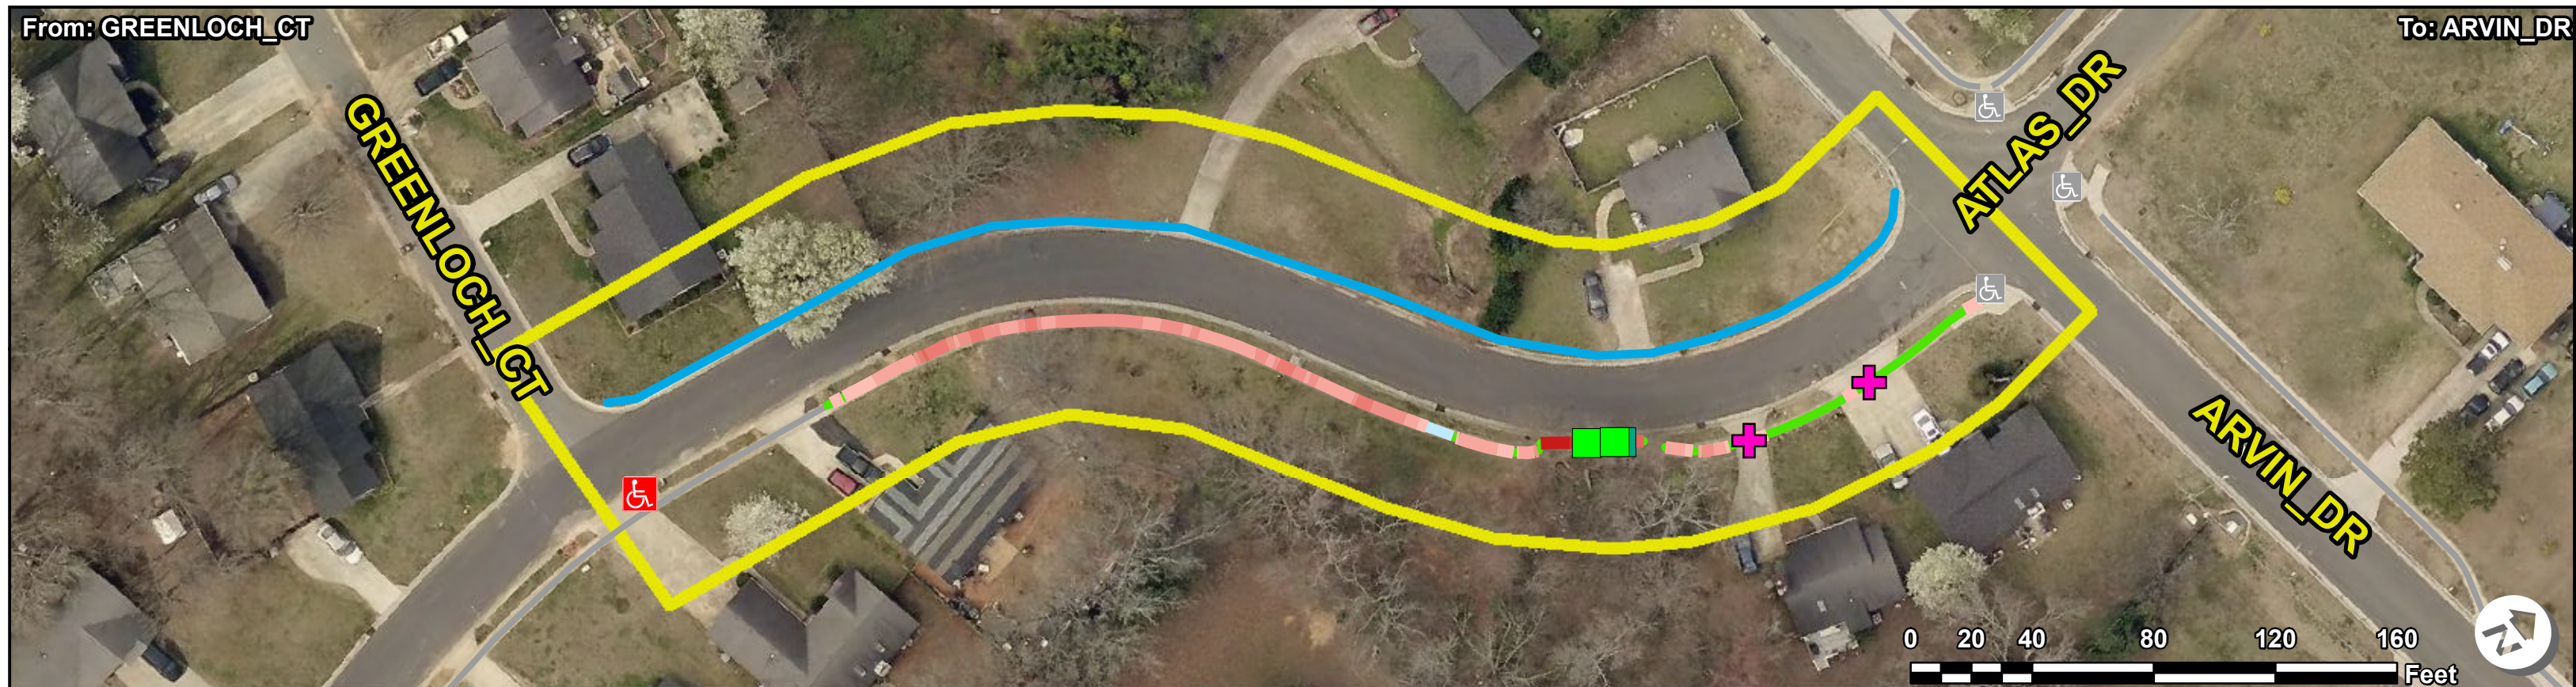

ADA Survey Summary		ADA Compliance Cost Estimate *			
Item Description	Quantity	Item Description	Quantity	Unit Price	Item Cost
1 Heavings less than 1"	7 EA	1 Heavings less than 1"	3 EA	\$ 100.00	\$ 300.00
2 Heavings 1" or greater	0 EA	2 Heavings 1" or greater	0 EA	\$ 400.00	\$ 0.00
3 Uneven Heavings	0 EA	3 Uneven Heavings	0 EA	\$ 400.00	\$ 0.00
4 Heaving Clusters	0 SY	4 Heaving Clusters	0 SY	\$ 75.00	\$ 0.00
5 Sidewalk Joint Gaps	0 EA	5 Sidewalk Joint Gaps	0 EA	\$ 200.00	\$ 0.00
6 Miscellaneous Obstruction	0 EA	6 Miscellaneous Obstruction	0 EA	\$ 1500.00	\$ 0.00
7 Missing Sidewalk Obstruction	0 EA	7 Missing Sidewalk Obstruction	0 EA	\$ 200.00	\$ 0.00
8 Other Obstruction	0 EA	8 Other Obstruction	0 EA	\$ 500.00	\$ 0.00
9 Pole Post Hydrant Obstruction	0 EA	9 Pole Post Hydrant Obstruction	0 EA	\$ 5000.00	\$ 0.00
10 Ponding Obstruction	0 EA	10 Ponding Obstruction	0 EA	\$ 400.00	\$ 0.00
11 Sidewalk Joint Obstruction	0 EA	11 Sidewalk Joint Obstruction	0 EA	\$ 100.00	\$ 0.00
12 Sign Obstruction	0 EA	12 Sign Obstruction	0 EA	\$ 150.00	\$ 0.00
13 Storm Grate Obstruction	0 EA	13 Storm Grate Obstruction	0 EA	\$700.00	\$ 0.00
14 Transit Obstruction	0 EA	14 Transit Obstruction	0 EA	\$500.00	\$ 0.00
15 Traffic Obstruction	0 EA	15 Traffic Obstruction	0 EA	\$2000.00	\$ 0.00
16 Tree Obstruction	0 EA	16 Tree Obstruction	0 EA	\$500.00	\$ 0.00
17 Utility Obstruction	0 EA	17 Utility Obstruction	0 EA	\$1500.00	\$ 0.00
18 Vegetation Obstruction - Low	2 EA	18 Vegetation Obstruction - Low	2 EA	\$150.00	\$ 300.00
19 Vegetation Obstruction - Overhead	1 EA	19 Vegetation Obstruction - Overhead	1 EA	\$150.00	\$ 150.00
20 Commercial Entrance	0 EA	20 Commercial Entrance (within slope violation)	0 EA	\$ 5000.00	\$ 0.00
21 Residential Entrance	2 EA	21 Residential Entrance (within slope violation)	2 EA	\$ 3000.00	\$ 6000.00
22 Total Sidewalk Length Assessed	398.418 LF	22 Running Slope Violations**	0 SY	\$ 75.00	\$ 0.00
23 Average Sidewalk Width	48 IN	23 Cross Slope Violations	64.759 SY	\$ 75.00	\$ 4857.00
24 No Sidewalk on Block (Approx.)	466.249 LF	24 Running and Cross Slope Violations	66.196 SY	\$ 75.00	\$ 4965.00
25 Missing Sidewalk Gaps (Approx.)	0 LF	25 Missing Sidewalk Gaps (Approx.)	0 LF	\$ 41.67	\$ 0.00
26 Poor Surface Condition (Approx.)	0 LF	26 Poor Surface Condition (Approx.)	0 LF	\$ 41.67	\$ 0.00
27 Buried Sidewalk (Approx.)	0 LF	27 Buried Sidewalk (Approx.)	0 LF	\$ 41.67	\$ 0.00
		Sidewalk SubTotal:			\$ 16572.00

Item Description	Total Count	Non Compliant Count	Cost
Curb Ramps	1	1	\$ 3200.00
Island Curb Cuts	0	0	\$ 0.00
Signal Push Buttons	0	0	\$ 0.00
Transit Stops	0	0	\$ 0.00
Railroad Crossings	0	0	\$ 0.00
Accessible Parking Spaces	0	0	\$ 0.00
Intersection SubTotal:			\$ 3200.00

Corridor Total: \$ 19772.00

 Curb Ramps - Compliant	 Curb Ramps - Adjacent
 Curb Ramps - Non Compliant	
 Island Curb Cuts - Compliant	 Island Curb Cuts - Adjacent
 Island Curb Cuts - Non Compliant	
 Signals - Compliant	 Signals - Adjacent
 Signals - Non Compliant	
 Transit Stops - Compliant	 Transit Stops - Adjacent
 Transit Stops - Non Compliant	
 Railroad Crossings - Compliant	 Railroad Crossings - Adjacent
 Railroad Crossings - Non Compliant	
 Accessible Parking - Compliant	 Accessible Parking - Adjacent
 Accessible Parking - Non Compliant	

Heavings

- Yellow circle: Heavings < 1" (Excluded)***
- Orange circle: Heavings ≥ 1" (Excluded)***
- Red circle: Uneven Heaving (Excluded)***
- Yellow line: Heaving Clusters (Excluded)
- Purple triangle: Sidewalk Joint Gap (Excluded)***
- Purple square: Miscellaneous Obstruction
- Pink square: Missing Sidewalk Obstruction
- Blue square: Other Obstruction
- Orange square: Pole Post Hydrant Obstruction
- Light blue square: Ponding Obstruction
- Yellow square: Sidewalk Joint Obstruction
- Gray square: Sign Obstruction
- Blue square: Storm Grate Obstruction
- Orange square: Transit Obstruction
- Black square: Traffic Obstruction
- Green square: Tree Obstruction
- Black square: Utility Obstruction
- Green square: Vegetation Obstruction - Low
- Teal square: Vegetation Obstruction - Overhead
- Green line: Sidewalk Collection Path
- Gray line: Adjacent Sidewalk Collection Path
- Orange line: Buried Sidewalk
- Brown line: Sidewalk Not Surveyed
- Pink line: Missing Sidewalk Gap
- Blue line: No Sidewalk on Block

Heavings

- Yellow circle: Heavings < 1"
- Orange circle: Heavings ≥ 1"
- Red circle: Uneven Heaving
- Yellow line: Heaving Clusters
- Purple triangle: Sidewalk Joint Gap
- Purple diamond: Commercial Entrance
- Purple diamond: Residential Entrance
- Purple plus: Commercial Entrance (within slope violation)
- Purple plus: Residential Entrance (within slope violation)

Cross Slope

- Light red line: 2 - 3%
- Red line: 7.01 - 8%
- Light red line: 3.01 - 4%
- Red line: 8.01 - 9%
- Light red line: 4.01 - 5%
- Red line: 9.01 - 10%
- Light red line: 5.01% - 6%
- Red line: 10.01 - 12%
- Light red line: 6.01 - 7%
- Red line: > 12%

Running Slope

- Light blue line: 5 - 8.33%
- Blue line: 8.34% - 10%
- Blue line: 10.01 - 12.5%
- Blue line: > 12.5%

*Note: ADA pedestrian issues have been identified and quantified in the ADA Survey Summary. There are instances where multiple issues can be resolved with a single corrective measure. The ADA Compliance Cost Estimate reflects the best estimation of quantities and cost to resolve all identified ADA issues.

**Note: Additional investigation may be warranted when sidewalk running slope issues exist within the right-of-way.

***Note: Excluded items are violations that occur in areas with slope violations and have been excluded from the cost estimate.