


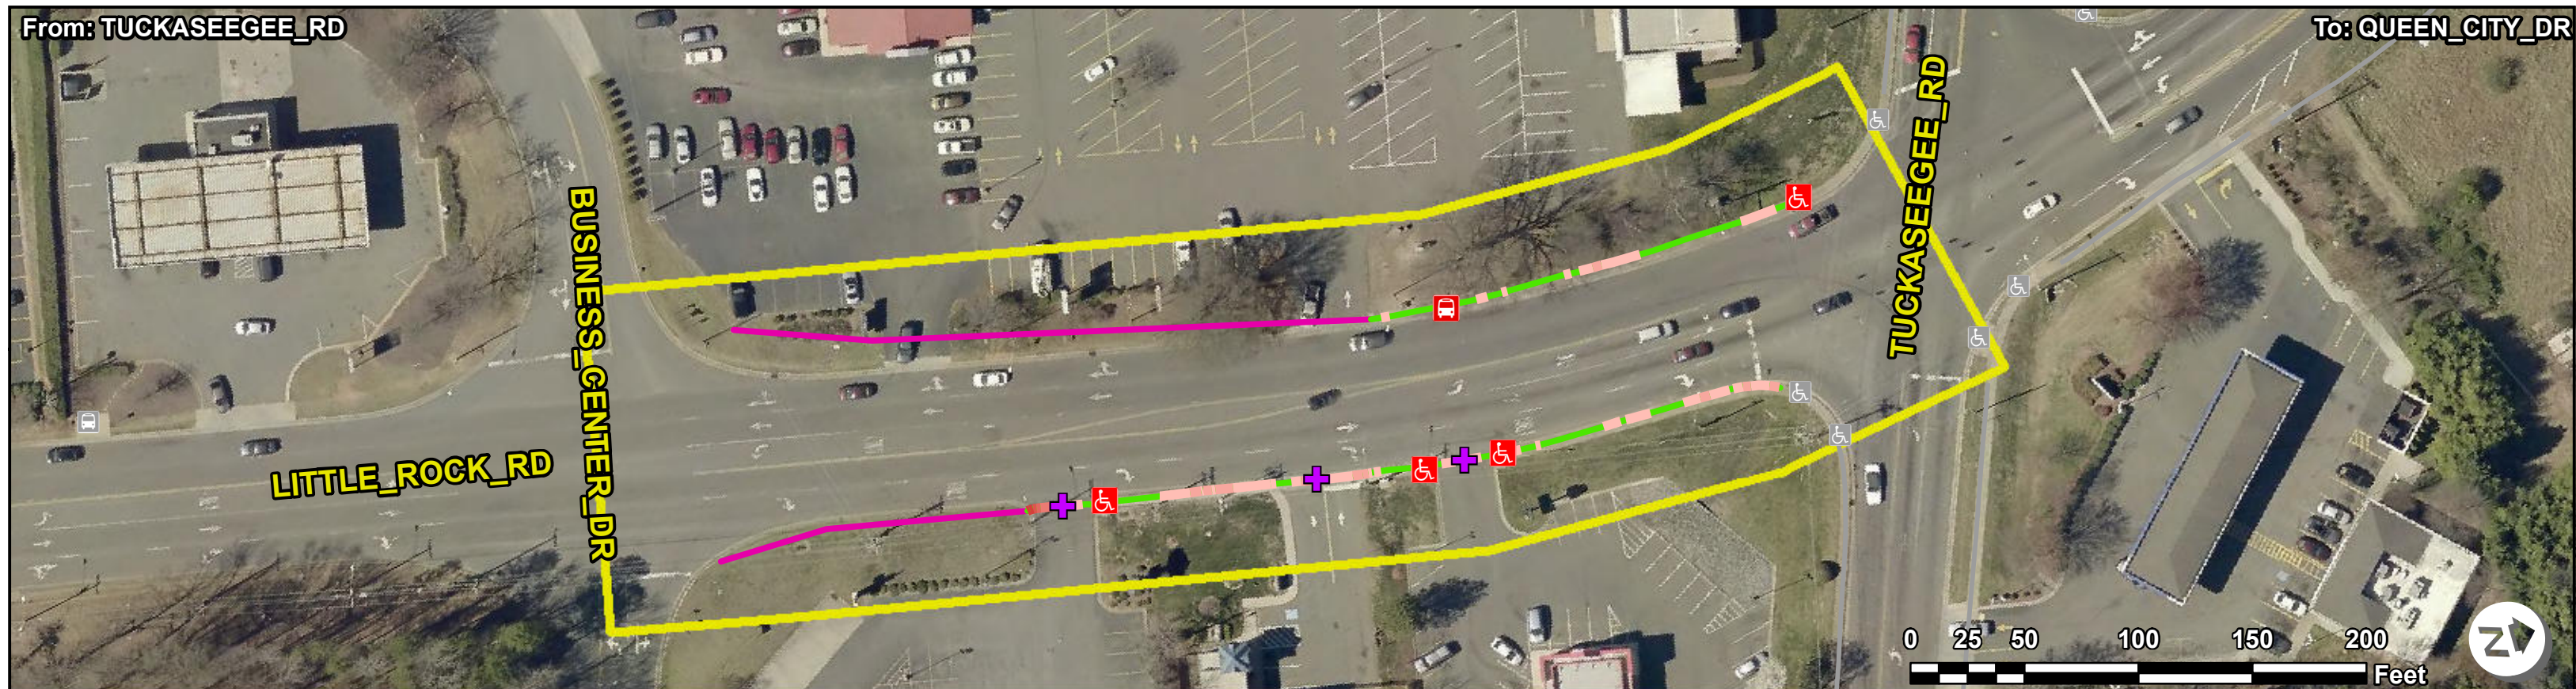

ADA Survey Summary			ADA Compliance Cost Estimate *				
Item Description		Quantity	Item Description		Quantity	Unit Price	Item Cost
1	Heavings less than 1"	9 EA	1	Heavings less than 1"	4 EA	\$ 100.00	\$ 400.00
2	Heavings 1" or greater	1 EA	2	Heavings 1" or greater	1 EA	\$ 400.00	\$ 400.00
3	Uneven Heavings	0 EA	3	Uneven Heavings	0 EA	\$ 400.00	\$ 0.00
4	Heaving Clusters	1.776 SY	4	Heaving Clusters	0 SY	\$ 75.00	\$ 0.00
5	Sidewalk Joint Gaps	0 EA	5	Sidewalk Joint Gaps	0 EA	\$ 200.00	\$ 0.00
6	Miscellaneous Obstruction	0 EA	6	Miscellaneous Obstruction	0 EA	\$ 1500.00	\$ 0.00
7	Missing Sidewalk Obstruction	0 EA	7	Missing Sidewalk Obstruction	0 EA	\$ 200.00	\$ 0.00
8	Other Obstruction	0 EA	8	Other Obstruction	0 EA	\$ 500.00	\$ 0.00
9	Pole Post Hydrant Obstruction	0 EA	9	Pole Post Hydrant Obstruction	0 EA	\$ 5000.00	\$ 0.00
10	Ponding Obstruction	0 EA	10	Ponding Obstruction	0 EA	\$ 400.00	\$ 0.00
11	Sidewalk Joint Obstruction	0 EA	11	Sidewalk Joint Obstruction	0 EA	\$ 100.00	\$ 0.00
12	Sign Obstruction	0 EA	12	Sign Obstruction	0 EA	\$ 150.00	\$ 0.00
13	Storm Grate Obstruction	0 EA	13	Storm Grate Obstruction	0 EA	\$700.00	\$ 0.00
14	Transit Obstruction	0 EA	14	Transit Obstruction	0 EA	\$500.00	\$ 0.00
15	Traffic Obstruction	0 EA	15	Traffic Obstruction	0 EA	\$2000.00	\$ 0.00
16	Tree Obstruction	0 EA	16	Tree Obstruction	0 EA	\$500.00	\$ 0.00
17	Utility Obstruction	0 EA	17	Utility Obstruction	0 EA	\$1500.00	\$ 0.00
18	Vegetation Obstruction - Low	0 EA	18	Vegetation Obstruction - Low	0 EA	\$150.00	\$ 0.00
19	Vegetation Obstruction - Overhead	0 EA	19	Vegetation Obstruction - Overhead	0 EA	\$150.00	\$ 0.00
20	Commercial Entrance	3 EA	20	Commercial Entrance (within slope violation)	3 EA	\$ 5000.00	\$ 15000.00
21	Residential Entrance	0 EA	21	Residential Entrance (within slope violation)	0 EA	\$ 3000.00	\$ 0.00
22	Total Sidewalk Length Assessed	524.823 LF	22	Running Slope Violations**	0 SY	\$ 75.00	\$ 0.00
23	Average Sidewalk Width	48 IN	23	Cross Slope Violations	84.417 SY	\$ 75.00	\$ 6331.00
24	No Sidewalk on Block (Approx.)	0 LF	24	Running and Cross Slope Violations	0 SY	\$ 75.00	\$ 0.00
25	Missing Sidewalk Gaps (Approx.)	416.655 LF	25	Missing Sidewalk Gaps (Approx.)	416.655 LF	\$ 41.67	\$ 17380.00
26	Poor Surface Condition (Approx.)	0 LF	26	Poor Surface Condition (Approx.)	0 LF	\$ 41.67	\$ 0.00
27	Buried Sidewalk (Approx.)	0 LF	27	Buried Sidewalk (Approx.)	0 LF	\$ 41.67	\$ 0.00
			Sidewalk SubTotal:				\$ 22131.00

Intersection Inventory & Compliance Cost Estimate			
Item Description	Total Count	Non Compliant Count	Cost
Curb Ramps	4	4	\$ 6200.00
Island Curb Cuts	0	0	\$ 0.00
Signal Push Buttons	0	0	\$ 0.00
Transit Stops	1	1	\$ 3900.00
Railroad Crossings	0	0	\$ 0.00
Accessible Parking Spaces	0	0	\$ 0.00
Intersection SubTotal:			\$ 10100.00
Corridor Total:		\$	49611.00

Curb Ramps - Compliant	Curb Ramps - Adjacent
Curb Ramps - Non Compliant	
Island Curb Cuts - Compliant	Island Curb Cuts - Adjacent
Island Curb Cuts - Non Compliant	
Signals - Compliant	Signals - Adjacent
Signals - Non Compliant	
Transit Stops - Compliant	Transit Stops - Adjacent
Transit Stops - Non Compliant	
Railroad Crossings - Compliant	Railroad Crossings - Adjacent
Railroad Crossings - Non Compliant	
Accessible Parking - Compliant	Accessible Parking - Adjacent
Accessible Parking - Non Compliant	

*Note: ADA pedestrian issues corrective measure. The ADA

**Note: Additional investigation

The legend is organized into two main columns. The left column lists various obstruction types, each preceded by a colored dot or line segment. The right column lists slope categories, each preceded by a colored line segment. The legend is divided into sections by bold text: 'Cross Slope' and 'Running Slope'.

Obstruction Type	Slope Category
Heavings < 1" (Excluded)***	2 - 3%
Heavings ≥ 1" (Excluded)***	3.01 - 4%
Uneven Heaving (Excluded)***	4.01 - 5%
Heaving Clusters (Excluded)	5.01% - 6%
Sidewalk Joint Gap (Excluded)***	6.01 - 7%
Miscellaneous Obstruction	7.01 - 8%
Missing Sidewalk Obstruction	8.01 - 9%
Other Obstruction	9.01 - 10%
Pole Post Hydrant Obstruction	10.01 - 12%
Ponding Obstruction	> 12%
Sidewalk Joint Obstruction	
Sign Obstruction	
Storm Grate Obstruction	
Transit Obstruction	
Traffic Obstruction	
Tree Obstruction	
Utility Obstruction	
Vegetation Obstruction - Low	
Vegetation Obstruction - Overhead	
Sidewalk Collection Path	
Adjacent Sidewalk Collection Path	
Buried Sidewalk	
Sidewalk Not Surveyed	
Missing Sidewalk Gap	
No Sidewalk on Block	

Cross Slope

- 2 - 3%
- 3.01 - 4%
- 4.01 - 5%
- 5.01% - 6%
- 6.01 - 7%
- 7.01 - 8%
- 8.01 - 9%
- 9.01 - 10%
- 10.01 - 12%
- > 12%

Running Slope

- 5 - 8.33%
- 8.34% - 10%
- 10.01 - 12.5%
- > 12.5%

***Note: Excluded items are violations that occur in areas with slope violations and have been excluded from the cost estimate.