


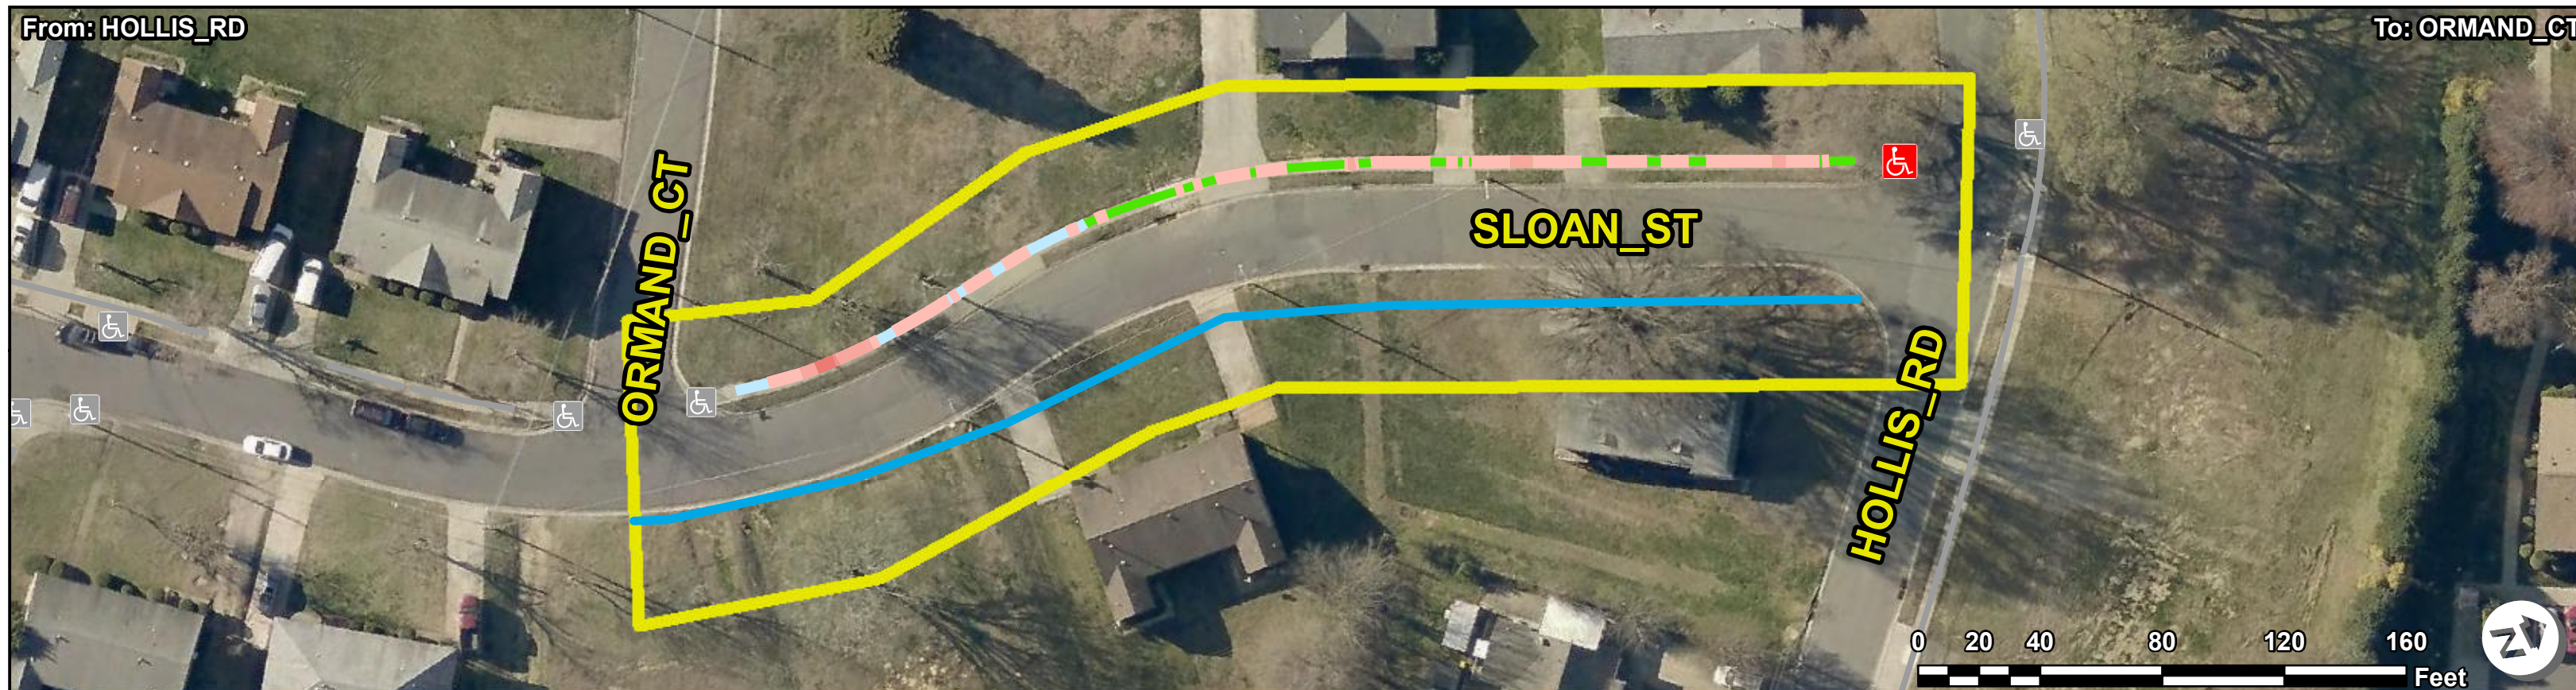

Intersection Inventory & Compliance Cost Estimate

Item Description	Total Count	Non Compliant Count	Cost
Curb Ramps	1	1	\$ 1600.00
Island Curb Cuts	0	0	\$ 0.00
Signal Push Buttons	0	0	\$ 0.00
Transit Stops	0	0	\$ 0.00
Railroad Crossings	0	0	\$ 0.00
Accessible Parking Spaces	0	0	\$ 0.00
Intersection SubTotal:			\$ 1600.00

Corridor Total:	\$ 12129.00
------------------------	--------------------

 Curb Ramps - Compliant	 Curb Ramps - Adjacent
 Curb Ramps - Non Compliant	
 Island Curb Cuts - Compliant	 Island Curb Cuts - Adjacent
 Island Curb Cuts - Non Compliant	
 Signals - Compliant	 Signals - Adjacent
 Signals - Non Compliant	
 Transit Stops - Compliant	 Transit Stops - Adjacent
 Transit Stops - Non Compliant	
 Railroad Crossings - Compliant	 Railroad Crossings - Adjacent
 Railroad Crossings - Non Compliant	
 Accessible Parking - Compliant	 Accessible Parking - Adjacent
 Accessible Parking - Non Compliant	

*Note: ADA pedestrian issues corrective measure. The ADA

**Note: Additional investigation

The legend is organized into two main columns. The left column lists various obstruction types, each preceded by a colored dot or line segment. The right column lists slope categories, each preceded by a colored line segment. The legend is divided into two sections: 'Cross Slope' and 'Running Slope'.

Obstruction Type	Color	Slope Category	Color
Heavings < 1" (Excluded)***	Yellow dot	Heavings < 1"	Yellow dot
Heavings ≥ 1" (Excluded)***	Orange dot	Heavings ≥ 1"	Orange dot
Uneven Heaving (Excluded)***	Red dot	Uneven Heaving	Red dot
Heaving Clusters (Excluded)	Yellow line	Heaving Clusters	Yellow line
Sidewalk Joint Gap (Excluded)***	Purple triangle	Sidewalk Joint Gap	Purple triangle
Miscellaneous Obstruction	Purple diamond	Commercial Entrance	Purple diamond
Missing Sidewalk Obstruction	Pink square	Residential Entrance	Pink diamond
Other Obstruction	Blue square	Commercial Entrance (within slope violation)	Purple plus
Pole Post Hydrant Obstruction	Orange square	Residential Entrance (within slope violation)	Pink plus
Ponding Obstruction	Light blue square		
Sidewalk Joint Obstruction	Yellow square	Cross Slope	
Sign Obstruction	Gray square	2 - 3%	Red line
Storm Grate Obstruction	Blue square	3.01 - 4%	Red line
Transit Obstruction	Orange square	4.01 - 5%	Red line
Traffic Obstruction	Black square	5.01% - 6%	Red line
Tree Obstruction	Green square	6.01 - 7%	Red line
Utility Obstruction	Black square	7.01 - 8%	Red line
Vegetation Obstruction - Low	Green square	8.01 - 9%	Red line
Vegetation Obstruction - Overhead	Teal square	9.01 - 10%	Red line
Sidewalk Collection Path	Green line	10.01 - 12%	Red line
Adjacent Sidewalk Collection Path	Gray line	> 12%	Red line
Buried Sidewalk	Orange line		
Sidewalk Not Surveyed	Brown line	Running Slope	
Missing Sidewalk Gap	Pink line	5 - 8.33%	Light blue line
No Sidewalk on Block	Blue line	8.34% - 10%	Light blue line
		10.01 - 12.5%	Blue line
		> 12.5%	Dark blue line

*Note: ADA pedestrian issues have been identified and quantified in the ADA Survey Summary. There are instances where multiple issues can be resolved with a single corrective measure. The ADA Compliance Cost Estimate reflects the best estimation of quantities and cost to resolve all identified ADA issues.

**Note: Additional investigation may be warranted when sidewalk running slope issues exist within the right-of-way.

***Note: Excluded items are violations that occur in areas with slope violations and have been excluded from the cost estimate.