
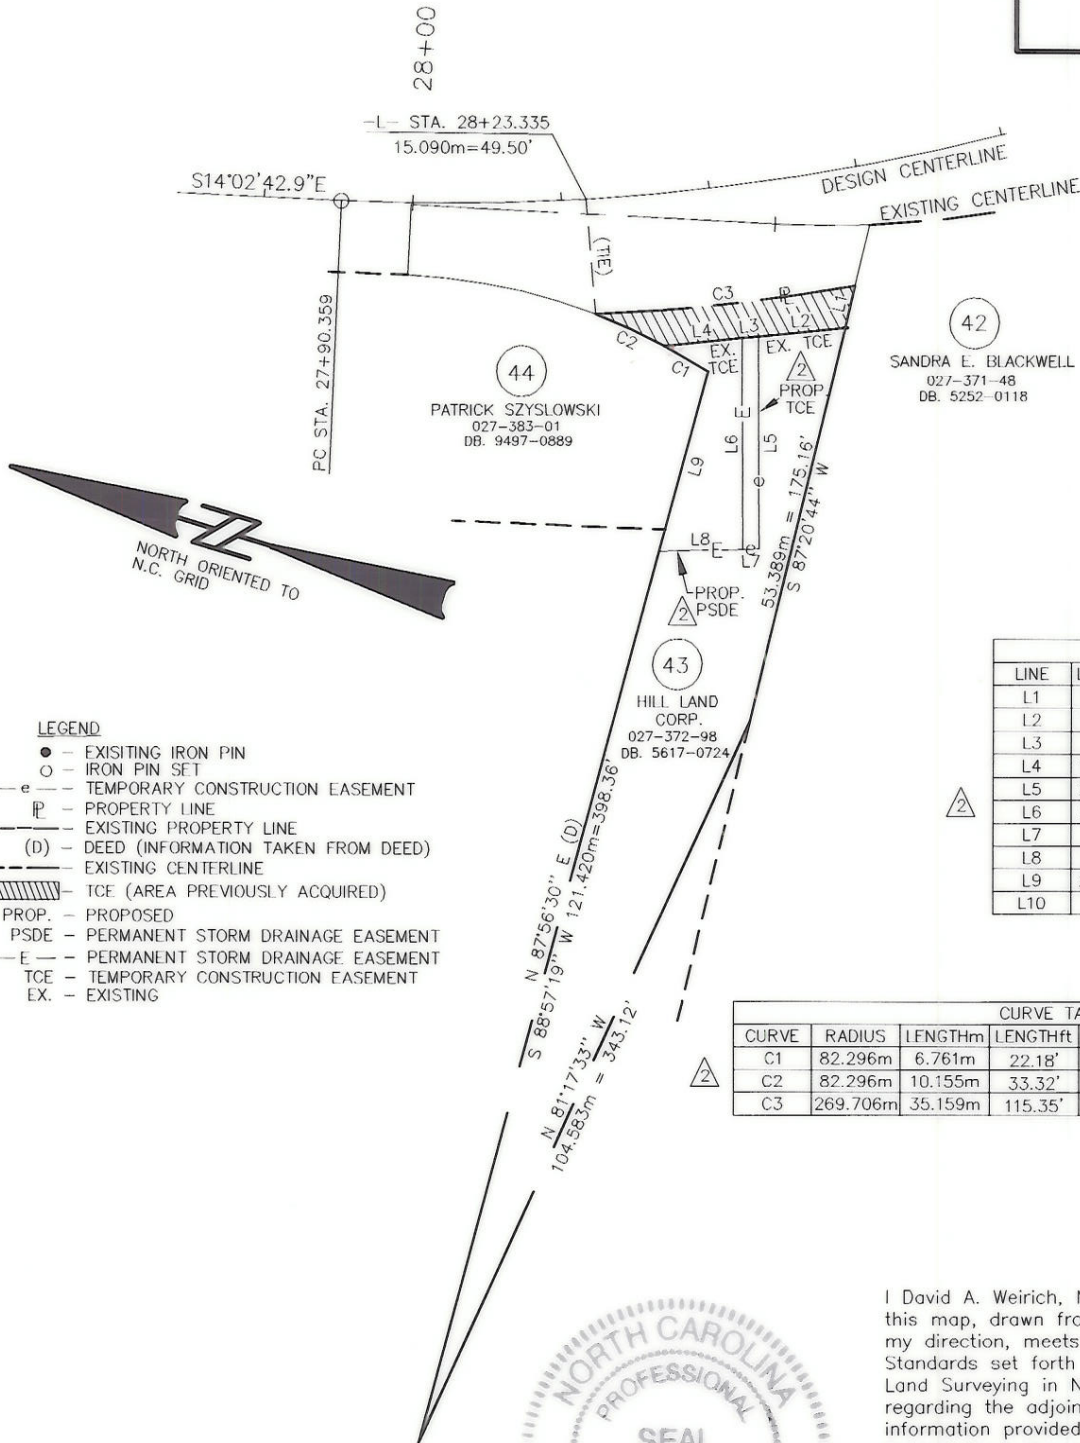


PARCEL NO.	43
TOTAL AREA	1,921.401 sq. m. = 20,681.77 sq. ft.
TCE (AREA PREVIOUSLY ACQUIRED)	140.289 sq. m. = 1,510.06 sq. ft.
REMAINING AREA	1,781.112 sq. m. = 19,171.71 sq. ft.
PROPOSED TEMPORARY CONSTRUCTION EASEMENT	61.384 sq. m. = 660.73 sq. ft.
PROPOSED PERMANENT STORM DRAINAGE EASEMENT	215.849 sq. m. = 2,323.38 sq. ft.

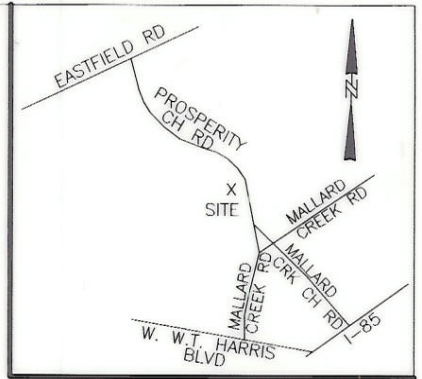


- LEGEND**
- - EXISTING IRON PIN
 - - IRON PIN SET
 - e- - TEMPORARY CONSTRUCTION EASEMENT
 - Ⓟ - PROPERTY LINE
 - - - - EXISTING PROPERTY LINE
 - (D) - DEED (INFORMATION TAKEN FROM DEED)
 - - - - EXISTING CENTERLINE
 - ▨ - TCE (AREA PREVIOUSLY ACQUIRED)
 - PROP. - PROPOSED
 - PSDE - PERMANENT STORM DRAINAGE EASEMENT
 - E- - PERMANENT STORM DRAINAGE EASEMENT
 - TCE - TEMPORARY CONSTRUCTION EASEMENT
 - EX. - EXISTING

LINE TABLE			
LINE	LENGTHm	LENGTHft	BEARING
L1	5.692m	5.69'	S87°20'44"W
L2	11.709m	38.41'	N22°07'00"W
L3	2.210m	7.25'	N22°07'00"W
L4	10.479m	34.38'	N22°07'00"W
L5	27.994m	91.84'	S73°18'28"W
L6	27.813m	91.25'	S73°18'27"W
L7	2.200m	7.22'	N17°24'34"W
L8	11.214m	36.79'	N17°47'53"W
L9	24.583m	80.65'	N88°57'19"E
L10	9.212m	30.22'	N76°19'26"E

CURVE TABLE						
CURVE	RADIUS	LENGTHm	LENGTHft	CHORD	CHORD	BEARING
C1	82.296m	6.761m	22.18'	6.759m	22.18'	N13°12'41"E
C2	82.296m	10.155m	33.32'	10.148m	33.29'	N07°19'23"E
C3	269.706m	35.159m	115.35'	35.134m	115.27'	S22°44'03"E

I David A. Weirich, N. C. P. L. S. certify that this map, drawn from an actual field survey under my direction, meets and/or exceeds the Minimum Standards set forth in the manual of Practice for Land Surveying in North Carolina. Title References regarding the adjoining properties are subject to information provided by local County Government. Subject tract title research for retracement of Boundary Lines only, and not intended to certify title.

David A. Weirich
David A. Weirich
L-3846

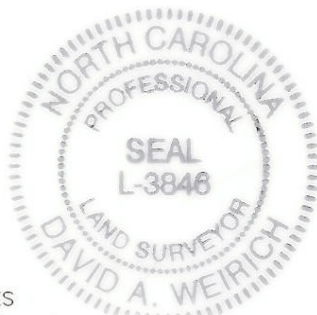

NOTE:
PROPERTY CORNERS SHOWN AS SOLID CIRCLES WERE LOCATED BY ACTUAL SURVEY. BEARINGS AND DISTANCES SHOWN IN PARENTHESIS ARE BASED ON DEED OR PLAT INFORMATION.

THIS MAP WAS PREPARED FOR THE PURPOSE OF PROPERTY ACQUISITION ONLY, AND IS NOT INTENDED TO BE A BOUNDARY SURVEY OF THE PROPERTY SHOWN.

GRAPHIC SCALE

(IN METERS)



**ACQUISITION BY CITY
RECORDED IN DEED BOOK**

1 : 1000

DATE _____



ESP ASSOCIATES, P.A.
engineeringsurveyingoplanning

10915 Southern Loop Boulevard
Pineville, N.C. (704) 583-4949

NO	DATE	BY	REVISIONS
2	01/03	WF	REVISE TABLES, CHANGE PSDE & TCE TO PROPOSED
1	10/02	WF	REVISE NEW R/W, TCE & TABLES

CHARLOTTE ENGINEERING DEPARTMENT

512-97-143 JOB NO. FILE NO. _____

PLAN SCALE 1:1000

PROFILE Hor Vert 1:100

PROSPERITY CHURCH RD.

REVISED PLAN FOR PARCEL 43
HILL LAND CORP.
027-372-98

AS BUILT	DATE	BT	RLM	SHEET	OF
ESP	WCF				
SURVEYED BY PREPARED BY		CHECKED BY	APPROVED BY	DATE	