



PARCEL NO.	152
TOTAL AREA (BY DEED)	1138.009 sq. m. = 12249.42 sq. ft.
AREA WITHIN R/W TO BE ACQUIRED	
AREA OUTSIDE R/W TO BE ACQUIRED	123.967 sq. m. = 1334.37 sq. ft.
REMAINING AREA	1014.04 sq. m. = 10915.05 sq. ft.
TEMPORARY CONSTRUCTION EASEMENT	38.293 sq. m. = 412.18 sq. ft.

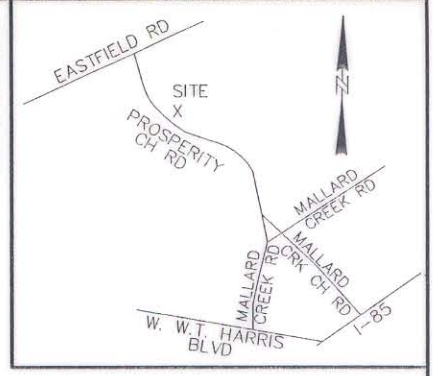


23+00

PROSPERITY CHURCH ROAD
18.288m (60') PUBLIC R/W

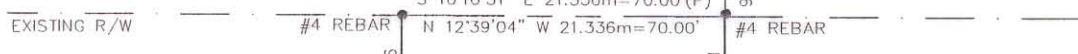

LINE TABLE			
LINE	LENGTHm	LENGTHft	BEARING
L1	5.805m	19.04'	S77°20'56\"W
L2	2.918m	9.57'	S77°20'56\"W
L3	6.585m	21.60'	N00°24'24\"E
L4	14.927m	48.97'	N14°14'44\"W
L5	1.835m	6.02'	S77°20'56\"W
L6	5.816m	19.08'	S77°20'56\"W
L7	21.336m	70.00'	S12°40'45\"E

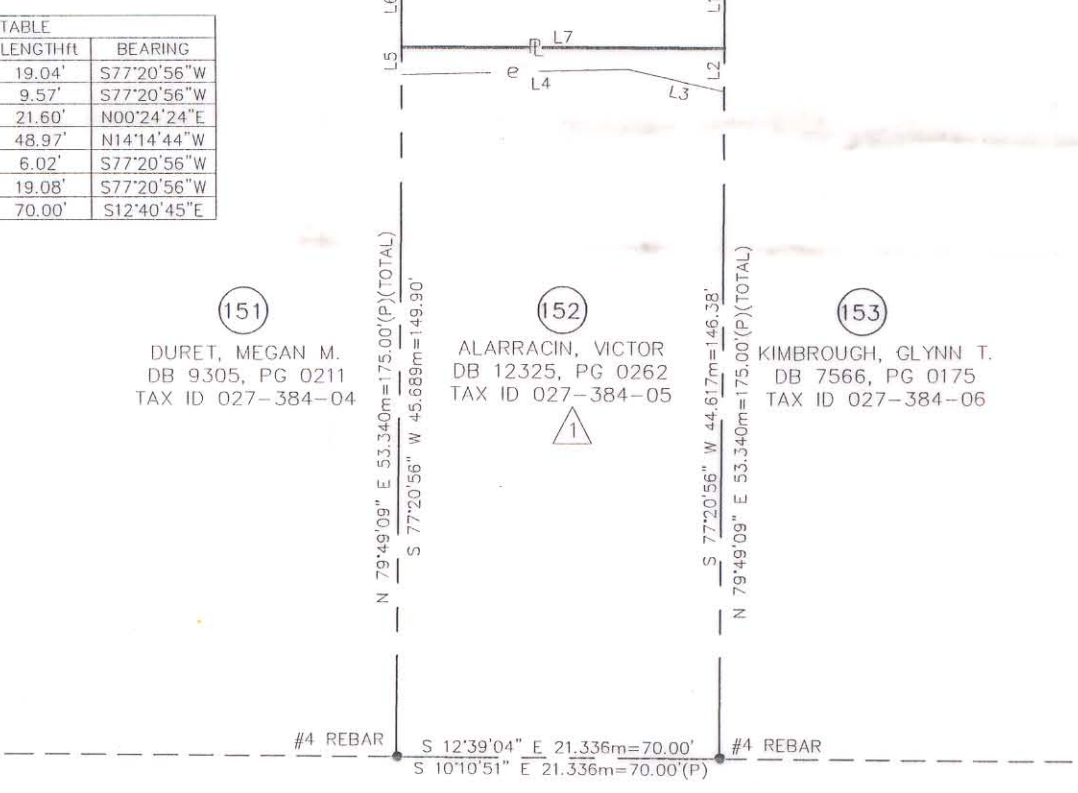

ACQUISITION BY CITY
RECORDED IN DEED BOOK
DB 15165 Pg 423
DATE

NOTE:
PROPERTY CORNERS SHOWN AS SOLID CIRCLES WERE LOCATED BY ACTUAL SURVEY. BEARINGS AND DISTANCES SHOWN IN PARENTHESIS ARE BASED ON DEED OR PLAT INFORMATION.

THIS MAP WAS PREPARED FOR THE PURPOSE OF PROPERTY ACQUISITION ONLY, AND IS NOT INTENDED TO BE A BOUNDARY SURVEY OF THE PROPERTY SHOWN.




I David A. Weirich, N. C. P. L. S. certify that this map, drawn from an actual field survey under my direction, meets and/or exceeds the Minimum Standards set forth in the manual of Practice for Land Surveying in North Carolina. Title References regarding the adjoining properties are subject to information provided by local County Government. Subject tract title research for retracement of Boundary Lines only, and not intended to certify title.

David A. Weirich
David A. Weirich
L-3846

GRAPHIC SCALE

(IN METERS)

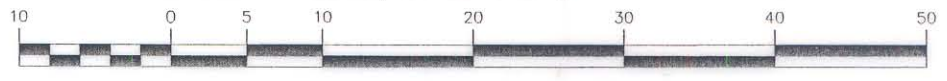

1 : 500

LEGEND

- - EXISTING IRON PIN
- - IRON PIN SET
- P — PROPERTY LINE (SURVEYED)
- - - EXISTING PROPERTY LINE
- (D) - DEED (INFORMATION TAKEN FROM DEED)
- - - EXISTING R/W LINE (PROSPERITY CHURCH RD)
- (P) - PLAT (INFORMATION TAKEN FROM PLAT)
- COS - COMMON OPEN SPACE
- e - TEMPORARY CONSTRUCTION EASEMENT
- - - ADJOINING PROPERTY LINE



ESP ASSOCIATES, P.A.
engineering • surveying • planning

10915 Southern Loop Boulevard
Pineville, N.C. (704) 583-4949

1	7/01	WC	REVISED PROPERTY OWNER NAME
NO	DATE	BY	REVISIONS

		CHARLOTTE ENGINEERING DEPARTMENT	
000-00-000 JOB NO	FILE NO	PROSPERITY CHURCH RD.	
PLAN SCALE	1:500	REVISED PLAN FOR PARCEL 152	
PROFILE Hor Vert	1:100	VICTOR & NUVIA ALARRACIN 027-384-05	
AS BUILT	DATE	JKL	ACJ
ESP	BS	JKL	ACJ
SURVEYED BY	PREPARED BY	CHECKED BY	APPROVED BY
			DATE