

CARMEL INVESTMENT GROUP

DEED BOOK 5074 PAGE 462

TAX CODE 205-~~181~~-~~14~~
RIGHT-OF-WAY TO BE ACQUIRED
3465 SQ. FT. OR 0.080 ACRES

ROSA S. NASH

DEED BOOK 1565 PAGE 497


TAX CODE 205-~~181~~-~~09~~

LINE	BEARING	DISTANCE
L1	N 25°14'33" E	45.00
L2	S 25°14'33" W	45.00
L3	S 25°14'33" W	42.00
L4	N 64°45'27" W	20.47
L5	N 64°45'27" W	18.29



THIS MAP WAS PREPARED FOR THE PURPOSE OF RIGHT-OF-WAY OR EASEMENT ACQUISITION ONLY, AND IS NOT INTENDED TO BE A BOUNDARY SURVEY OF THE PROPERTY SHOWN.

NOTE:
PROPERTY CORNERS SHOWN AS OPEN CIRCLES WERE LOCATED BY ACTUAL SURVEY. BEARINGS AND DISTANCES SHOWN IN PARENTHESES ARE BASED ON DEED INFORMATION. BEARINGS ARE BASED ON MAPBOOK 21 PAGE 190.

TO NATIONS FORD ROAD

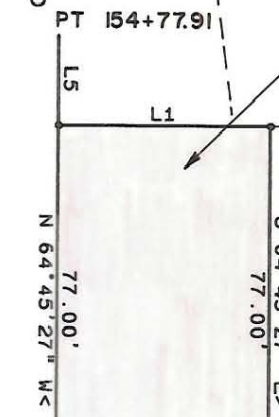

HEBRON STREET
EXISTING 80' R/W (NOT OPEN)
MAPBOOK 21 PAGE 190

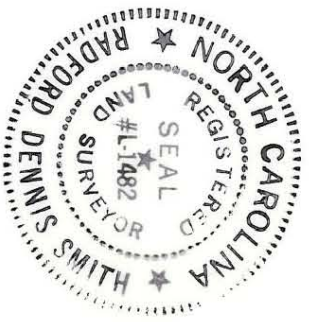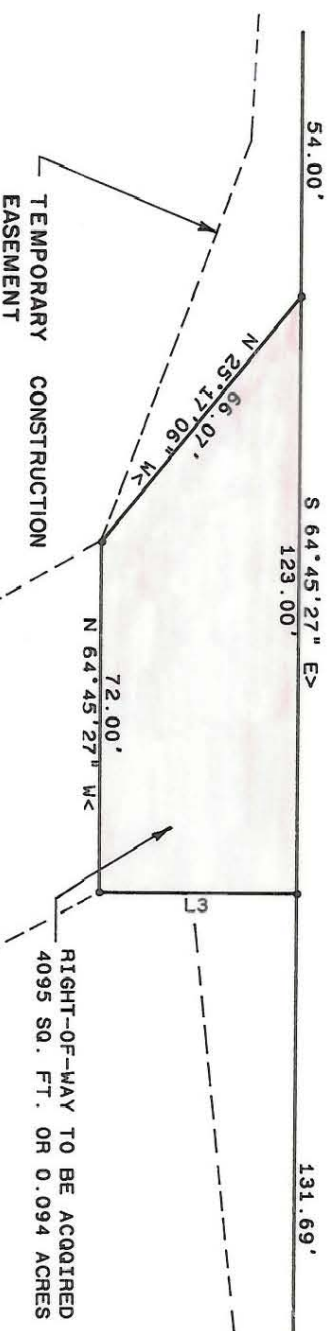

THIS PLAT WAS PREPARED UNDER MY

SUPERVISION *R. Dennis Smith*

N. C. REG. SURVEYOR NO. L-1482

DUKE POWER CO.
D. B. 3467-323



ENGINEERING DEPARTMENT

PROPERTY OF CARMEL INVESTMENT GROUP

HEBRON STREET

EXTENSION

REVISIONS	JOB NO.
DRAWN BY G.M.	FILE NO.
CHECKED BY R.D.S.	SHEET 2 D
<i>R. Dennis Smith</i>	OF 4
SURVEY SUPERV. DATE JULY 23, 1986	SCALE 1"=40'

205-153-08 AND

205-157-11