



PARCEL NO.	150
TOTAL AREA (BY DEED)	1,141.983 sq. m. = 12,292.19 sq. ft.
AREA WITHIN R/W TO BE ACQUIRED	
AREA OUTSIDE R/W TO BE ACQUIRED	124.381 sq. m. = 1,338.82 sq. ft.
REMAINING AREA	1,017.602 sq. m. = 10,953.37 sq. ft.
TEMPORARY CONSTRUCTION EASEMENT	104.580 sq. m. = 1,125.69 sq. ft.

LINE TABLE			
LINE	LENGTHm	LENGTHft	BEARING
L1	5.826m	19.11'	S77°20'56"W
L2	2.950m	9.68'	S77°20'56"W
L3	21.679m	71.13'	N23°03'29"W
L4	6.857m	22.50'	N77°17'13"E
L5	5.835m	19.14'	N77°17'13"E
L6	21.330m	69.98'	S12°40'31"E
L7	7.879m	25.85'	S12°39'04"E

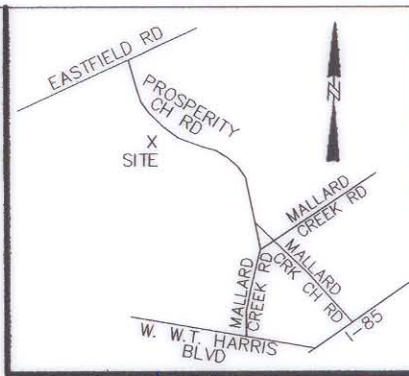

PROSPERITY CHURCH ROAD
18.288m (60') PUBLIC R/W
EXISTING/DESIGN CENTERLINE

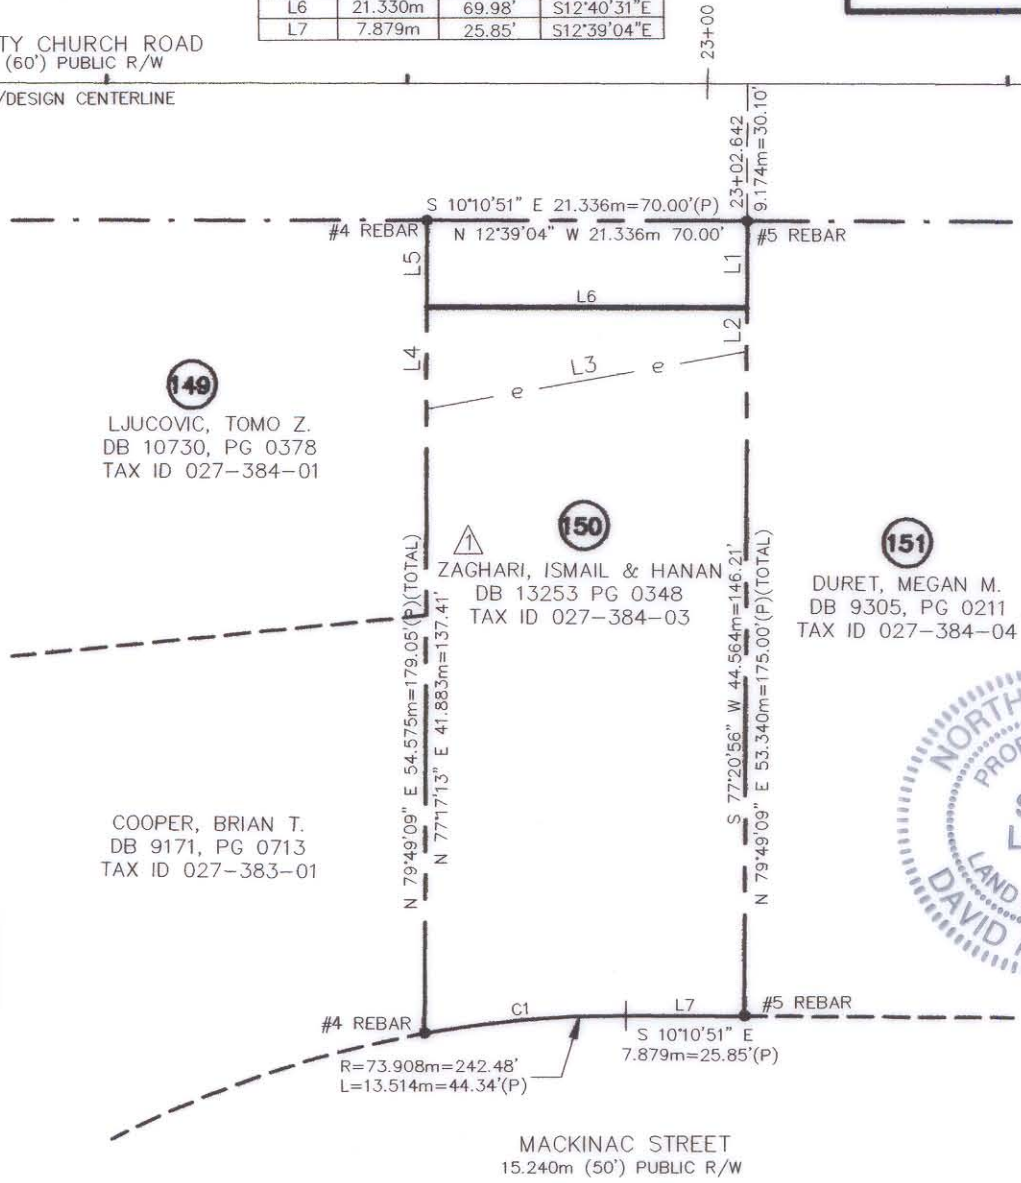

ACQUISITION BY CITY
RECORDED IN DEED BOOK
DB 13882 Pg 968
DATE



CURVE TABLE						
CURVE	RADIUSm	LENGTHm	LENGTHft	CHORDm	CHORDft	BEARING
C1	73.908m	13.472m	44.20'	13.454m	44.14'	N17°52'23"W

I David A. Weirich, N. C. P. L. S. certify that this map, drawn from an actual field survey under my direction, meets and/or exceeds the Minimum Standards set forth in the manual of Practice for Land Surveying in North Carolina. Title References regarding the adjoining properties are subject to information provided by local County Government. Subject tract title research for retracement of Boundary Lines only, and not intended to certify title.


David A. Weirich
David A. Weirich
L-3846

NOTE:
PROPERTY CORNERS SHOWN AS SOLID CIRCLES WERE LOCATED BY ACTUAL SURVEY. BEARINGS AND DISTANCES SHOWN IN PARENTHESIS ARE BASED ON DEED OR PLAT INFORMATION.

THIS MAP WAS PREPARED FOR THE PURPOSE OF PROPERTY ACQUISITION ONLY, AND IS NOT INTENDED TO BE A BOUNDARY SURVEY OF THE PROPERTY SHOWN.

GRAPHIC SCALE

(IN METERS)

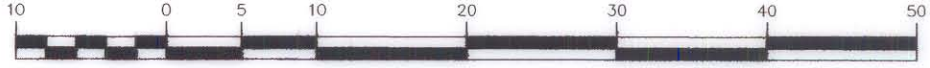

1 : 500

- LEGEND
- - EXISTING IRON PIN
 - - IRON PIN SET
 - P — PROPERTY LINE (SURVEYED)
 - EXISTING PROPERTY LINE
 - (D) - DEED (INFORMATION TAKEN FROM DEED)
 - EXISTING R/W LINE (PROSPERITY CHURCH RD.)
 - (P) - PLAT (INFORMATION TAKEN FROM PLAT)
 - e - TEMPORARY CONSTRUCTION EASEMENT
 - ADJOINING PROPERTY LINE



ESP ASSOCIATES, P.A.
engineering • surveying • planning

10915 Southern Loop Boulevard
Pineville, N.C. (704) 583-4949

1	5/02	WC	REVISE PROPERTY OWNER NAME
NO	DATE	BY	REVISIONS

CHARLOTTE
ENGINEERING DEPARTMENT

000-00-000	FILE NO	PROSPERITY CHURCH RD			
JOB NO	SCALES				
PLAN	1:500				
PROFILE	Hor 1:100 Vert 1:100	REVISED PLAN FOR PARCEL 150 ISMAIL & HANAN ZAGHARI 027-384-03			
AS BUILT	DATE				
ESP	BS	JKL	ACJ	SHEET	OF
SURVEYED BY	PREPARED BY	CHECKED BY	APPROVED BY	DATE	