



\* 0 0 B R E A K 0 0 \*



**ADVANCED  
IMAGING  
SYSTEMS**

www.aisimc.com

An Information  
Management Company

# City of Charlotte – Planning Dept. Scanning Rezoning Files

Petition # \_\_\_\_\_

## Document type:

- Applications
- Correspondence
- Department Comments
- Land Use Consistency
  - Mail Info
  - Mapping
  - Other
- Site Plans



\* 0 0 B R E A K 0 0 \*

ORDINANCE NO. 922-Z

AMENDING CHAPTER 23

AN ORDINANCE AMENDING THE CITY CODE WITH RESPECT TO THE ZONING ORDINANCE.

WHEREAS, two petitions were presented to the City Council of the City of Charlotte requesting the rezoning of property located along the southerly side of Woodlawn Road from R-9 to ~~R-9MF(CD)~~ <sup>R-6MF(CD)</sup> for construction of a multi family project; and

WHEREAS, the petition for rezoning for a parallel conditional use district as permitted by Section 23-35.1 was submitted to the Charlotte-Mecklenburg Planning Commission, was accompanied by a schematic plan, complied with all the application requirements as specified in Section 23-35(b), and was recommended for approval by the Charlotte-Mecklenburg Planning Commission; and

WHEREAS, the City Council has authority to amend the Zoning Ordinance by Section 23-96 and a public hearing was held on May 21, 1979; and

WHEREAS, in the passage of this ordinance the City Council of the City of Charlotte has considered the promotion of the health, safety, general welfare, and public interest of the community, and each of the following, which are required by Section 23-35(d):

1. The policies and objectives of the Comprehensive Plan of the City, and particularly in relation to the proposed site and surrounding area.
2. The potential adverse impacts of the establishment of the conditional district upon the surrounding area, especially in regards but not limited to traffic, storm drainage, land values and compatibility of land use activities.

BE IT ORDAINED BY THE CITY COUNCIL OF THE CITY OF CHARLOTTE:

Section 1. That Chapter 23, Section 23-8 <sup>R-6MF(CD)</sup> of the Code of the City of Charlotte is hereby amended by changing from R-9 to ~~R-9MF(CD)~~ <sup>R-6MF(CD)</sup> on the Official Zoning Map, City of Charlotte, N. C. the following described property:

BEING all of Mecklenburg County Tax Parcel Numbers 171-044-01, 171-044-02, 171-044-14, 171-044-15, 171-044-16, 171-044-17, 171-044-18, 171-044-19, 171-044-20, 171-044-21 and more specifically shown on the attached map.

Section 2. That all subsequent development and use of the property shall be in accordance with the approved plan.

Section 3. That this ordinance shall become effective upon its adoption.

# PARALLEL CONDITIONAL USE PERMIT

This is a parallel conditional use permit approved by the Charlotte City Council to \_\_\_\_\_  
D. S. MacRae et al and Stephen R. Walsh  
owner(s) and successors-in-interest of the property described as tax parcel \_\_\_\_\_\*  
and described in detail further in the ordinance, identified below, approved by the City Council.

In approving this parallel conditional use permit, the Charlotte City Council amended chapter 23 of the code of Charlotte and the official zoning map. The property now has a parallel conditional use district zoning classification of \_\_\_\_\_R-9MF(CD)\_\_\_\_\_

This parallel conditional use permit is subject to and incorporates by reference all of the following: the schematic plan, the supporting text, all attached conditions, and sections 23-35, 23-35.1, and 23-96 of the code, all of which preceding are binding upon the property and all subsequent development and use of the property. A failure to comply with any of the above may result in revocation of the parallel conditional use permit in accordance with the authority of the city council under section 23-96 of the code.

Three years from the date of approval of this parallel conditional use permit, the planning commission shall determine if active efforts to develop in accordance with approved plans have occurred. If active efforts to develop have not occurred, then a report shall be forwarded to the city council which may recommend that action be initiated to remove the parallel conditional use district in accordance with section 23-96.

\*171-044-01, 171-044-02, 171-044-14, 171-044-15, 171-044-16, 171-044-17, 171-044-18,  
171-044-19, 171-044-20, 171-044,21

PETITIONER Stephen R. Walsh


PETITION NO. 79-24

HEARING DATE 5/21/79

ZONING CLASSIFICATION, EXISTING R-9

REQUESTED R-6MF(CD)

LOCATION Two separate parcels, both 120 feet south of Woodlawn Road, one fronting the east side of Halstead Drive and the other fronting the west side of Drexmore Avenue.

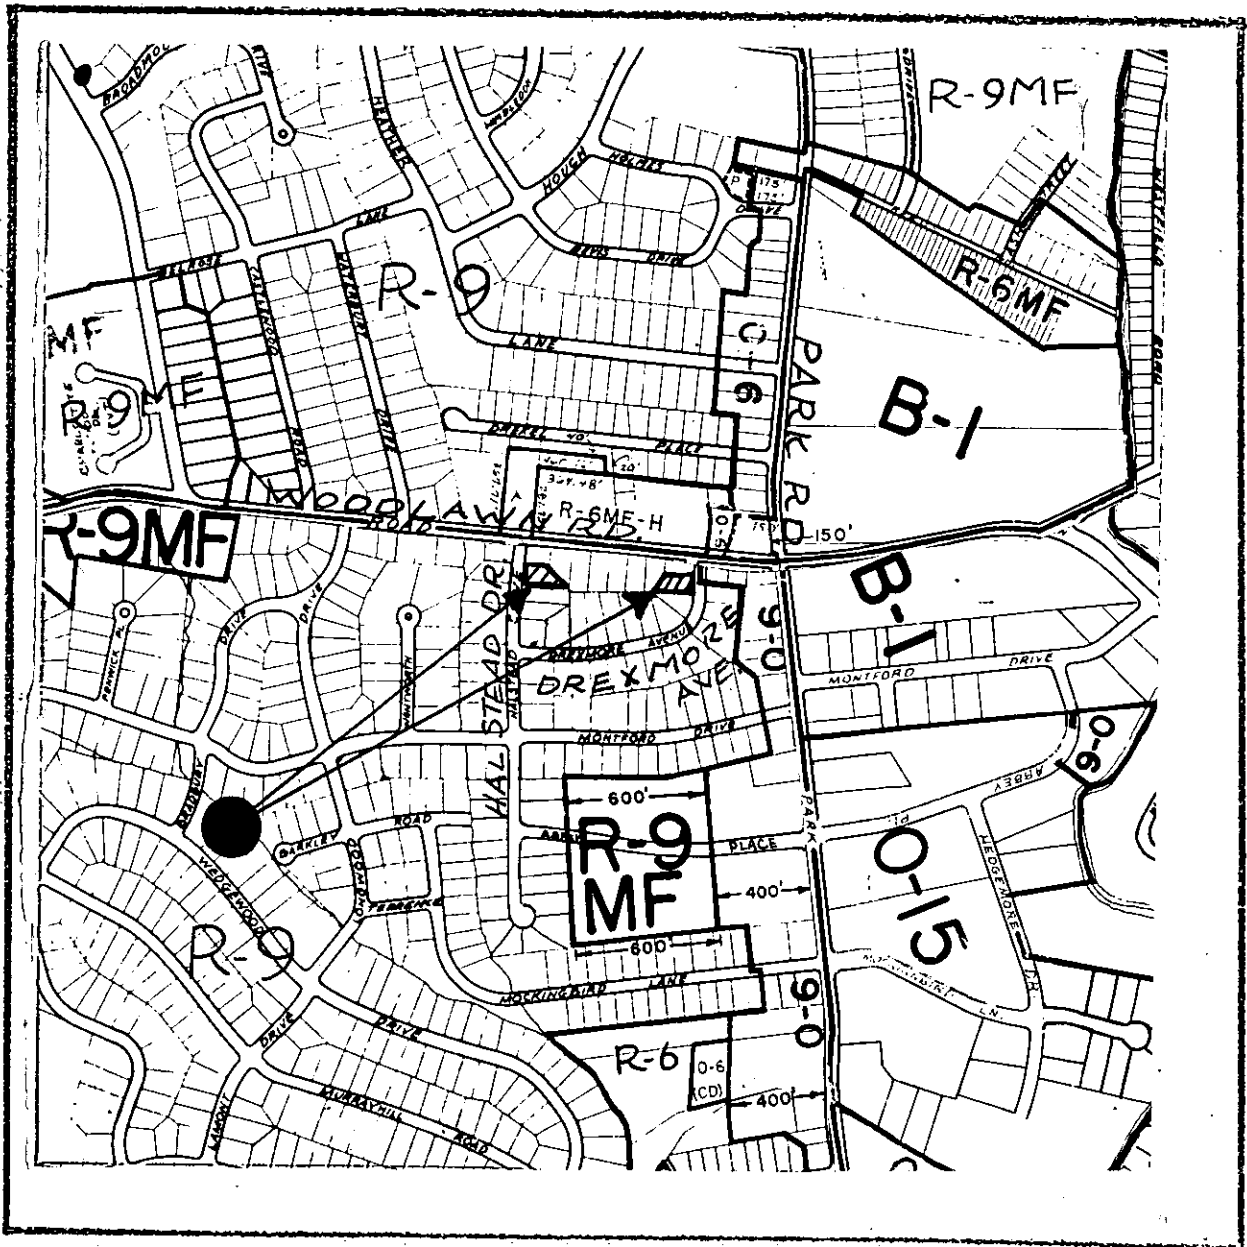

ZONING MAP NO. 32

SCALE 1" = 800'

PROPERTY PROPOSED FOR CHANGE

