

- 4" MASONRY


-columns@10:0"o.c.t

- FOOTING AT COLUMNS -

BRIDGED MASONRY WALL (SCHEMATIC)

TREE CANOPY

N.T.S.

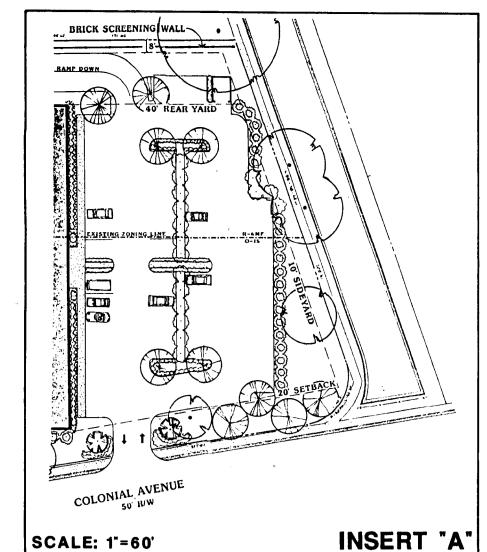

DEVELOPMENT DATA

Site Area (INCLUDES R/W ABANDONMENT) 1.39 AC. Existing Zoning____O-15,R-6 M.F. Proposed Zoning___O-6 (CD) Max. Building Area_____23,500 S.F. (GROSE) Min. Provided Parking____1 SP. / 200 S.F. OFFICE AREA

GENERAL NOTES

- AT THE TIME OF THE FILING OF THIS PETITION CIRCLE AVENUE IS A DEDICATED PUBLIC ROADWAY ADJACENT TO THE SITE WHICH THAT SUCH ABANDONMENT PETITION IS PURSUED AND PROSECUTED WITH REASONABLE DISPATCH
- PARCELS 155-029-01 & 04 TO ALLOW FOR VEHICULAR MOVEMENT BETWEEN THE THREE PARCELS FOLLOWING THE ABANDONMENT. RIGHT-OF-WAY AT ITS OWN EXPENSE, ASSUMING ALL THE CONTINGENCIES ADDRESSED IN THESE DEVELOPMENT NOTES ARE MET AND THE ABANDONMENT PETITION IS APPROVED.
- RIGHT-OF-WAY ABANDONMENT, EASEMENTS OR AGREEMENTS AS DESCRIBED IN NOTES 1 AND 2 ABOVE ARE NOT SUCCESSFULLY COMPLETED AS DESCRIBED, THE PARKING CONFIGURATION AND EDGE OF THE SITE ADJACENT TO CIRCLE AVENUE WILL BE
- EXISTING TREES THAT WILL REMAIN ARE IDENTIFIED ON THE SITE PLAN, AND WILL BE PROTECTED DURING CONSTRUCTION AND GRADING THROUGH THE USE OF ADEQUATE BARRIERS, STAKING, ETC. ALL PROVISIONS OF THE CHARLOTTE TREE ORDINANCE (CHAPTER 21, CHARLOTTE CITY CODE) SHALL BE OBSERVED.
- 5. THE SITE WILL BE USED FOR DEVELOPMENT OF A MEDICAL OFFICE BUILDING CONTAINING CLINICS, MEDICAL, DENTAL, OR DOCTOR'S OFFICES AND RELATED USES.
- 6. ALL SIGNAGE SHALL BE DEVELOPED IN ACCORDANCE WITH APPLICABLE ORDINANCE STANDARDS CONTAINED IN THE CHARLOTTE CITY CODE SECTIONS 3047 & 2100, ET SEQ.
- 7. THE SITE WILL CONTAIN ONE DRIVEWAY ACCESS FOR INGRESS AND EGRESS ONTO COLONIAL AVENUE. NO VEHICULAR ACCESS WILL BE PROVIDED TO OR FROM THE SITE TO ANY PORTION OF CIRCLE AVENUE WHICH IS NOT ABANDONED. THE ENTRANCE AND EXIT SHOWN ON THE SITE PLAN SHALL BE CONSTRUCTED IN CONFORMITY WITH ALL DRIVEWAY REGULATIONS OF THE CITY OF CHARLOTTE.
- 8. THIS SITE PLAN IS INTENDED TO DEPICT THE GENERAL LOCATIONS OF ALL STRUCTURES, AREAS, AND USES. FINAL BUILDING FOOTPRINT, PARKING LAYOUT, LANDSCAPING, AND ENTRANCE/EXIT ARE SUBJECT TO NON-MATERIAL ADJUSTMENTS UPON FINALIZATION OF SITE AND ARCHITECTURAL PLANS. THE ENDS OF THE OFFICE BUILDING WILL BE DESIGNED WITH A SENSITIVITY TO THE SCALE OF THE ADJOINING RESIDENTIAL PROPERTY.
- CHARLOTTE CITY CODE SEC. 3044. 10. THE PROPERTY OWNER SHALL CONTRACT WITH ITS GARBAGE REMOVAL SERVICE TO LIMIT GARBAGE PICKUPS AT THE SITE TO BETWEEN 8:30 A.M. AND 5:30 P.M. IN ORDER TO MINIMIZE NOISE IMPACT ON THE ADJACENT NEIGHBORHOOD. THE DUMPSTER ON

9. ACCESSORY FEATURES AND STRUCTURES NORMALLY ASSOCIATED WITH THE ALLOWED USES SHALL BE PERMITTED IN ACCORDANCE WITH

THE SITE SHALL BE APPROPRIATELY SCREENED FROM ADJACENT PROPERTIES. MEDICAL WASTES WILL NOT BE DISPOSED OF IN THE DUMPSTER, BUT WILL BE HANDLED IN ACCORDANCE WITH N.C. GEN. STAT. SECTION 130A, ET. SEQ., AND REGULATIONS ADOPTED PURSUANT TO SUCH STATUTES. 11. PETITIONER, OR ITS SUCCESSOR/S IN INTEREST, SHALL BE REQUIRED TO INCLUDE A PROVISION IN LEASES WITH ALL TENANTS

WHO OCCUPY THE PROPOSED OFFICE BUILDING WHICH PROHIBITS TENANTS AND THEIR EMPLOYEES FROM PARKING IN ANY PUBLIC

12. BOUNDARY AND TOPOGRAPHIC INFORMATION WAS PROVIDED BY SURVEY PERFORMED BY GENERAL SURVEYORS, P.A., DATED NOVEMBER 15, 1988.

RIGHT-OF-WAY ADJACENT TO ANY RESIDENTIALLY ZONED PARCELS ALONG CIRCLE AVENUE.

- 13. ALL PARKING WILL BE PROVIDED IN CONFORMITY WITH THE CHARLOTTE CITY CODE, SEC. 2000, ET. SEQ., AND SEC. 3048. SUBGRADE PARKING WILL BE PROVIDED IN CONFORMITY WITH SEC. 3048.2 AND SEC. 2014, AND WILL CONTAIN APPROXIMATELY 35
- 14. THE BRICK SCREENING WALL ALONG SOUTHERLY BOUNDARY OF THE SITE SHALL EXTEND INTO THE FORMER CIRCLE AVE.
 R/W AS SHOWN ON PLAN. THE CURVED "DECORATIVE WALL" WILL BE DESIGNED IN SUCH A WAY AS TO BE COMPLEMENTARY IN APPEARANCE TO THE BRICK SCREENING WALL; THE HEIGHT OF THIS "DECORATIVE WALL" IS NOT YET DETERMINED.


ATTACHED TO ADMINISTRATIVE
APPROVAL DATE 10/09/89
BY MARTINI TR. COMMITON JOHF FOR

REVISED ZONING PLAN FOR: ADMINISTRATIVE APPROVAL

10/10/89-PER CMPC REVIEW


Surveyed By Drawn By Project-Engr Approved By

REV. 10/4/89-ADD INSERT "A"

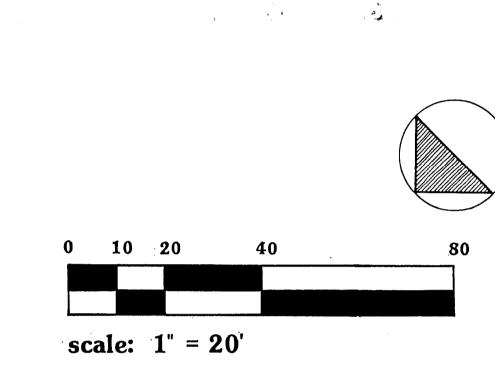

TURNBULL DESIGN GROUP, P.A. 2207 EAST SEVENTH STREET CHARLOTTE, NORTH CAROLINA 28204 (704)375-8154 8920 Job No. File No. **COLONIAL-PROVIDENCE** Scales **MEDICAL BUILDING** 1"=20' PLAN PROFILE. **REVISION TO** PETITION NO. 89-12 As Built Date

CHARLOTTE-MECKLENBURG PLANNING COMMISSION INTER-OFFICE COMMUNICATION

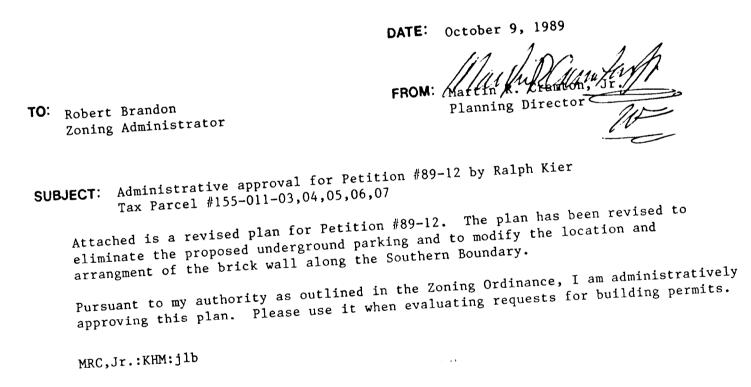

Ralph Kier 4826 Hardwicke Charlotte, NC 28211

October 4, 1989 10 5

Mr. Kieth MacVean Charlotte Mecklenburg Planning Commission Government Center 600 East Fourth Street Charlotte, NC 28202


Ref: Rezoning Petition #88-12 Dear Mr. MacVean:

We have made some minor modifications to the abovereferenced rezoning petition which was approved by City Council in April of this year. These changes include the elimination of underground parking for the proposed office development and the relocation of a brick screening wall along the southern property line. The changes appear on a revised zoning plan dated 8/18/89 by Turnbull Design Group, which we have submitted to your department. We request that the approved rezoning petition be amended to allow for the changes proposed.

Your prompt attention to this matter will be greatly appreciated.

Very truly yours,

Nobert Alefande Whit Sestember 20, 1989

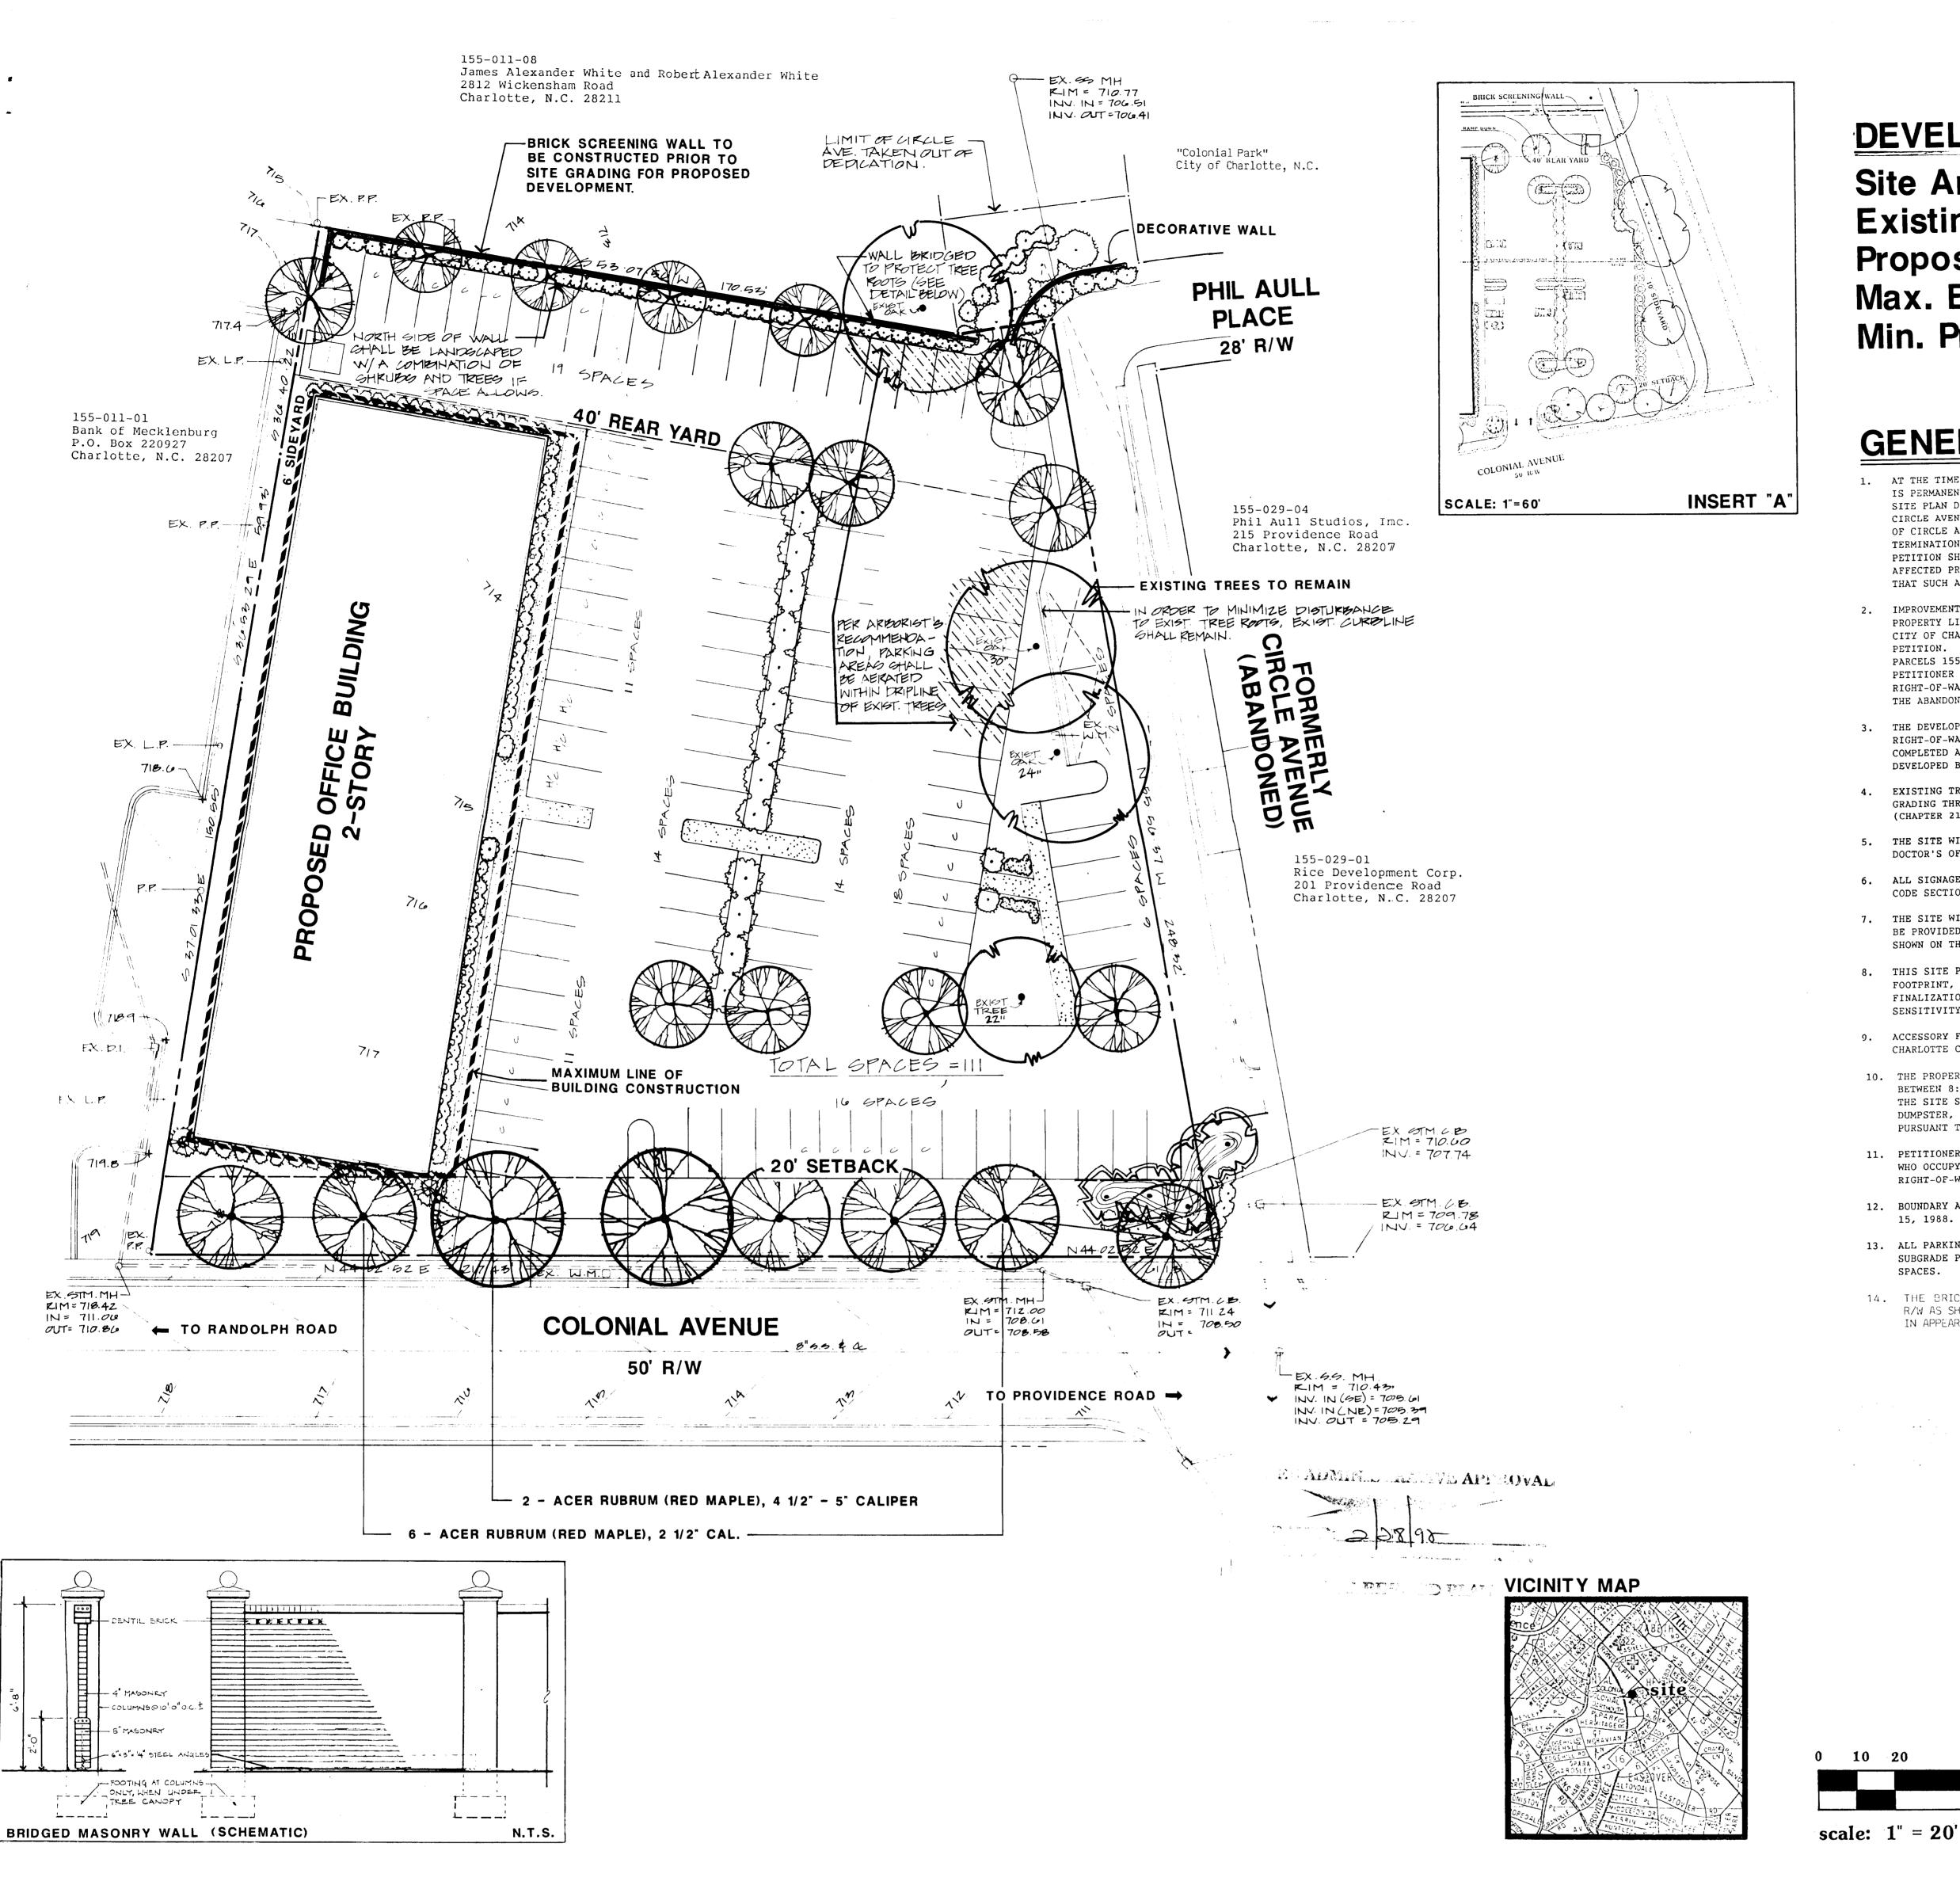

CHARLOTTE-MECKLENBURG PLANNING COMMISSION

INTER-OFFICE COMMUNICATION

DATE: March 22, 1990

TO: Robert Brandon
Zoning Administrator

Planning Director

SUBJECT: Administrative Approval for Petition #89-12 by Ralph Kier Tax Parcel #155-011-03, 04, 05, 06, 07

Enclosed is a revised plan for the above mentioned petition. The petition has been revised to show a new landscape treatment along Colonial Avenue. The originally approved plan had two maples that were to be saved. One of the maples was removed by a contractor who was moving a house from the property. The other maple had been removed by Duke Power at an earlier date and did not exist at the time the rezoning was filed. This new plan was required to help mitigate the removal of the tree. This new landscape plan applies even if the property is developed as per insert 'A'.

Pursuant to my authority as outlined in the zoning ordinance, I am administratively approving this plan. Please use it when evaluating requests for building permits.

MRC/KHM:sls

Enclosure

DEVELOPMENT DATA

Site Area_(INCLUDES R/W ABANDONMENT) 1.39 AC.

Existing Zoning____O-15,R-6 M.F.

Proposed Zoning____O-6 (CD)

Max. Building Area____23,500 S.F. (GROSE)

Min. Provided Parking___1 SP. / 200 S.F. OFFICE AREA

GENERAL NOTES

- AT THE TIME OF THE FILING OF THIS PETITION CIRCLE AVENUE IS A DEDICATED PUBLIC ROADWAY ADJACENT TO THE SITE WHICH IS PERMANENTLY TERMINATED, THROUGH THE USE OF A METAL BARRICADE, AT ITS INTERSECTION WITH COLONIAL AVENUE. THIS SITE PLAN DEPICTS THE PROPOSED DEVELOPMENT OF THE SITE IN THE EVENT THAT A FURTHER CLOSURE OR ABANDONMENT OF CIRCLE AVENUE IS APPROVED BY A DULY ADOPTED RESOLUTION OF THE CHARLOTTE CITY COUNCIL. THE PROPOSED ABANDONMENT OF CIRCLE AVENUE EXTENDS FROM ITS INTERSECTION WITH COLONIAL AVE. SOUTH TO THE POINT LABELLED "PROPOSED PERMANENT TERMINATION". PETITIONER AGREES TO UNDERTAKE TO FILE SUCH ABANDONMENT PETITION AFTER THE FILING OF THIS REZONING PETITION SHOULD THE PETITIONER DETERMINE THAT REASONABLE SUPPORT FOR ABANDONMENT EXISTS AMONG THE CONTIGUOUS AND AFFECTED PROPERTY OWNERS. PETITIONER ALSO AGREES TO PROVIDE SUCH COUNSEL AND ADVICE AS IS NECESSARY TO INSURE THAT SUCH ABANDONMENT PETITION IS PURSUED AND PROSECUTED WITH REASONABLE DISPATCH.
- 2. IMPROVEMENTS WITHIN THE ABANDONED CIRCLE AVENUE RIGHT-OF-WAY WHICH ARE OUTSIDE THE PETITIONER'S PROPOSED WESTERN PROPERTY LINE WILL REQUIRE THE CONSENT OF THE PROPERTY OWNERS OF TAX PARCELS 155-011-08, 155-029-01 & 04 AND THE CITY OF CHARLOTTE. THE PETITIONER SHALL SEEK SUCH CONSENTS CONTEMPORANEOUSLY WITH THE PURSUIT OF THE ABANDONMENT PETITION. THE PETITIONER SHALL ALSO SEEK CROSS EASEMENTS, OR OTHER APPROPRIATE AGREEMENTS, FROM THE OWNERS OF PARCELS 155-029-01 & 04 TO ALLOW FOR VEHICULAR MOVEMENT BETWEEN THE THREE PARCELS FOLLOWING THE ABANDONMENT. THE PETITIONER AGREES TO MAKE ALL ON-SITE AND OFF-SITE IMPROVEMENTS REFLECTED ON THIS SITE PLAN WITHIN THE ABANDONED RIGHT-OF-WAY AT ITS OWN EXPENSE, ASSUMING ALL THE CONTINGENCIES ADDRESSED IN THESE DEVELOPMENT NOTES ARE MET AND THE ABANDONMENT PETITION IS APPROVED.
- 3. THE DEVELOPMENT DEPICTED HEREIN REPRESENTS THE SITE PLAN PREFERRED BY PETITIONER. IN THE EVENT THAT THE RIGHT-OF-WAY ABANDONMENT, EASEMENTS OR AGREEMENTS AS DESCRIBED IN NOTES 1 AND 2 ABOVE ARE NOT SUCCESSFULLY COMPLETED AS DESCRIBED, THE PARKING CONFIGURATION AND EDGE OF THE SITE ADJACENT TO CIRCLE AVENUE WILL BE DEVELOPED BY PETITIONER WITHIN THE EXISTING PROPERTY LINE AS DEPICTED IN INSERT "A".


 4. EXISTING TREES THAT WILL REMAIN ARE IDENTIFIED ON THE SITE PLAN, AND WILL BE PROTECTED DURING CONSTRUCTION AND
- GRADING THROUGH THE USE OF ADEQUATE BARRIERS, STAKING, ETC. ALL PROVISIONS OF THE CHARLOTTE TREE ORDINANCE (CHAPTER 21, CHARLOTTE CITY CODE) SHALL BE OBSERVED.
- 5. THE SITE WILL BE USED FOR DEVELOPMENT OF A MEDICAL OFFICE BUILDING CONTAINING CLINICS, MEDICAL, DENTAL, OR DOCTOR'S OFFICES AND RELATED USES.
- 6. ALL SIGNAGE SHALL BE DEVELOPED IN ACCORDANCE WITH APPLICABLE ORDINANCE STANDARDS CONTAINED IN THE CHARLOTTE CITY
- . THE SITE WILL CONTAIN ONE DRIVEWAY ACCESS FOR INGRESS AND EGRESS ONTO COLONIAL AVENUE. NO VEHICULAR ACCESS WILL BE PROVIDED TO OR FROM THE SITE TO ANY PORTION OF CIRCLE AVENUE WHICH IS NOT ABANDONED. THE ENTRANCE AND EXIT SHOWN ON THE SITE PLAN SHALL BE CONSTRUCTED IN CONFORMITY WITH ALL DRIVEWAY REGULATIONS OF THE CITY OF CHARLOTTE.
- 8. THIS SITE PLAN IS INTENDED TO DEPICT THE GENERAL LOCATIONS OF ALL STRUCTURES, AREAS, AND USES. FINAL BUILDING FOOTPRINT, PARKING LAYOUT, LANDSCAPING, AND ENTRANCE/EXIT ARE SUBJECT TO NON-MATERIAL ADJUSTMENTS UPON FINALIZATION OF SITE AND ARCHITECTURAL PLANS. THE ENDS OF THE OFFICE BUILDING WILL BE DESIGNED WITH A SENSITIVITY TO THE SCALE OF THE ADJOINING RESIDENTIAL PROPERTY.
- 9. ACCESSORY FEATURES AND STRUCTURES NORMALLY ASSOCIATED WITH THE ALLOWED USES SHALL BE PERMITTED IN ACCORDANCE WITH CHARLOTTE CITY CODE SEC. 3044.
- 10. THE PROPERTY OWNER SHALL CONTRACT WITH ITS GARBAGE REMOVAL SERVICE TO LIMIT GARBAGE PICKUPS AT THE SITE TO BETWEEN 8:30 A.M. AND 5:30 P.M. IN ORDER TO MINIMIZE NOISE IMPACT ON THE ADJACENT NEIGHBORHOOD. THE DUMPSTER ON THE SITE SHALL BE APPROPRIATELY SCREENED FROM ADJACENT PROPERTIES. MEDICAL WASTES WILL NOT BE DISPOSED OF IN THE DUMPSTER, BUT WILL BE HANDLED IN ACCORDANCE WITH N.C. GEN. STAT. SECTION 130A, ET. SEQ., AND REGULATIONS ADOPTED PURSUANT TO SUCH STATUTES.
- 11. PETITIONER, OR ITS SUCCESSOR/S IN INTEREST, SHALL BE REQUIRED TO INCLUDE A PROVISION IN LEASES WITH ALL TENANTS WHO OCCUPY THE PROPOSED OFFICE BUILDING WHICH PROHIBITS TENANTS AND THEIR EMPLOYEES FROM PARKING IN ANY PUBLIC RIGHT-OF-WAY ADJACENT TO ANY RESIDENTIALLY ZONED PARCELS ALONG CIRCLE AVENUE.
- 12. BOUNDARY AND TOPOGRAPHIC INFORMATION WAS PROVIDED BY SURVEY PERFORMED BY GENERAL SURVEYORS, P.A., DATED NOVEMBER 15, 1988.
- 13. ALL PARKING WILL BE PROVIDED IN CONFORMITY WITH THE CHARLOTTE CITY CODE, SEC. 2000, ET. SEQ., AND SEC. 3048.

 SUBGRADE PARKING WILL BE PROVIDED IN CONFORMITY WITH SEC. 3048.2 AND SEC. 2014, AND WILL CONTAIN APPROXIMATELY 35
- 14. THE BRICK SCREENING WALL ALONG SOUTHERLY BOUNDARY OF THE SITE SHALL EXTEND INTO THE FORMER CIRCLE AVE.
 R/W AS SHOWN ON PLAN. THE CURVED "DECORATIVE WALL" WILL BE DESIGNED IN SUCH A WAY AS TO BE COMPLEMENTARY
 IN APPEARANCE TO THE BRICK SCREENING WALL; THE HEIGHT OF THIS "DECORATIVE WALL" IS NOT YET DETERMINED.


REVISED ZONING PLAN FOR: ADMINISTRATIVE APPROVAL

3/7/90 REV. COLONIAL AVE. TREE PLANTING 10/10/89-PER CMPC REVIEW REV. 10/4/89-ADD INSERT "A"

TURNBULL DESIGN GROUP, P.A.
2207 EAST SEVENTH STREET
CHARLOTTE, NORTH CAROLINA 28204
(704)375-8154

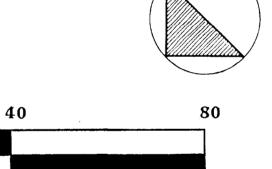

| 8920 Job No. File 1 Scales PLAN 1"=20 | 10. | COLONIAL-PROVIDENCE MEDICAL BUILDING | | | | | | |
|--|---------------|--------------------------------------|-------------|------------------------|-----------|----|--|--|
| PROFILE Hor. Vert. As Built Date | PE | REVISION TO PETITION NO. 89-12 | | | | | | |
| Surveyed By Designed | d By Drawn By | Project-Engr | Approved By | <u>elielea</u> Dale | Sheet | OI | | |

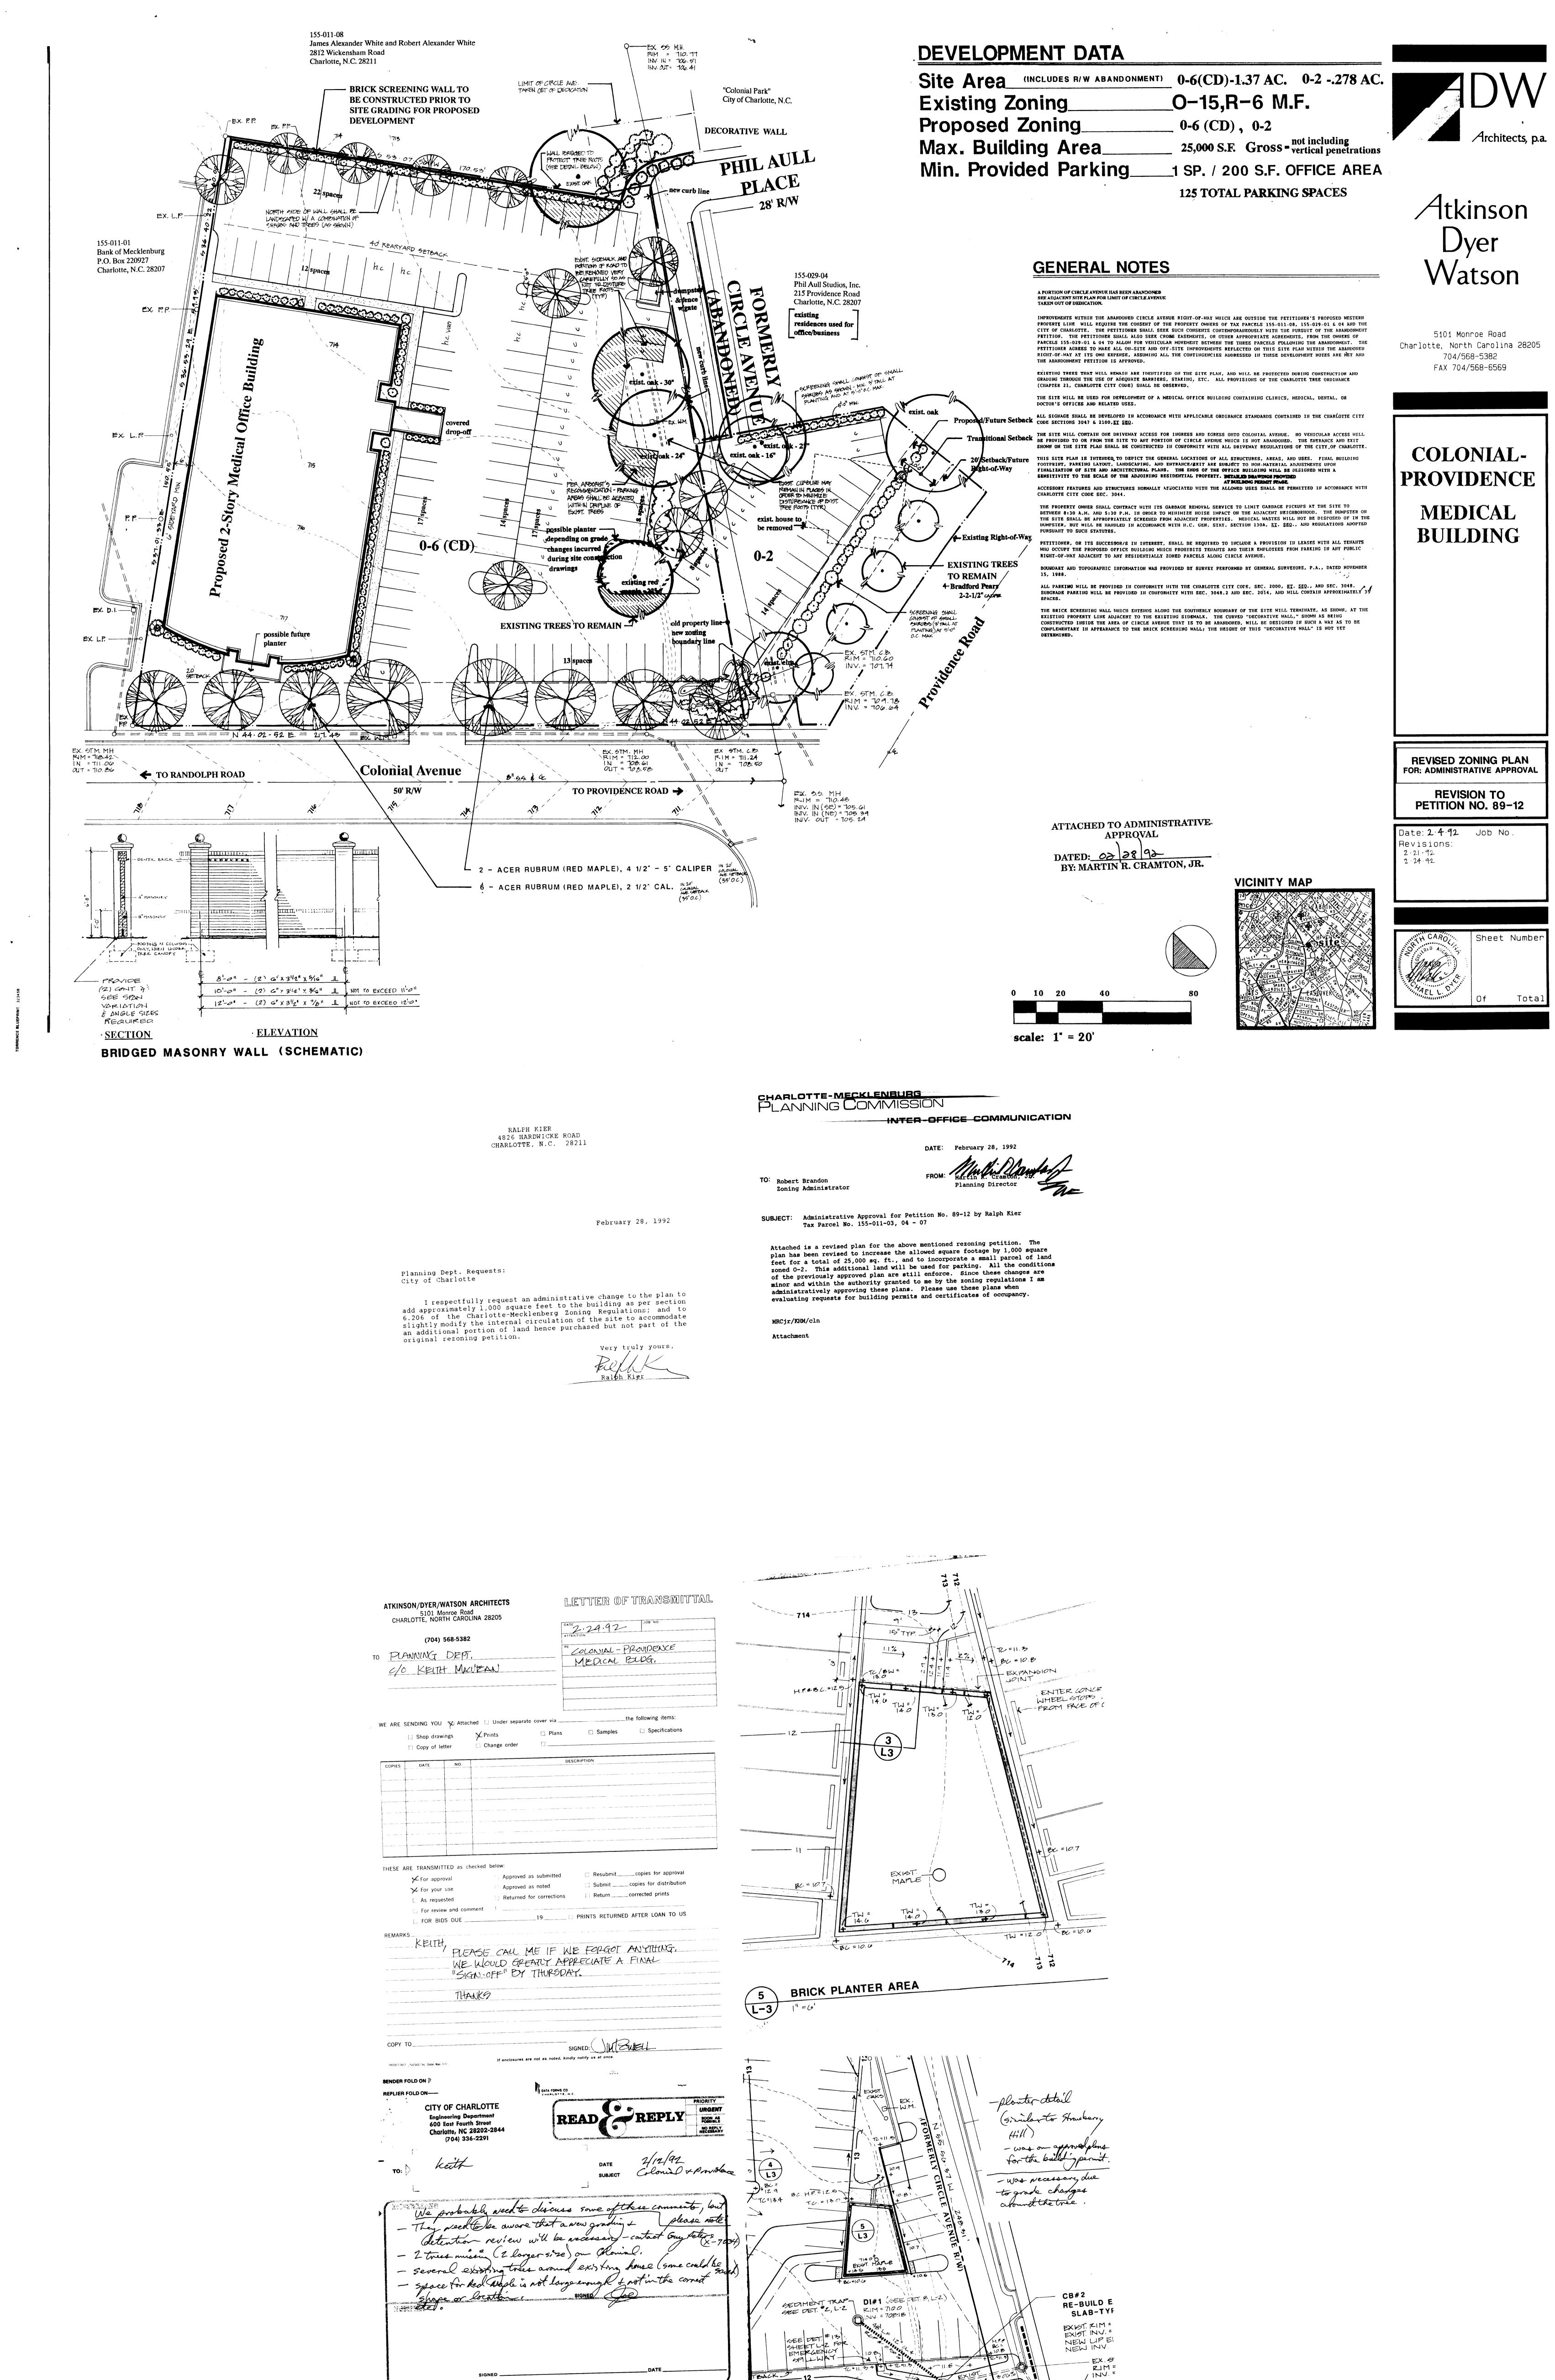

RECEIVER: WRITE REPLY, DETACH STUB, KEEP PINK COPY, RETURN WHITE COPY TO SENDER.

EX. STM. C.B. KIM = 711.24

IH = 708.50

EX.6.6. MH.

RIM = 710.43

INV. IN (6E) = 705.1

INV. IN (NE) = 705.2

INV. OUT = 705.2

7'11"

DIONIAL - PROV.

MEDICAL BUILDING

EX. 0TM . MH - 712.00 IN = 708.61 OUT = 708.58

TO PROVIDENCE ROAD

*14, THIS SHEET)

CONTROL JOINT ---

10'-0" - (2) 6" x 31/2" x 5/6" JL , NOT TO EXCEED 11-0"

12'-0" - (2) 6" X 31/2" X 3/8" IL NOT TO EXCEED 12'-0"

8-0" - (2) G" X 31/2" X 5/6" IL

· ELEVATION

DETAILS @ BRIDGED MASONRY WALL

TREE CANOPY

- PROVIDE (2) CONT. Y'S


SEE SPAN

VARIATION

· <u>SECTION</u>

NOT TO SCALE

É ANGLE SIZES REQUIRED

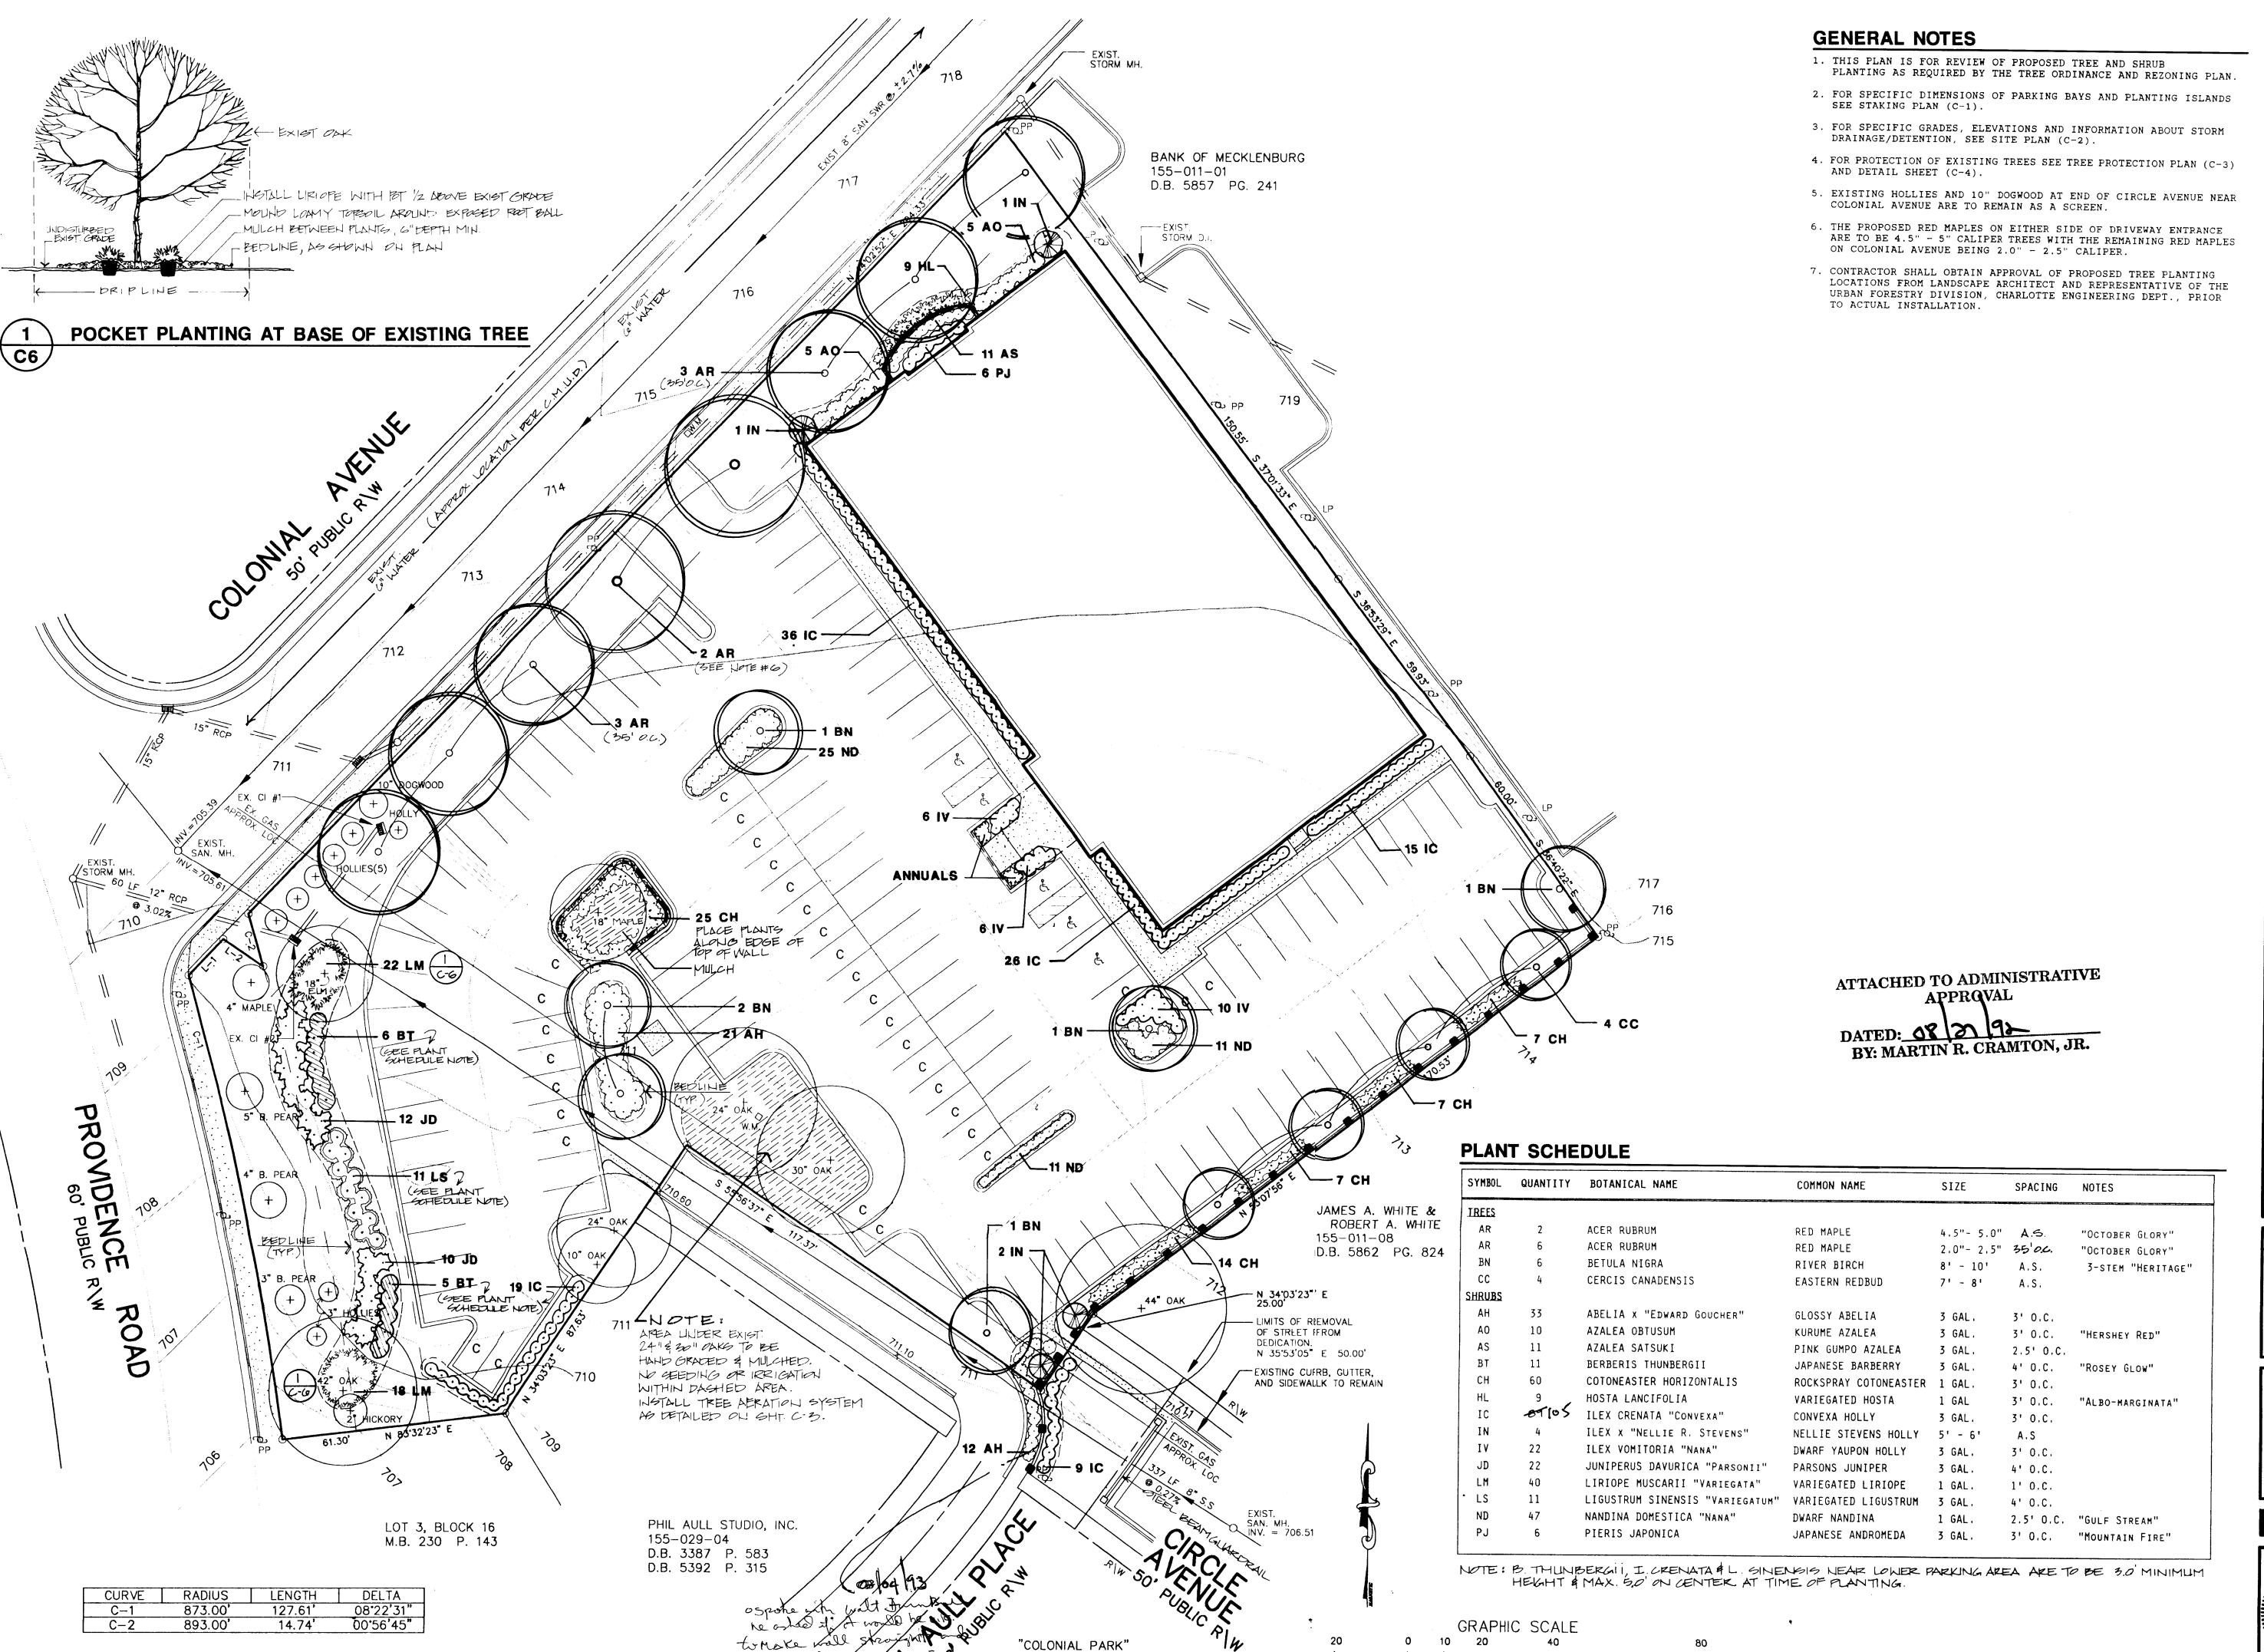






5101 Monroe Road Charlotte, North Carolina 28205 704/568-5382 FAX 704/568-7739

Providence-Colonial Medical **Building**

Charlotte, North Carolina

TURNBULL DESIGN GROUP, P.A 717 SOUTH TORRENCE STREET SUITE 301 CHARLOTTE, NORTH CAROLINA 28209 (704) 375-8154 FAX (704) 375-5563

Date: **5/29/92** Job No. **9209** Revisions: 6/16/92: PER TREE ORD. REVIEW 6/25/92: GENERAL 8/14/92: BLDG. STDS. REVIEW

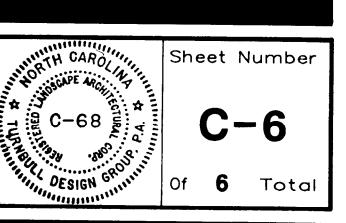

SITE PLANTING PLAN

CHARLOTTE-MECKLENBURG PLANNING COMMISSION

CITY OF CHARLOTTE

O.K. with us. Zech Amalen

DISTANCE

13.44

12.98'

DIRECTION N 44'02'52"

S 55'56'37" E

INTER-OFFICE COMMUNICATION

1 INCH = 20 FEET


DATE: August 27, 1992 TO: Robert Brandon Zoning Administrator


SUBJECT: Administrative Approval for Petition No. 89-12 by Ralp Kier Tax Parcel #155-011-03, 04-07

Attached is a revised landscape plan for the above mentioned rezoning petition. The plan has been revised to reflect no landscaping under two existing trees that have been saved. New landscaping under these existing trees increases the competition for water and nutrients and can reduce the survivability of the existing trees. Since these changes are minor I am administratively approving these plans. Please use these plans when evaluating requests for building permits and certificates of occupancy.

MRCjr/KHM:sls

Attachment

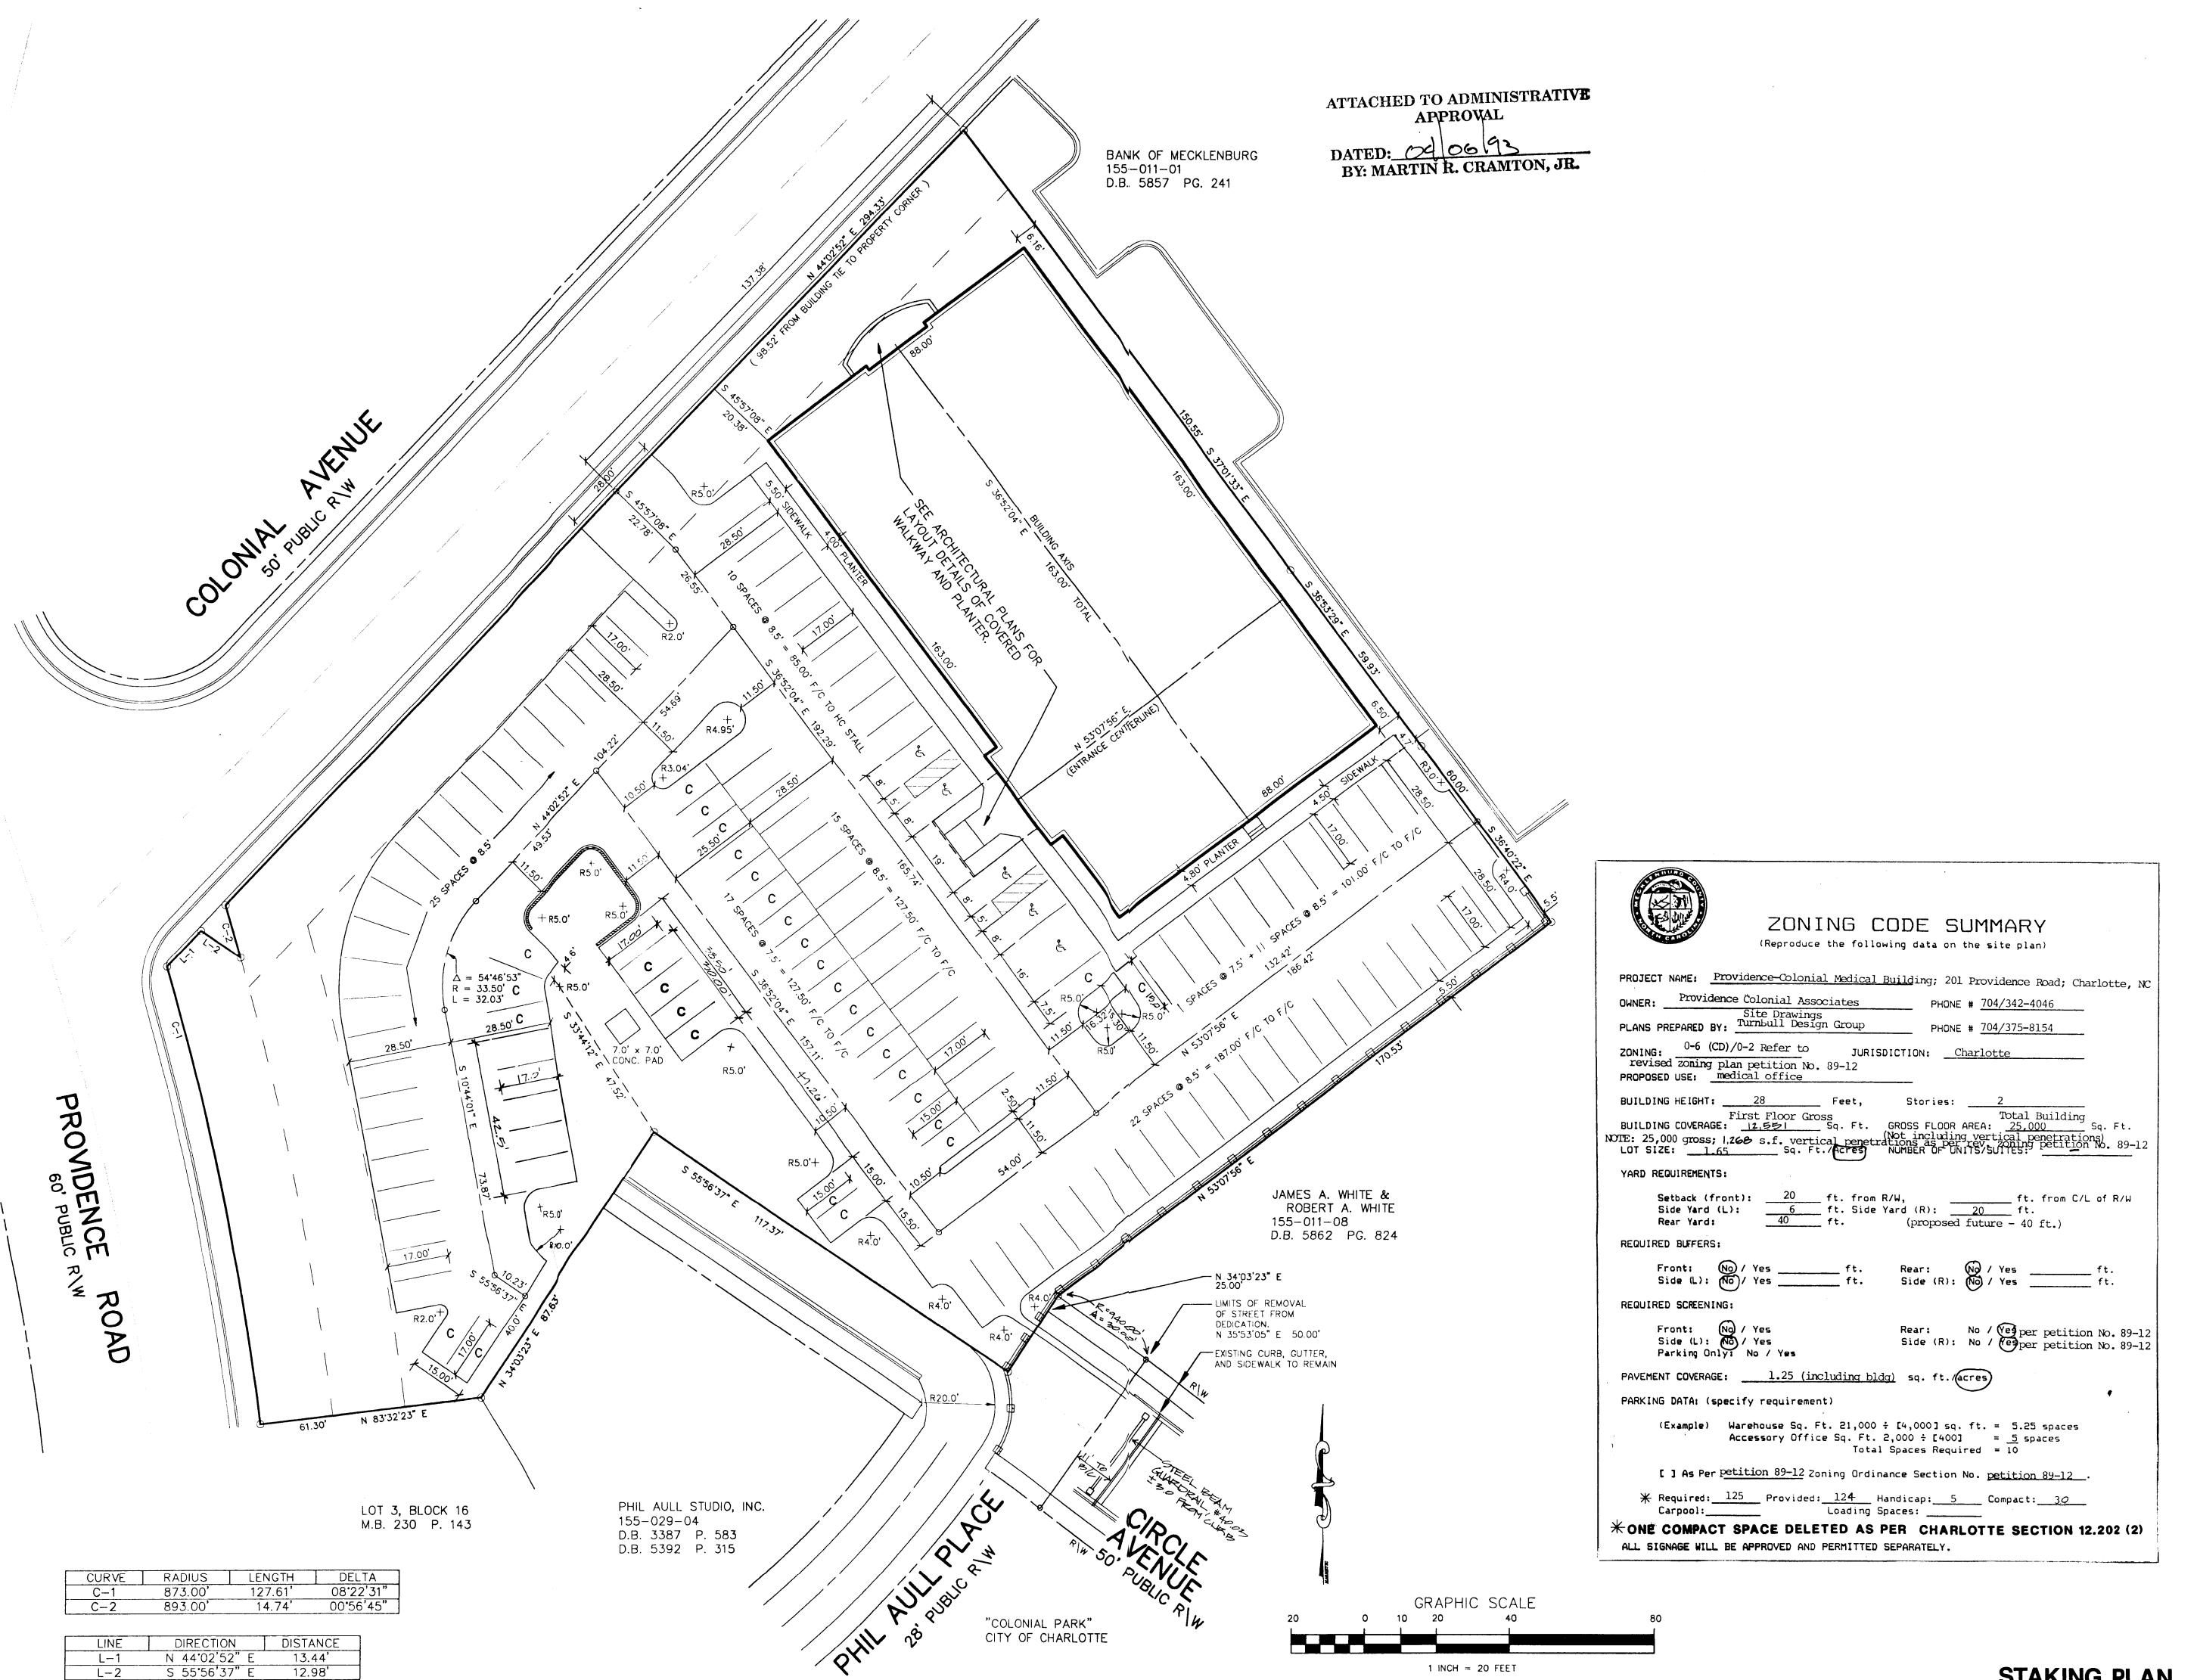

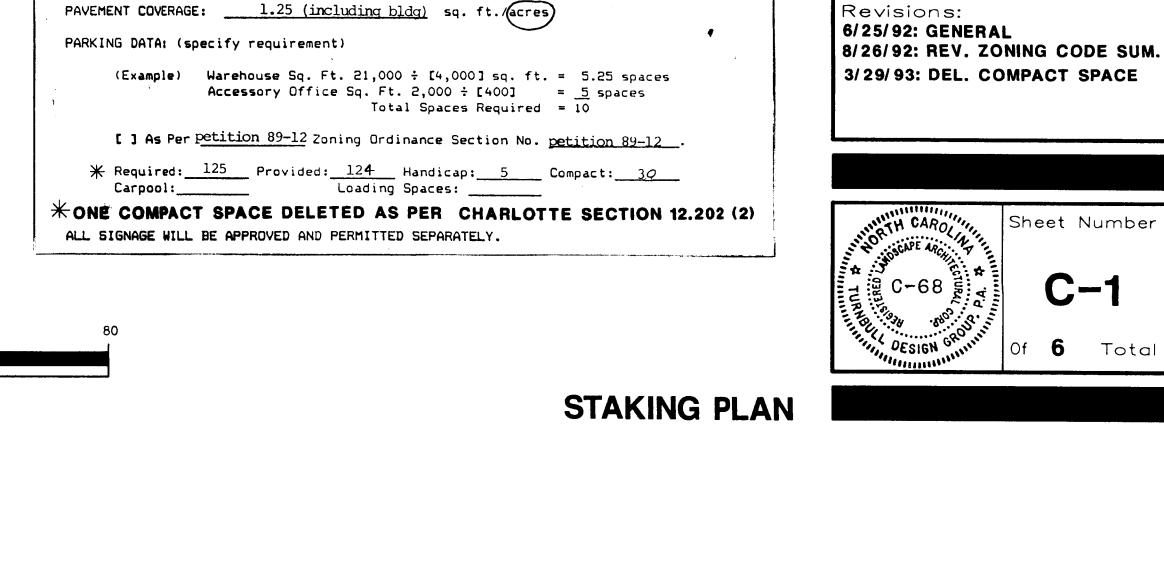

Atkinson Dyer Watson

5101 Monroe Road Charlotte, North Carolina 28205 704/568-5382 FAX 704/568-7739

Providence-

Colonial

Medical

Building

North Carolina

TURNBULL DESIGN GROUP, P.A

CHARLOTTE, NORTH CAROLINA 28204

Date: 6/24/92 Job No. 9209

717 SOUTH TORRENCE STREET

SUITE 301

(704) 375-8154

FAX (704) 375-5563

Charlotte,

March 26, 1993 Keith MacVean TO: Planning Commission Scott L. Putnam Transportation Engineering Division Department of Transportation SUBJECT: Request for a reduction in parking 201 Providence Road Section 12.202 (2) of the Zoning Ordinance allows the Planning Commission Director with concurrence from the Charlotte Department of Transportation to reduce parking space requirements by up to 25%, if providing all of the required spaces would result in building demolition or tree removals. Mary Ann Beale of the Engineering Department has identified potential impacts to two existing trees if the approved parking lot is constructed as per plan (March 25, 1993 memorandum). Based on our review of the site plan and evaluation of alternatives, we have determined that impacts to the trees cannot be avoided without the loss of one required parking space. A reduction of one parking space from the total number of 125 required parking spaces will not unreasonably increase parking congestion along public streets in the vicinity or in parking lots on adjacent properties. Under these circumstances we can support a reduction of one required parking space. Should you have questions or I can be or further assistance, please advise. SLP:hll Attachment cc: R. D. Gillis R. E. Goddard R. S. Williams

M E M O R A M D U M

CHARLOTTE-MECKLENBURG
PLANNING COMMISSION INTER-OFFICE COMMUNICATION DATE: April 6, 1993 TO: Robert Brandon Zoning Administrator SUBJECT: Modification of parking requirement as per Section 12.202(2) for 201 Providence Road, Tax Parcel #155-011-03, 04-07 As per Section 12.202(2) of the Charlotte zoning regulations we have investigated the possibility of modifying the parking requirement for 201 Providence Road. Our investigation has revealed that by the elimination of one required parking space two existing trees on the site will have a better chance of survival. The city's Urban Forestry staff which brought this possibility to our attention has verified that the elimination of the one parking space will increase the survivability of these two trees. We have also contacted the Department of Transportation and they have concluded that the elimination of one space from the required 125 will not adversely impact circulation on the surrounding public streets. Therefore, as per Section 12.202(2) we are approving the elimination of one required parking space from the total number of required parking spaces for 201 Providence Road. MRCJr/KHM:sls

CITY OF CHARLOTTE Engineering Department INTER-OFFICE MEMORANDUM


To: Scott Putnam Date: March 25, 1993 Manager of Engineering Services Section From: Mary Ann Beale / Urban Forester 201 Providence Road, Providence Colonial Associates

There are two healthy trees (24 inch and 16 inch) located near the parking areas whose root systems will be jeopardized by the parking lot improvements. The parking spaces and curb and gutter are closer than the plan shows. In accordance with section 12.202 (2) of the Zoning Ordinance, which allows a 25% reduction in parking requirements, we support owner's request for a reduction. By eliminating one compact parking space, the parking can be located 4 to 5 feet away from the trees giving us a better chance of saving the trees.

Please don't hesitate to call me if you have any questions..

M. A. Beale

March 24, 1993 Walter Fields Planning & Engineering Department City of Charlotte 600 East Fourth Street Charlotte, NC 28202 VIA: Telecopier Re: 201 Providence Road Dear Mr. Fields: Providence Colonial Associates is currently developing a medical facility located at 201 Providence Road and it has come to our attention that this property has two 24" oak trees which are too close to one parking space. In order to preserve these two trees this parking space will have to be eliminated. At the present time we are currently at code, therefore, we are respectfully requesting to lose one parking space in order to preserve these two trees. As time is of importance in this matter, a quick response to this issue is appreciated. Sincerely, Diane Rivers Brackett Company, Inc. Agent for Providence Colonial Associates cc: Robert Brandon Meck. County Bldg. Standards Mary Anne Beale Engineering Dept.

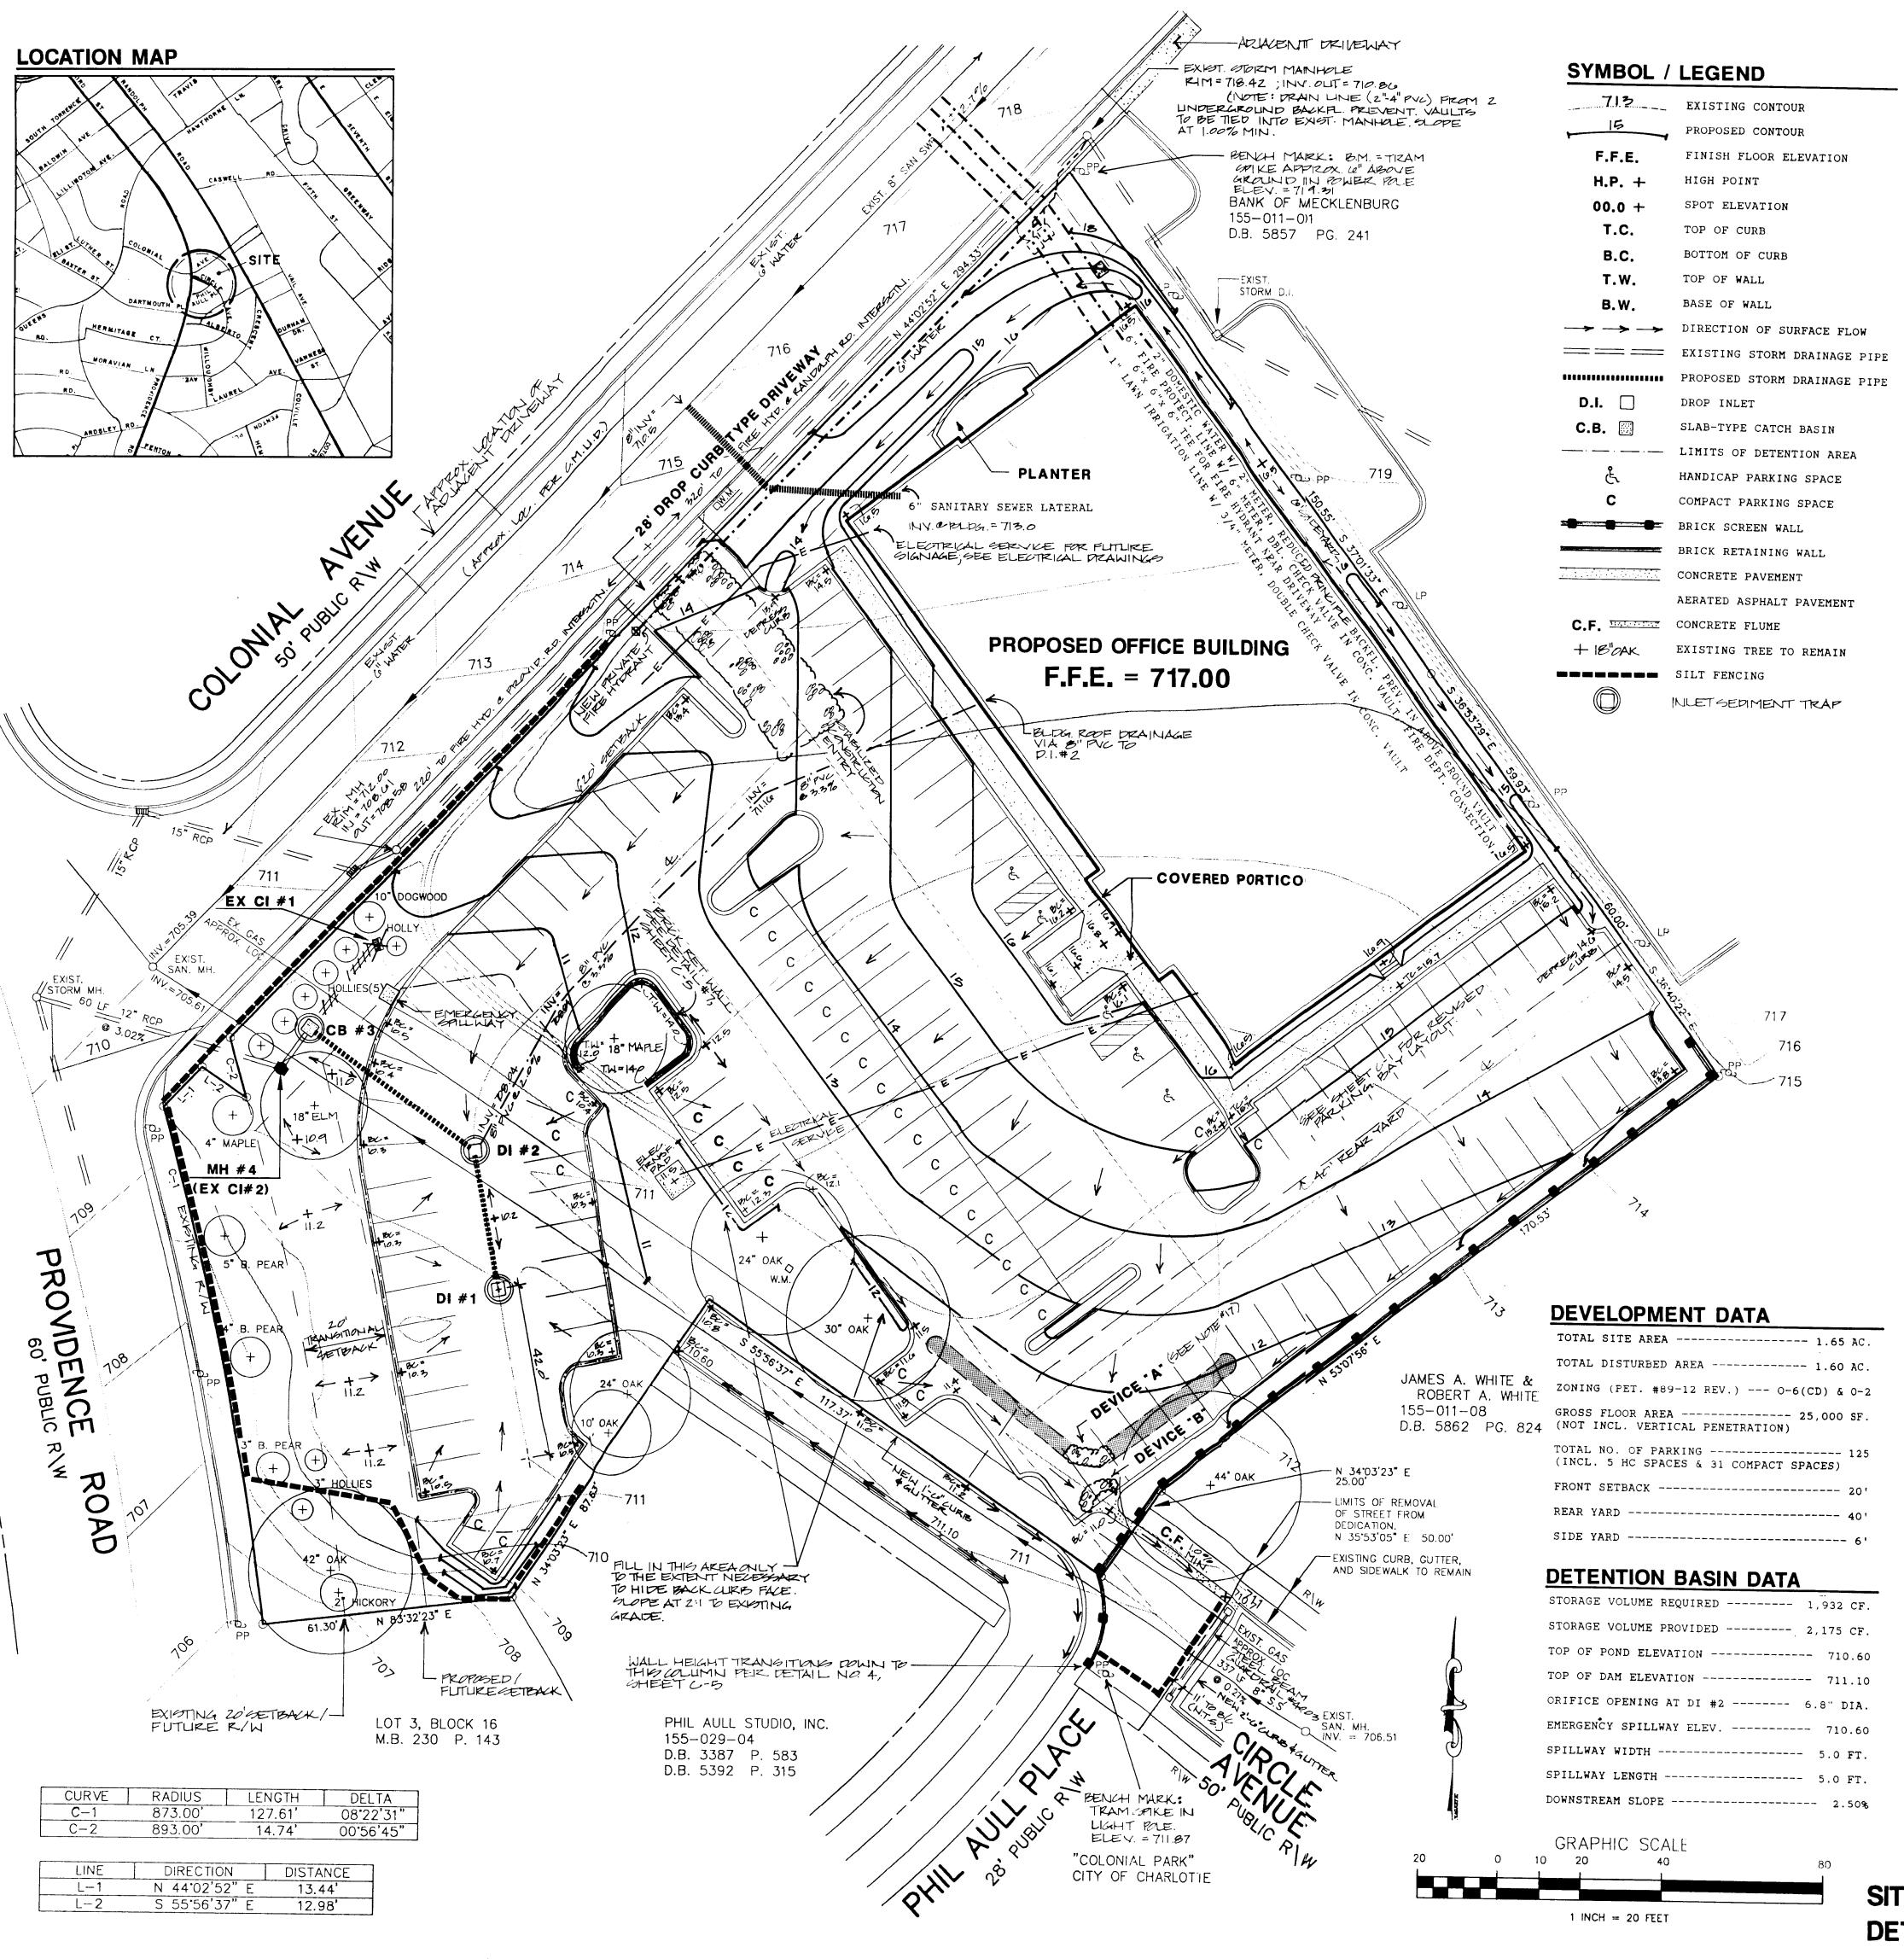

GENERAL NOTES

- 1. BOUNDARY, TOPOGRAPHIC AND EXISTING SITE INFORMATION FROM SURVEY PREPARED BY GERALD ELLIS, NCRLS #L-2535, DATED APRIL 29, 1992.
- 2. ALL GENERAL NOTES APPEARING ON THE REVISED ZONING PLAN (PETITION #89-12 REV.) BY ATKINSON, DYER, WATSON ARCHITECTS, P.A., DATED 2/24/92, SHALL APPLY FOR THIS PROJECT.
- 3. LAND DEVELOPMENT ENGINEER TO BE GIVEN 24 HOURS ADVANCE NOTICE PRIOR TO START OF CONSTRUCTION.
- 4. NO DEMOLITION LANDFILLS WILL BE LOCATED ON THIS SITE.
- 5. ESTIMATED PROJECT COMPLETION DATE IS EARLY 1993.
- 6. SOIL TYPE IS CECIL-URBAN LAND COMPLEX (CuB), 2-8% SLOPES.
- 7. ALL PROPOSED ELEVATIONS SHOWN ARE TO FINISH GRADE.
- 8. CURB LINE SHOWN ON PLANS REPRESENTS FACE OF CURB.
- 9. EXISTING CONTOURS SHOWN ARE AT 1 FOOT INTERVALS.
- 10. COORDINATE ALL CURB AND STREET GRADES AT DRIVEWAY ENTRANCE WITH CHARLOTTE ENGINEERING INSPECTOR.
- 11. ALL SUBSURFACE DRAINAGE PIPE SHALL BE EITHER C-75 OR C-76 REINFORCED CONCRETE PIPE (RCP) OR CORRUGATED METAL PIPE AS APPROVED BY THE CITY OF CHARLOTTE ENGINEERING DEPT.
- 12. IN ORDER TO INSURE PROPER DRAINAGE, KEEP A MINIMUM OF 0.50% SLOPE ON THE CURB.
- 13. THE CITY OF CHARLOTTE ENGINEERING DEPT. HAS NOT REVIEWED THE STRUCTURAL STABILITY OF ANY RETAINING WALLS ON THE SITE AND DOES NOT ASSUME RESPONSIBILITY FOR THEM.
- 14. BRICK SCREEN WALL FROM NORTHEAST PROPERTY CORNER TO FORMER R/W OF CIRCLE AVENUE IS TO BE BUILT PRIOR TO SITE GRADING. THE PORTION OF THE WALL THAT SPANS THE FLUME AREA AS WELL AS THE CURVED PORTION CAN BE BUILT PER CONTRACTORS SCHEDULE.
- 15. GRADING MORE THAN ONE ACRE WITHOUT A PERMIT OR GRADING OUTSIDE THE LIMITS SHOWN IS A VIOLATION OF CITY CODE AND IS SUBJECT TO AN IMMEDIATE FINE OF \$1000.00, PLUS ADDITIONAL FINES OF UP TO \$500.00 PER DAY.
- 16. APPROVAL OF THIS PLAN IS NOT AN AUTHORIZATION TO GRADE ADJACENT PROPERTIES. WHEN FIELD CONDITIONS WARRANT OFF-SITE GRADING, PERMISSION MUST BE OBTAINED FROM THE AFFECTED PROPERTY OWNERS.
- 17. PROVIDE A LONG, +1.5' HIGH BERM WITH RIP-RAP AND GRAVEL SEDIMENT FILTER UNTIL CURB & GUTTER IS INSTALLED (DEVICE "A"). ONCE THE CURBING AND FLUME IS IN PLACE AND UNTIL THE PLACEMENT OF PARKING BASE COURSE, PROVIDE A STONE FILTER RING AT FLUME ENTRANCE (DEVICE "B").
- 18. WHERE NECESSARY, CONSTRUCTION OF THE FOLLOWING ITEMS SHALL BE IN ACCORDANCE WITH THE CURRENT CHARLOTTE-MECKLENBURG LAND DEVELOPMENT STANDARDS MANUAL OR N.C. D.C.T. STDS AS SHOWN:

| 2'-6" CURB AND GUTTER 1'-6" CURB AND GUTTER CONCRETE SIDEWALK DROP CURB TYPE DRIVEWAY WHEELCHAIR RAMP BRICK CATCH BASIN / FRAME, GRATE & HOOD SLAB-TYPE CATCH BASIN BLOCK MANHOLE BRICK DROP INLET STEEL BEAM TYPE GUARDRAIL CONCRETE CONTROL MONUMENTS PLANTING DETAIL-LARGE MATURING TREE PLANTING DETAIL-SMALL MATURING TREE TREE PROTECTION DETAIL | 10.17 10.17 10.22 10.24 10.33 20.01/20.02 20.05 20.09/20.10 20.13/20.14 40.03 40.07 40.14 40.15 40.16 |
|--|--|
|--|--|

Atkinson

5101 Monroe Road Charlotte, North Carolina 28205 704/568-5382 FAX 704/568-7739

Providence-Medical Building

Charlotte, North Carolina

TURNBULL DESIGN GROUP, P.A.

CHARLOTTE, NORTH CAROLINA 28209

Date: **5/29/92** Job No. **9209**

6/15/92: PER ENG. DEPT. REVIEW

8/14/92; 8/31/92: BLDG. STDS.

3/2/93: DEL. COMPACT SPACE

717 SOUTH TORRENCE STREET

(704) 375-8154

Revisions:

6/30/92: GENERAL

7/8/92: GENERAL

FAX (704) 375-5563

STORM DRAINAGE DATA

| STRUCTURE | RIM/LI | IP IN | V. IN | INV. OUT |
|----------------------------------|--------------------------------------|-------|----------------|----------------------------|
| DI #1 DI #2 CB #3 MH #4 | 710.00 710.00 710.30 710.50 | 70 | 08.04 07.15 | 708.20 707.84 706.95 |
| EX. CI #1 EX. CI #2 | 710.60 |) | 06.64 | 706.64 707.74 706.64 |
| | | ENGTH | SIZE | GRADE |
| | | 32 LF | 12" RCP | 0.50% |

- STORM DRAINAGE NOTES:
- ALL PROPOSED 12" RCP TO BE CLASS 4 PIPE. 2. EXISTING CI #1 AND PIPE TO THE NEW CB #3 IS TO BE REMOVED.
- 3. EXISTING CI #2 IS TO BE MODIFIED TO STORM

12" RCP

Sheet Number

SITE, GRADING, STORM DRAINAGE, DETENTION, & EROSION CONTROL PLAN