



\* 0 0 B R E A K 0 0 \*



**ADVANCED  
IMAGING  
SYSTEMS**

www.aisimc.com

An Information  
Management Company

# City of Charlotte – Planning Dept. Scanning Rezoning Files

Petition # \_\_\_\_\_

## Document type:

- Applications
- Correspondence
- Department Comments
- Land Use Consistency
  - Mail Info
  - Mapping
  - Other
- Site Plans



\* 0 0 B R E A K 0 0 \*



0-6 to ~~1000~~ R-4 property owners

# 7


PG. 20

adjacent owner

PG. 20 CHAR. SECT. LIMITS

PG. 16

PG. 17

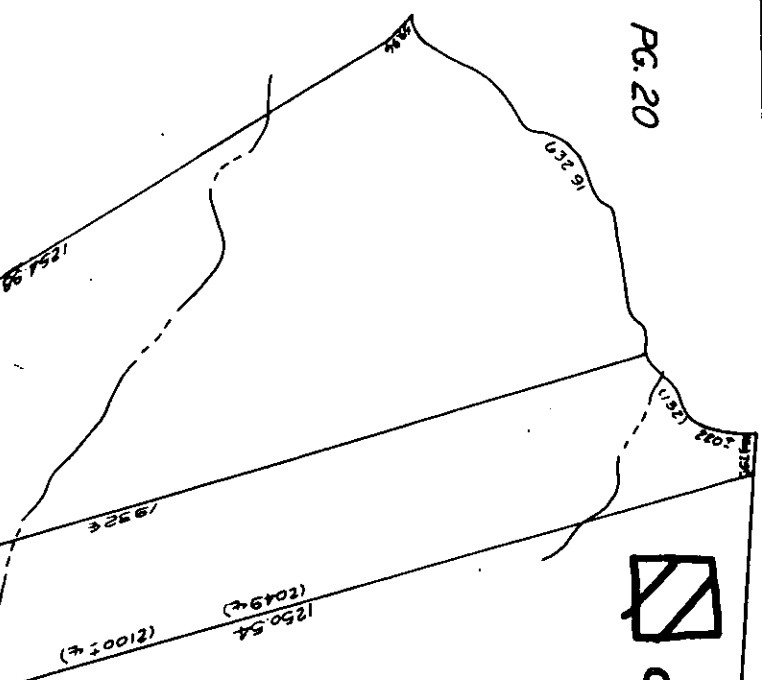

PG. 23

(181)

FOR TAX PURPOSES ONLY

QUEEN ANNE RD.

TRYON

BK. 167

ST. -- 100' -- NC. 49

BUCCO ST.


SOUTHAMPTON RD.


TO JAY RD  
1/25/91

PG. 17

TAX LINE MAP BOOK 143 PAGE 148  
 MECKLENBURG COUNTY, NORTH CAROLINA  
 REVISED 3-7-91 SCALE 1" = 200'



 O-6 to ~~R-4~~ adjacent owners

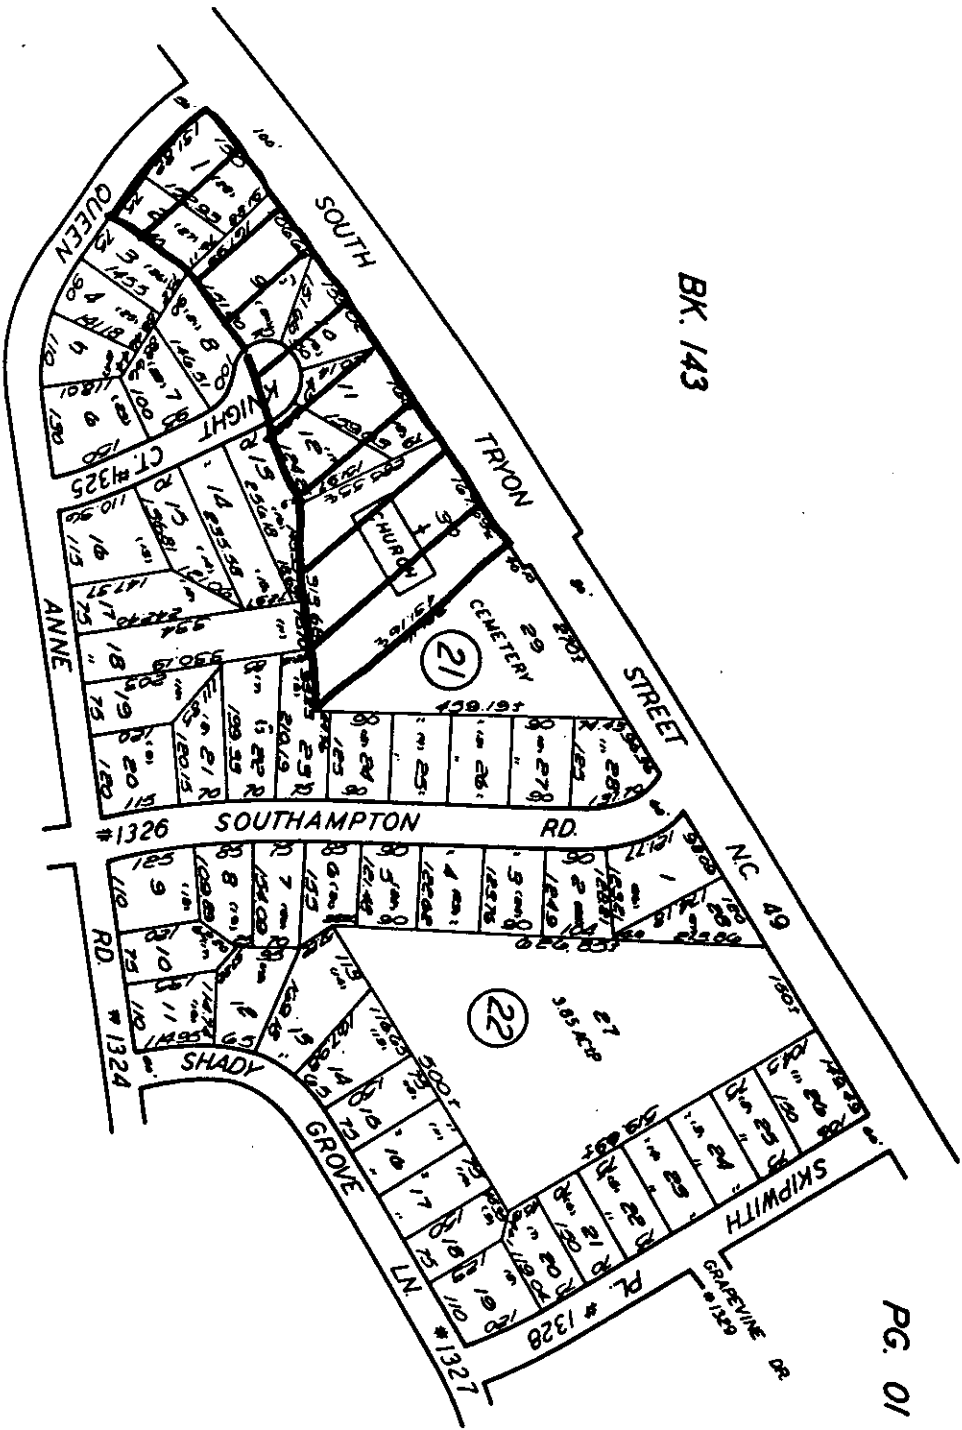


PG. 04

BK. 143


PG. 01

PG. 03

TAX LINE MAP BOOK 167 PAGE 02  
 MECKLENBURG COUNTY, NORTH CAROLINA  
 REVISED 11-72 SCALE 1" = 200'

 O-6 to ~~RE-4~~ adjacent owners


107-04

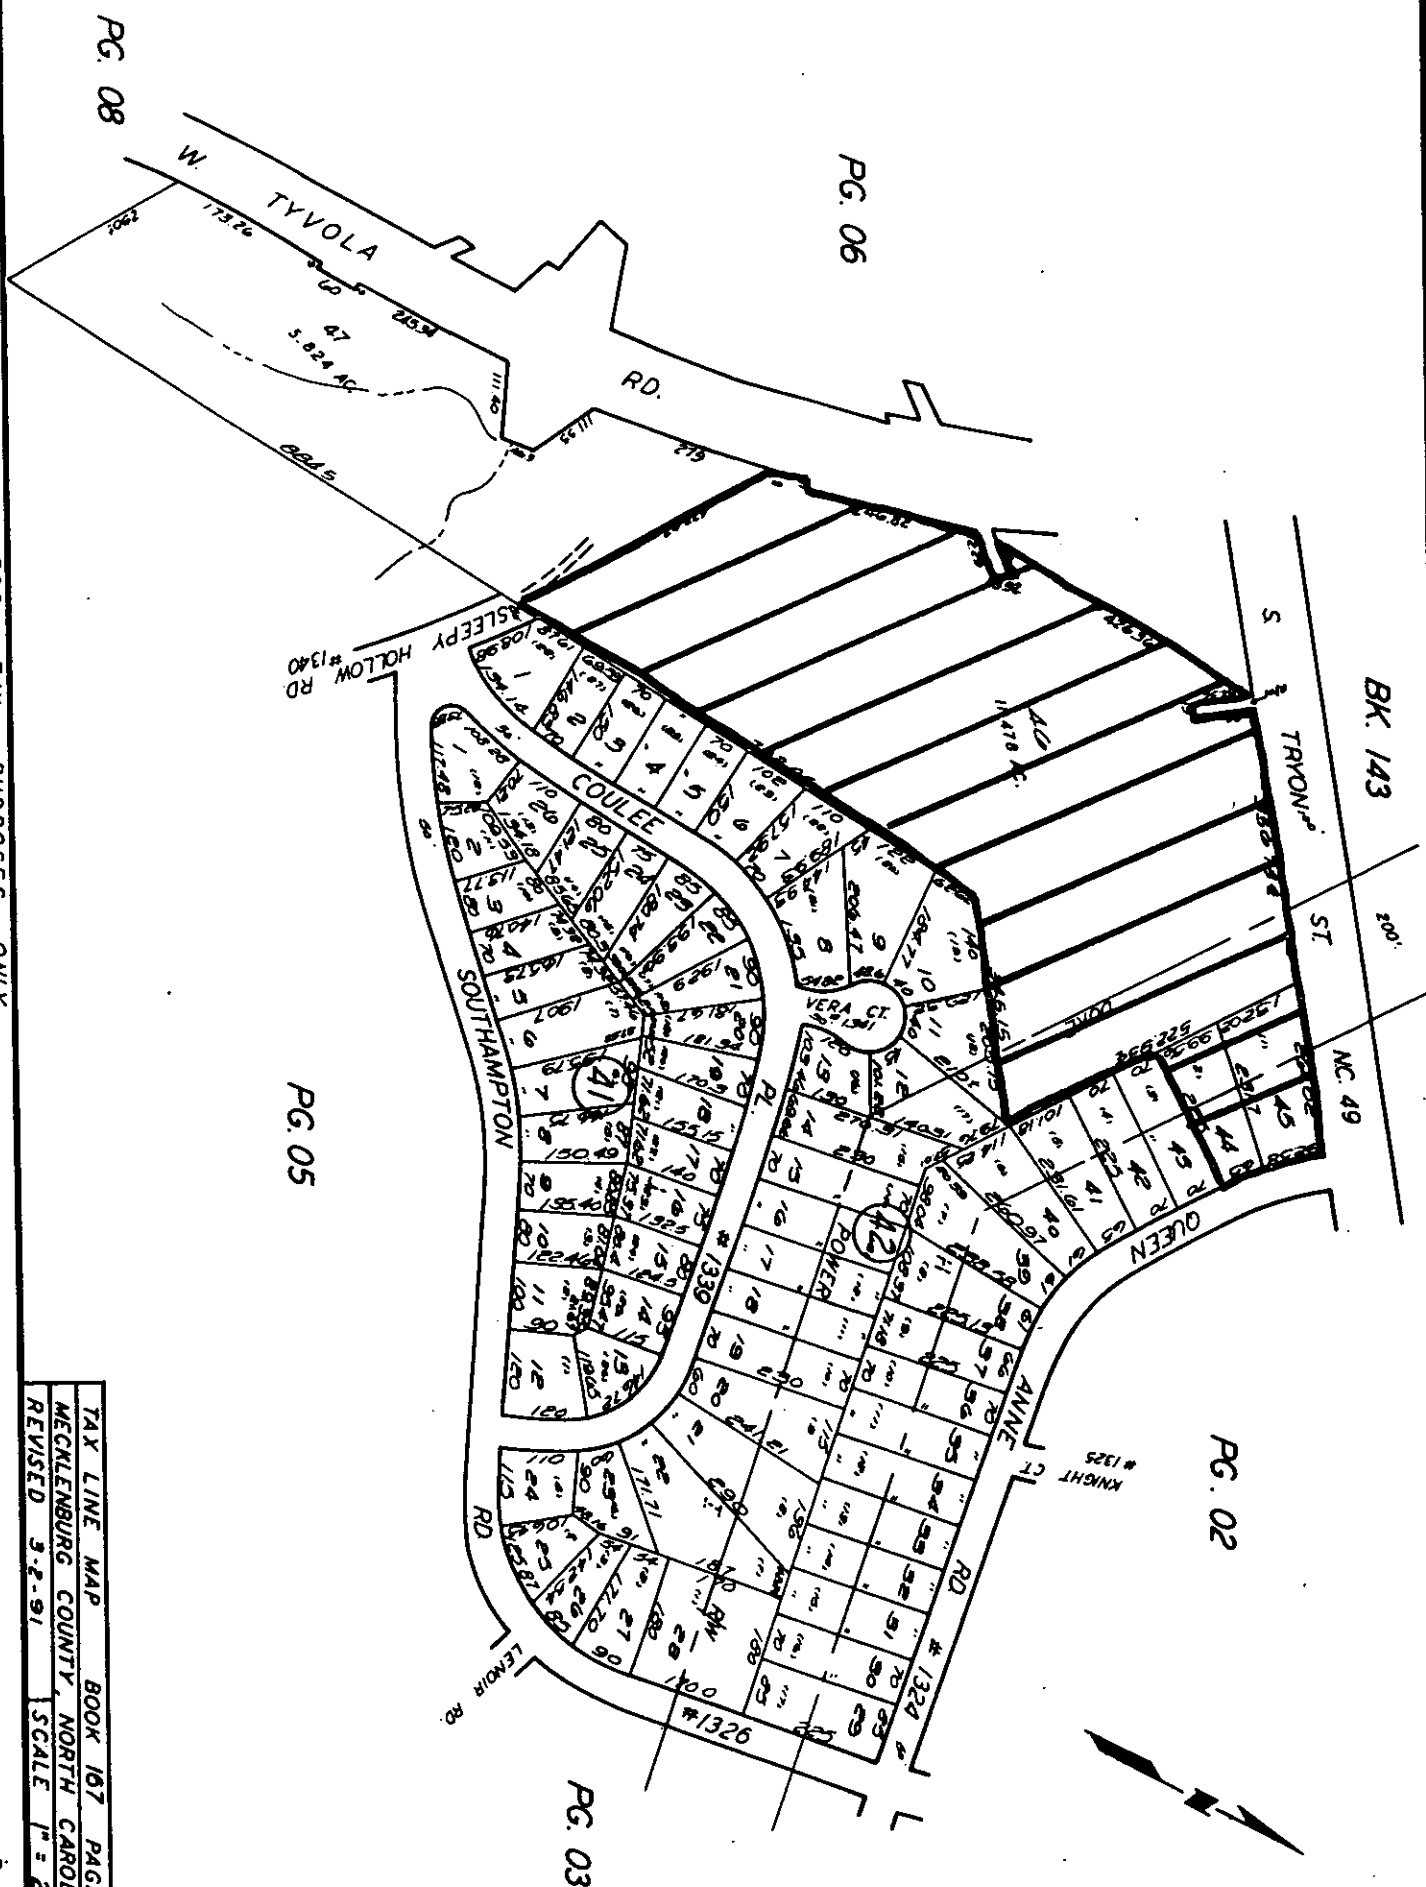

FOR TAX PURPOSES ONLY

TAX LINE MAP	BOOK 167	PAGE 04
MECKLENBURG COUNTY, NORTH CAROLINA		
REVISED 3-2-91	SCALE 1" = 200'	

 O-6 to ~~R-4~~ adjacent owners

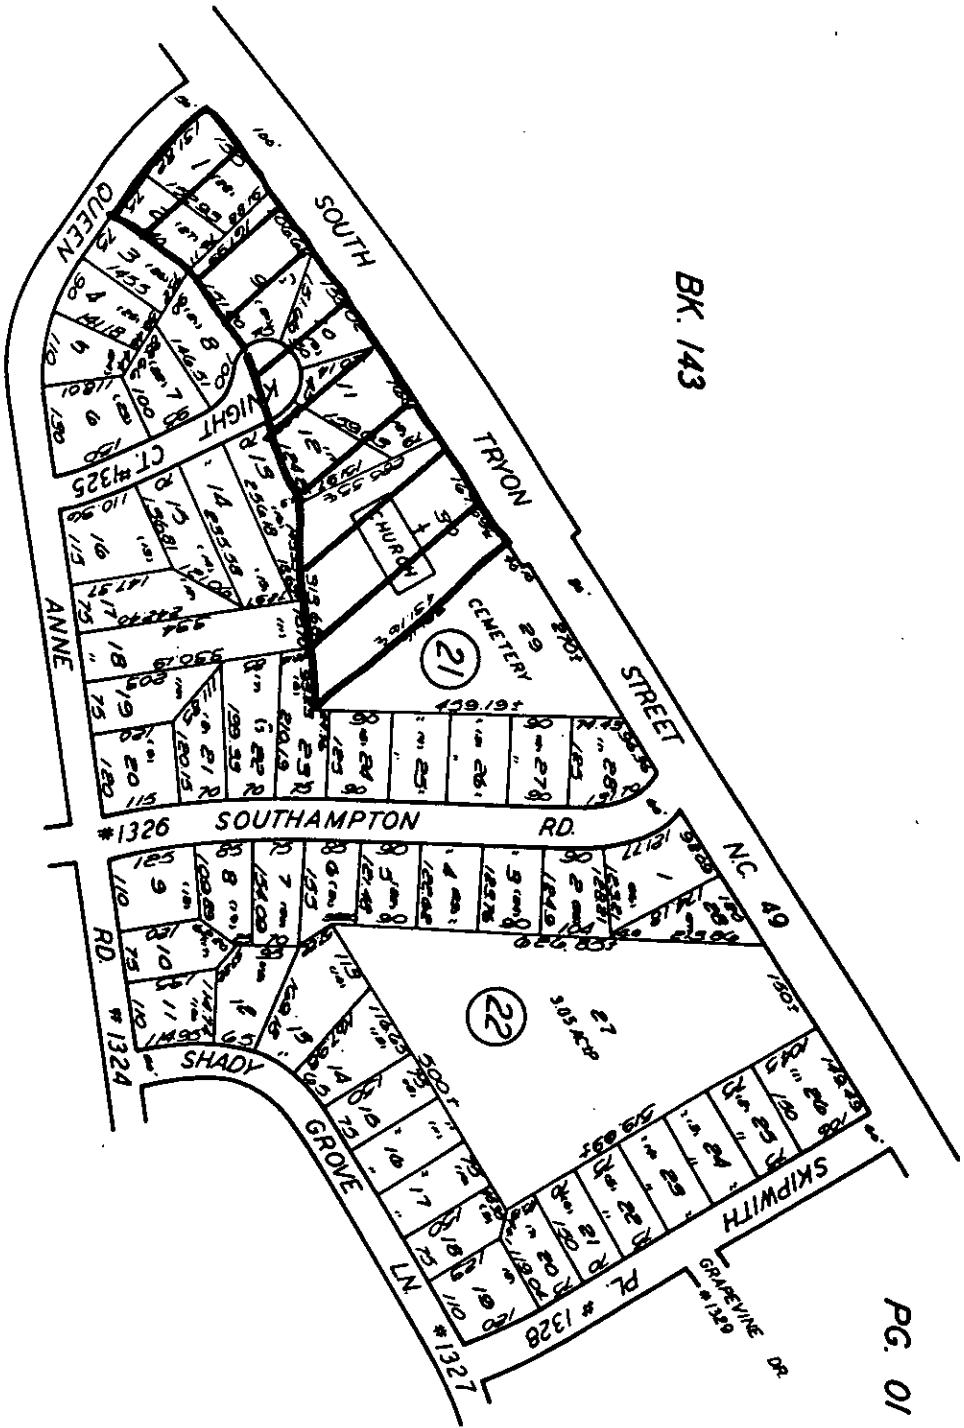

BK. 143

PG. 04

PG. 01

PG. 03

TAX LINE MAP BOOK 167 PAGE 02  
MECKLENBURG COUNTY, NORTH CAROLINA  
REVISED 1/1/2007 SCALE 1" = 200'