Development Conditions

General Provisions

く

Unless more stringent standards are established by the Technical Data Sheet or these Development Standards, all development standards established under the Mecklenburg County Zoning Ordinance (the "Ordinance") 0-1 zoning district classification shall be followed in connection with development taking place on the Site. m

Design Concept

In keeping with the design guidelines outlined in the draft of the Northeastern Plan, the plan shall provide for an interconnected street network with connections to other parcels and shall be designed so as to be pedestrian and transit friendly.

Permitted Uses

The Site may be developed to general or medical, or bank use (including any accessory use) which is permitted under the Ordinance by right or under prescribed conditions in an O-1 Zoning District.

Square Footage Restrictions

The gross floor area of all buildings constructed within the Site may not exceed, in the aggregate, 249,000 square feet.

Buffers

6.

- Buffer areas established on this Technical Data Sheet shall conform to the standards of Section 12.302 of the Ordinance; subject, however, to the provisions of Section 12.304 thereof.
- No buildings, parking spaces, maneuvering areas or storm water detention facilities may be located within buffer areas
- Where existing trees and natural vegetation have been cleared to accommodate pedestrian sidewalks or pathways or the installation of utilities, the cleared, unimproved areas will be landscaped with trees and shrubs.
- In the event the buffer requirements depicted on this technical plan should change or be eliminated then any such buffer area depicted on this plan may be reduced or eliminated accordingly.

Petitioner reserves the right to reduce buffer widths, per ordinance, with the use of screening or berms.

Setbacks, Side Yards and Rear Yards

- All buildings constructed within the Site shall satisfy or exceed the rear yard and side yard requirements established under the Ordinance for the O-1 Zoning District.
- A 40-foot building and parking setback will be established along Mallard Creek Road, all as depicted on the Technical Data Sheet. 2.
- Stormwater detention facilities may not be located within any setback area.
- £4.) Trees 6" caliper and greater with in Galloway and Mallard Creek Road setbacks shall be preserved and tree protection fences shall be provided.

Screening and Landscaped Areas

- Landscaped areas will be planted and improved in sequences, which are keyed to each phase of development taking place on the Site.
- Plantings within landscaped areas will meet or exceed the requirements of the Ordinance. 2.
- Screening shall conform with the standards and treatments specified in Section 12.303 of the Ordinance. 3.
- All trees within the setback which are 6 inches or larger in caliper will be preserved and a 5-foot wide sidewalk with an 8-foot planting strip will be provided along Mallard Creek Road.

Parking

Off street parking spaces will satisfy the minimum chanards established under the Ordinance.


Lighting

4


- All freestanding lighting fixtures installed within the Site will be uniform in design.
- The maximum height of any freestanding lighting fixture, including its base, shall not exceed 20 feet in height. No wall pack type lighting fixtures will be allowed.
- All direct lighting within the Site (except streetlights, which may be erected along Mallard Creek Road,) shall be designed such that direct illumination does not extend past any property line. Consideration will be given to the impact of lighting both within and without the perimeter of the Site. Items for consideration will include intensity, cutoff angles, color, energy efficiency and shielding of sources of light, the intent being to eliminate glare towards Mallard Creek Road and adjacent properties. 3.

- a side.

1.	Storm water runoff from the Site will be managed through j imposed by the Mecklenburg County Engineering Departmer
2.3	No storm water detention shall be within designated buffers of
Public	Road Improvements
T	Petitioner shall install a 5-foot sidewalk and an 8-foot plantin Road.

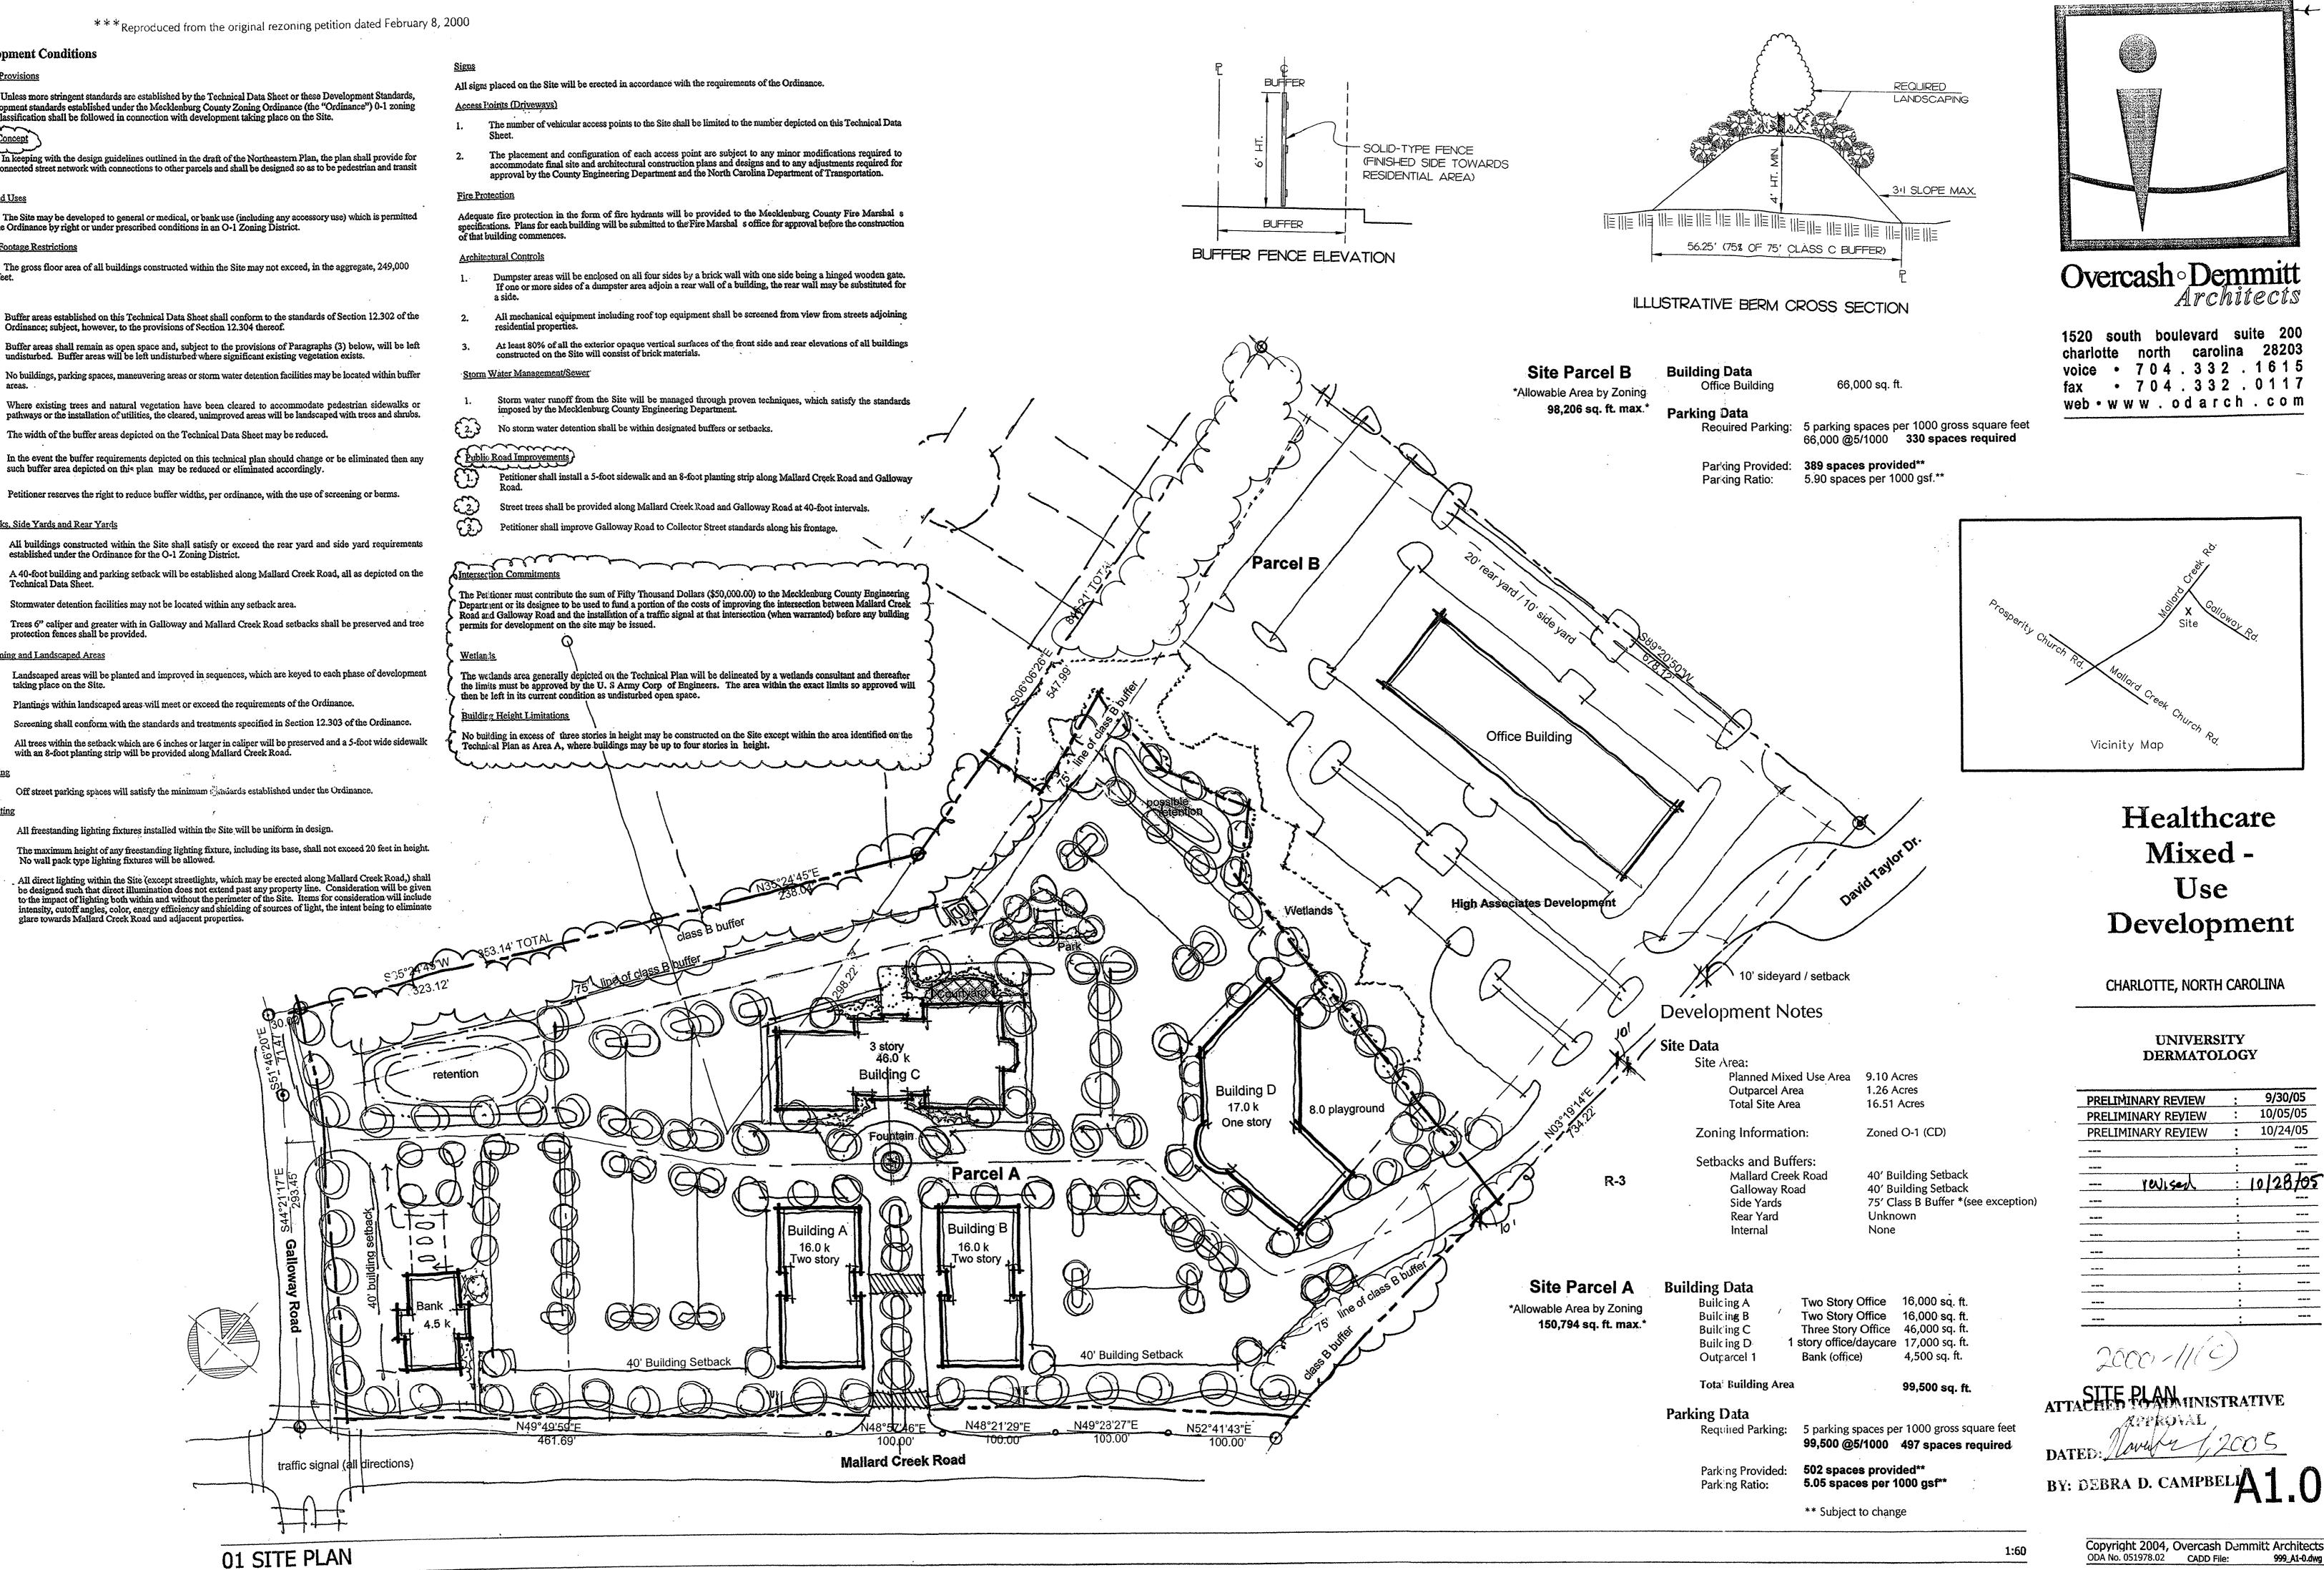

Copyright 2004, Overcash Demmitt Architects 999_A1-0.dwg

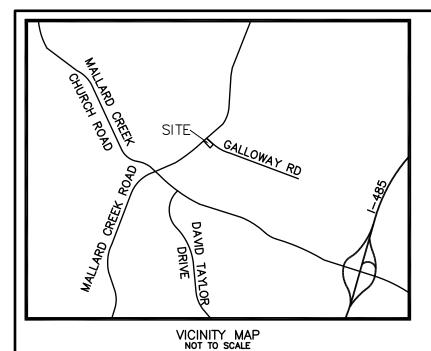

DEVELOPMENT CONDITIONS (PETITION #2000-011C):

GENERAL PROVISIONS UNLESS MORE STRINGENT STANDARDS ARE ESTABLISHED BY THE TECHNICAL DATA SHEET OR THESE DEVELOPMENT STANDARDS, ALL DEVELOPMENT STANDARDS ESTABLISHED UNDER THE MECKLENBURG COUNTY ZONING ORDINANCE (THE

"ORDINANCE") 0-1 ZONING DISTRICT CLASSIFICATION SHALL BE FOLLOWED IN CONNECTION WITH DEVELOPMENT TAKING PLACE ON THE SITE. DESIGN CONCEPT

DESIGN CONCEPT

IN KEEPING WITH THE DESIGN GUIDELINES OUTLINED IN THE DRAFT OF THE NORTHEASTERN PLAN, THE PLAN SHALL PROVIDE FOR AN INTERCONNECTED STREET NETWORK WITH CONNECTIONS TO OTHER PARCELS AND SHELL BE DESIGNED SO AS TO BE PEDESTRIAN AND TRANSIT FRIENDLY.

PERMITTED USES

THE SITE MAY BE DEVELOPED TO GENERAL OR MEDICAL, OR BACK USE (INCLUDING ANY ACCESSORY USE) WHICH IS PERMITTED UNDER PRESCRIBED CONDITIONS IN AN 0-1 ZONING DISTRICT.

SQUARE FOOTAGE RESTRICTIONS

THE GROSS FLOOR AREA OF ALL BUILDINGS CONSTRUCTED WITHIN THE SITE MAY NOT EXCEED, IN THE AGGREGATE, 249,000 SQUARE FEET.

BUFFERS

1. BUFFER AREAS ESTABLISHED ON THIS TECHNICAL DATA SHEET SHALL CONFORM TO THE STANDARDS OF SECTION 12.302 OF THE ORDINANCE; SUBJECT; HOWEVER, TO THE PROVISIONS OF SECTION 12.304 THEREOF. 2. BUFFER AREAS SHALL REMAIN AS OPEN SPACE AND, SUBJECT TO THE PROVISIONS OF PARAGRAPHS (3) BELOW, WILL BE LEFT UNDISTURBED. BUFFER AREAS WILL BE LEFT UNDISTURBED WHERE SIGNIFICANT EXISTING VEGETATION EXISTS. 3. NO BUILDINGS, PARKING SPACES, MANEUVERING AREAS OR STORM WATER DETENTION FACILITIES MAY BE LOCATED WITHIN BUFFER AREAS. 4. WHERE EXISTING TREES AND NATURAL VEGETATION HAVE BEEN CLEARED TO ACCOMMODATE PEDESTRIAN SIDEWALKS OR PATHWAYS OR THE INSTALLATION OF UTILITIES, THE CLEARED, UNIMPROVED AREAS WILL BE LANDSCAPED WITH TREES AND

SHRUBS. 5. THE WIDTH OF THE BUFFER AREAS DEPICTED ON THE TECHNICAL DATA SHEET MAY BE REDUCED.

6. IN THE EVENT THE BUFFER REQUIREMENTS DEPICTED ON THIS TECHNICAL PLAN SHOULD CHANGE OR BE ELIMINATED THEN ANY SUCH BUFFER AREA DEPICTED ON THIS PLAN MAY BE REDUCED OR ELIMINATED ACCORDINGLY. 7. PETITIONER RESERVES THE RIGHT TO REDUCE BUFFER WIDTHS, PER ORDINANCE, WITH THE USE OF SCREENING OR BERMS. SETBACKS, SIDE YARDS AND REAR YARDS

1. ALL BUILDINGS CONSTRUCTED WITHIN THE SITE SHALL OR EXCEED THE REAR YARD AND SIDE YARD REQUIREMENTS ESTABLISHED UNDER THE ORDINANCE FOR THE 0-1 ZONING DISTRICT. A 40 FOOT BUILDING AND PARKING SETBACK WILL BE ESTABLISHED ALONG MALLARD CREEK ROAD, ALL AS DEPICTED ON

HE TECHNICAL DATA SHEET STORM WATER DETENTION FACILITIES MAY NOT BE LOCATED WITHIN ANY SETBACK AREA.

TREES 6" CALIPER AND GREATER WITH IN GALLOWAY AND MALLARD CREEK ROAD SETBACKS SHELL BE PRESERVED AND TREE PROTECTION FENCES SHALL BE PROVIDED.

SCREENING AND LANDSCAPED AREAS

1. LANDSCAPED AREAS WILL BE PLANTED AND IMPROVED IN SEQUENCES, WHICH ARE KEYED TO EACH PHASE OF DEVELOPMENT TAKING PLACE ON THE SITE. PLANTINGS PLACE ON THE SHE.
PLANTINGS WITHIN LANDSCAPED AREAS WILL MEET OR EXCEED THE REQUIREMENTS OF THE ORDINANCE.
SCREENING SHALL CONFORM WITH THE STANDARDS AND TREATMENTS SPECIFIED IN SECTION 12.303 OF THE ORDINANCE.
ALL TREES WITHIN THE SETBACK WHICH ARE 6 INCHES OR LARGER IN CALIPER WILL BE PRESERVED AND A 5- FOOT WIDE SIDEWALK WITH AN 8-FOOT PLANTING STRIP WILL BE PROVIDED ALONG MALLARD CREEK ROAD.

PARKING

OFF STREET PARKING SPACES WILL SATISFY THE MINIMUM STANDARDS ESTABLISHED UNDER THE ORDINANCE.

<u>LIGHTING</u>

1. ALL FREESTANDING LIGHTING FIXTURES INSTALLED WITHIN THE SITE WILL BE UNIFORM IN DESIGN. THE MAXIMUM HEIGHT OF ANY FREESTANDING LIGHTING FIXTURE, INCLUDING ITS BASE, SHALL NOT EXCEED 20 FEET IN HEIGHT. NO WALL PACK TYPE LIGHTING FIXTURES WILL BE ALLOWED. 3. ALL DIRECT LIGHTING WITHIN THE SITE (EXCEPT STREETLIGHTS, WHICH MAY BE ERECTED ALONG MALLARD CREEK ROAD,) DESIGNED SUCH THAT DIRECT ILLUMINATION DOES NOT EXTEND PAST ANY PROPERTY LINE. CONSIDERATION WILL BE GIVEN TO THE IMPACT OF LIGHTING BOTH WITHIN AND WITHOUT THE PERIMETER OF THE SITE. ITEMS FOR CONSIDERATION WILL INCLUDE INTENSITY, CUTOFFS ANGLES, COLOR, ENERGY EFFICIENCY AND SHEILDING OF SOURCES OF LIGHT, THE INTENT BEING TO ELIMINATE GLARE TOWARDS MALLARD CREEK ROAD AND ADJACENT PROPERTIES. <u>SIGNS</u>

ALL SIGNS PLACED ON THE SITE WILL BE ERECTED IN ACCORDANCE WITH THE REQUIREMENTS OF THE ORDINANCE. ACCESS POINTS (DRIVEWAYS)

THE NUMBER OF VEHICULAR ACCESS POINTS TO THE SITE SHALL BE LIMITED TO THE NUMBER DEPICTED ON THIS TECHNICAL DATA SHEET. 2. THE PLACEMENT AND CONFIGURATION OF EACH ACCESS POINT ARE SUBJECT TO ANY MINOR MODIFICATIONS REQUIRED TO ACCOMMODATE FINAL SITE AND ARCHITECTURAL CONSTRUCTION PLANS AND DESIGNS AND TO ANY ADJUSTMENTS REQUIRED FOR APPROVAL BY THE COUNTY ENGINEERING DEPARTMENT AND THE NORTH CAROLINA DEPARTMENT OF TRANSPORTATION.

FIRE PROTECTION

ADEQUATE FIRE PROTECTION IN THE FORM OF FIRE HYDRANTS WILL BE PROVIDED TO THE MECKLENBURG COUNTY FIRE MARSHALL SPECIFICATIONS. PLANS FOR EACH BUILDING WILL BE SUBMITTED TO THE FIRE MARSHALL'S OFFICE FOR APPROVAL BEFORE THE CONSTRUCTION OF THAT BUILDING COMMENCES.

ARCHITECTURAL CONTROLS

DUMPSTER AREAS WILL BE ENCLOSED ON ALL FOUR SIDES BY A BRICK WALL WITH ONE SIDE BEING A HINGED WOODEN GATE. IF ONE OR MORE SIDES OF A DUMPSTER AREA ADJOIN A REAR WALL OF A BUILDING, THE REAR WALL MAY SUBSTITUTED FOR A SIDE. ALL MECHANICAL EQUIPMENT INCLUDING ROOF TOP EQUIPMENT SHALL BE SCREENED FROM VIEW FROM STREETS ADJOINING RESIDENTIAL PROPERTIES. 3. AT LEAST 80% OF ALL THE EXTERIOR OPAQUE VERTICAL SURFACES OF THE FRONT SIDE AND REAR ELEVATIONS OF BUILDING CONSTRUCTED ON THE SITE WILL CONSIST OF BRICK MATERIALS.

STORM WATER MANAGEMENT/SEWER STORM WATER RUNOFF FROM THE SITE WILL BE MANAGED THROUGH PROVEN TECHNIQUES, WHICH SATISFY THE STANDARDS

IMPOSED BY THE MECKLENBURG COUNTY ENGINEERING DEPARTMENT. 2. NO STORM WATER DETENTION SHALL BE WITHIN DESIGNATED BUFFER OR SETBACKS.

PUBIC ROAD IMPROVEMENTS

PETITIONER SHALL INSTALL A 5-FOOT SIDEWALK AND AN 8-FOOT PLANTING STRIP ALONG MALLARD CREEK ROAD AND GALLOWAY ROAD. STREET TREES SHALL BE PROVIDED ALONG MALLARD CREEK ROAD AND GALLOWAY ROAD AT 40-FOOT INTERVALS. PETITIONER SHALL IMPROVE GALLOWAY ROAD TO COLLECTOR STREET STANDARDS ALONG HIS FRONTAGE.

INTERSECTION COMMITMENTS

THE PETITIONER MUST CONTRIBUTE THE SUM OF FIFTY THOUSAND DOLLARS (\$50,000.00) TO THE MECKLENBURG COUNTY ENGINEERING DEPARTMENT OR ITS DESIGNEE TO BE USED TO FUND A PORTION OF THE COSTS OF IMPROVING THE INTERSECTION BETWEEN MALLARD CREEK ROAD AND GALLOWAY ROAD AND THE INSTALLATION OF A TRAFFIC SIGNAL AT THAT INTERSECTION (WHEN WARRANTED) BEFORE ANY BUILDING PERMITS FOR DEVELOPMENT ON THE SITE MAY BE ISSUED. WETLANDS

THE WETLANDS AREA GENERALLY DEPICTED ON THE TECHNICAL PLAN WILL BE DELINEATED BY A WETLANDS CONSULTANT AND THEREAFTER THE LIMITS MUST BE APPROVED BY THE U.S. ARMY CORP OF ENGINEERS. THE AREA WITHIN THE EXACT LIMITS SO APPROVED WILL THEN BE LEFT IN ITS CURRENT CONDITION AS UNDISTURBED OPEN SPACE. BUILDING HEIGHT LIMITATIONS

NO BUILDING IN EXCESS OF THREE STORIES IN HEIGHT MAY BE CONSTRUCTED ON THE SITE EXCEPT WITHIN THE AREA IDENTIFIED ON THE TECHNICAL PLAN AS AREA A, WHERE BUILDINGS MAY BE UP TO FOUR STORIES IN HEIGHT.

THE GODDARD SCHOOL MALLARD CREEK RD., CHARLOTTE, NC

Provide a chart for the parking calculations

6


 \odot

0

 \odot

Building will need to be pulled to the 40 foot building setback line per the last adminstrative


_____ 30 _____ 30 _____

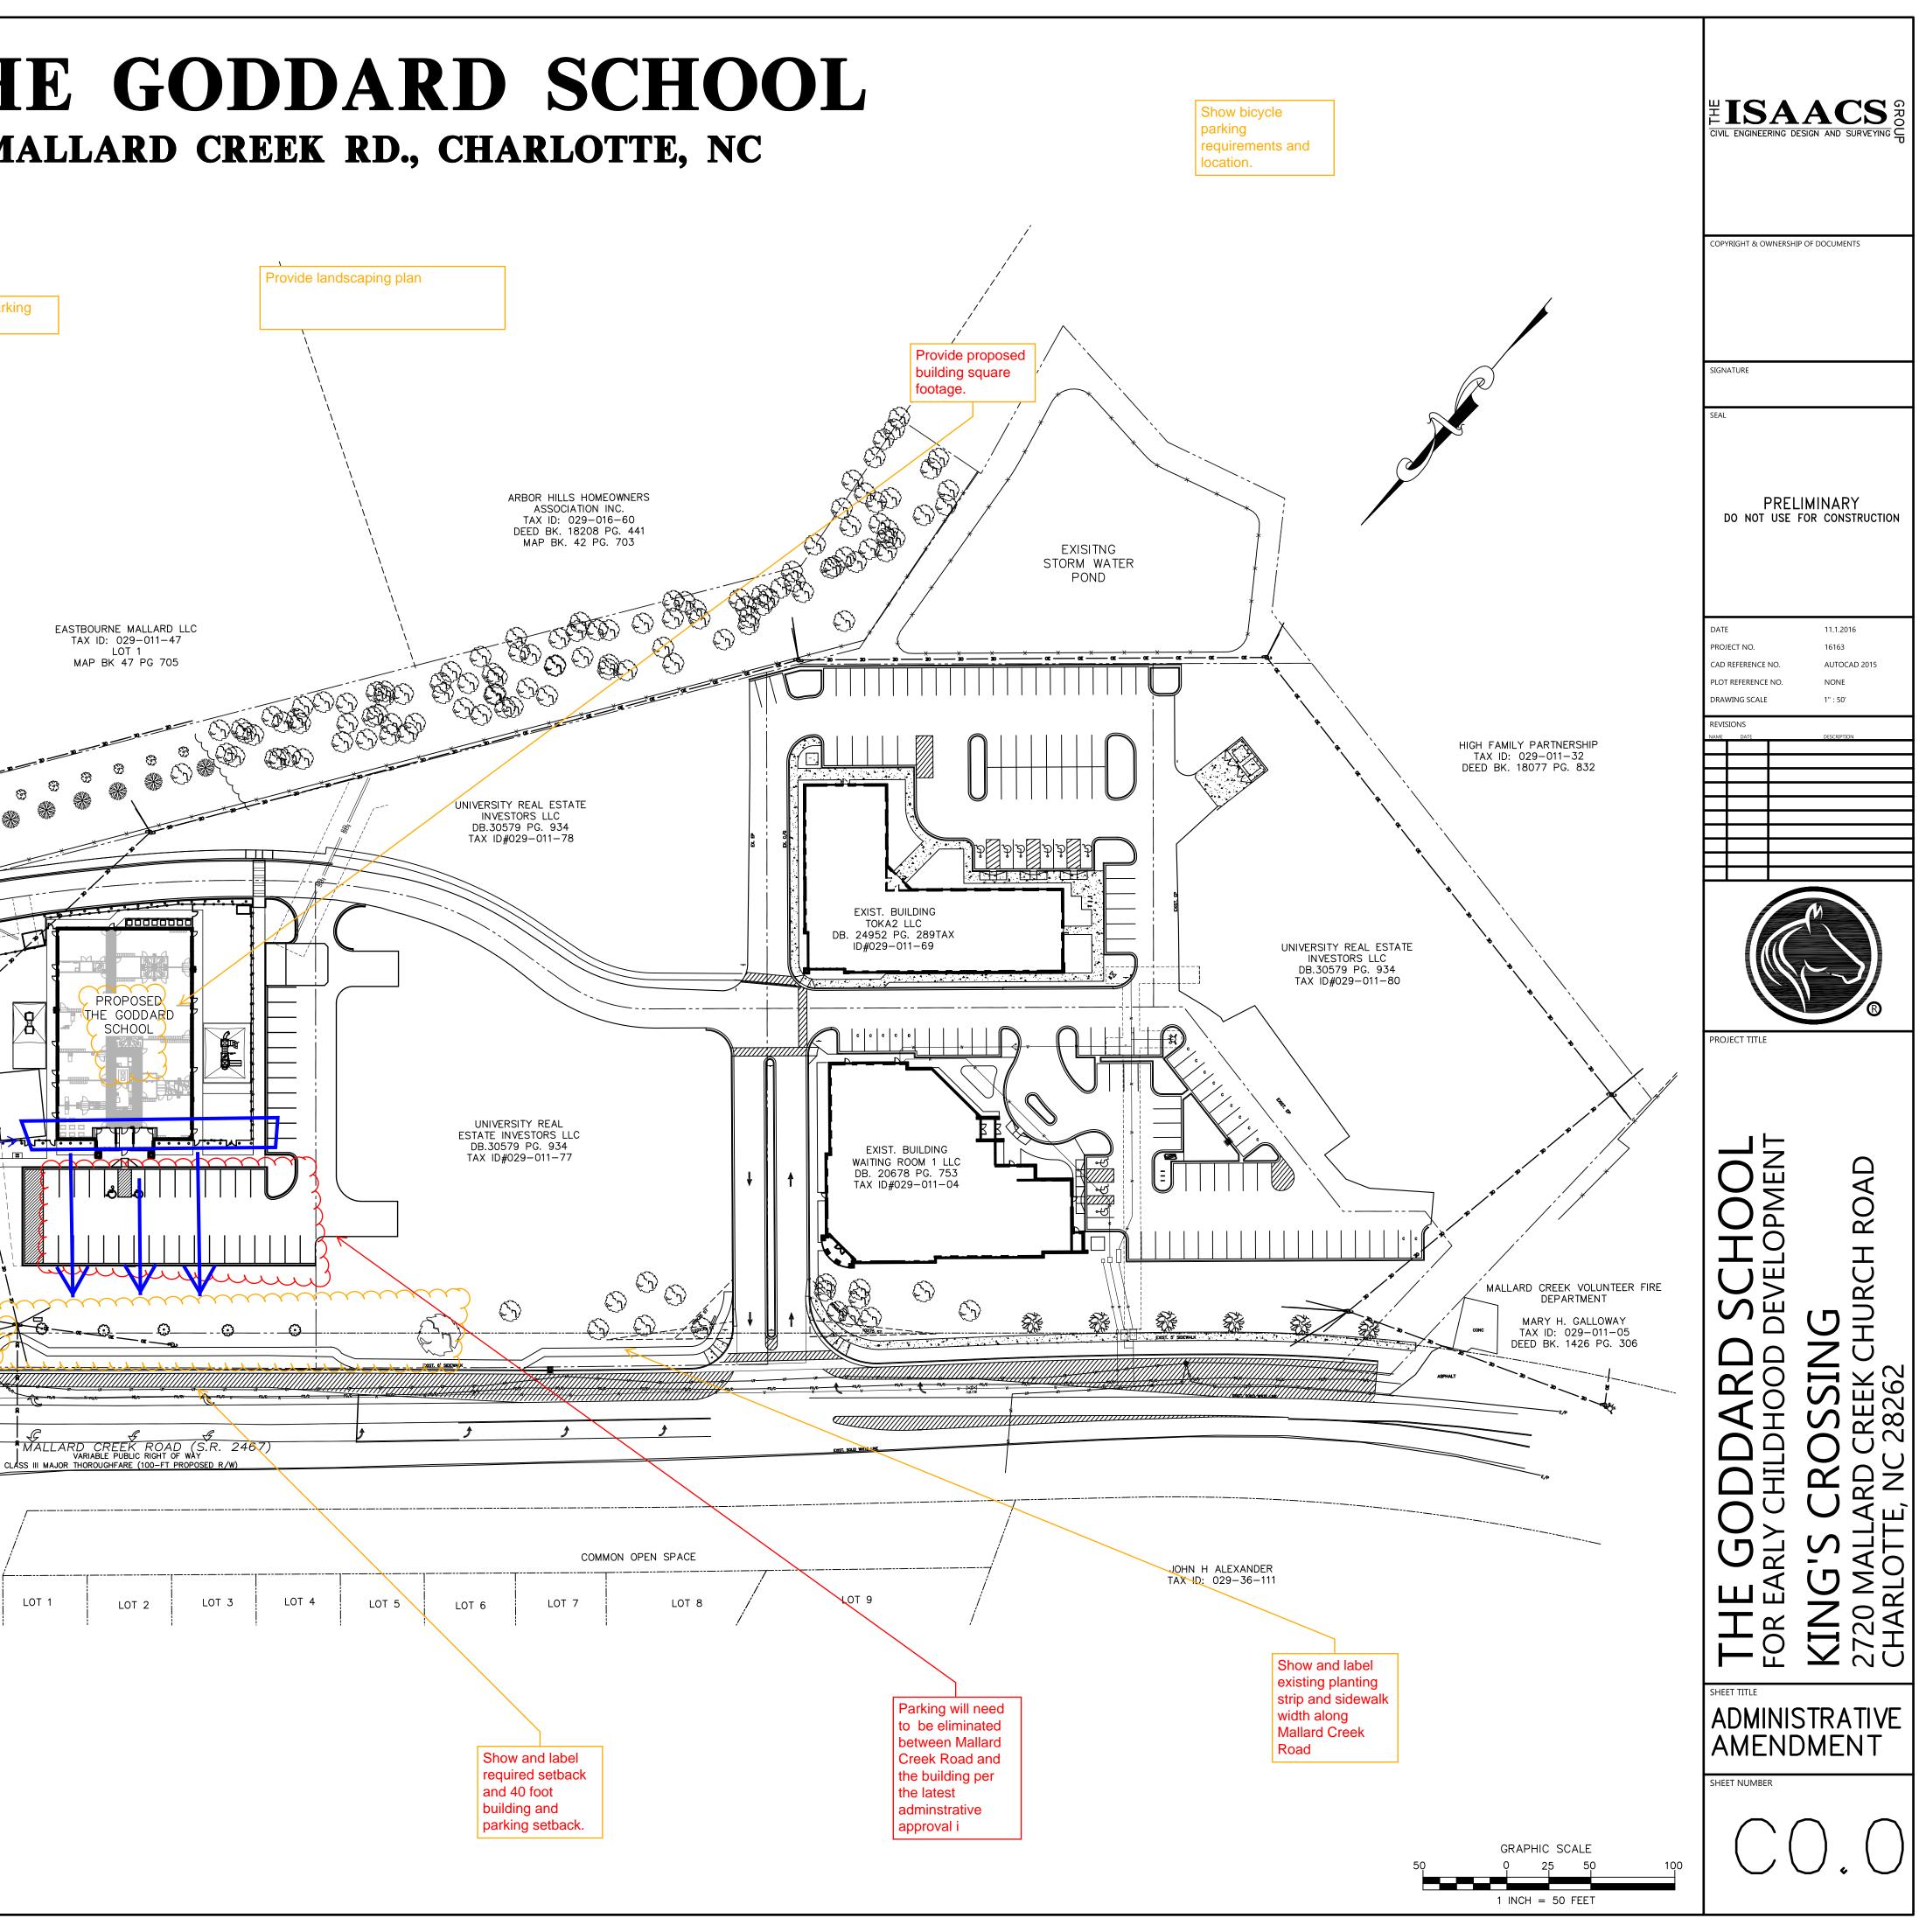


Label building height for each elevation.

brick for each elevation per conditional note 3 Under Architectural Controls.

Provide Dumpster enclosure detail

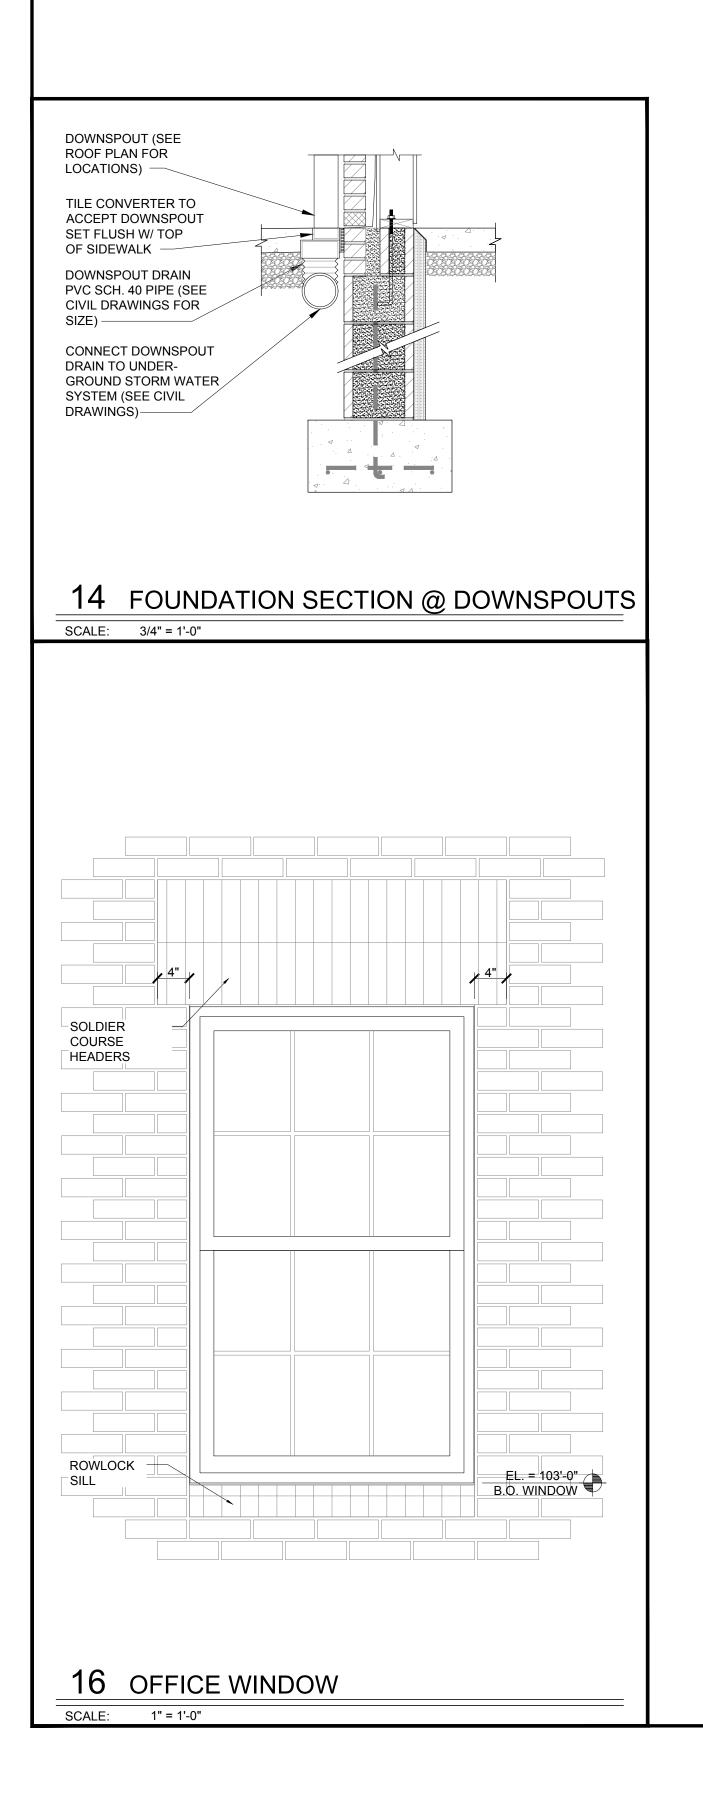

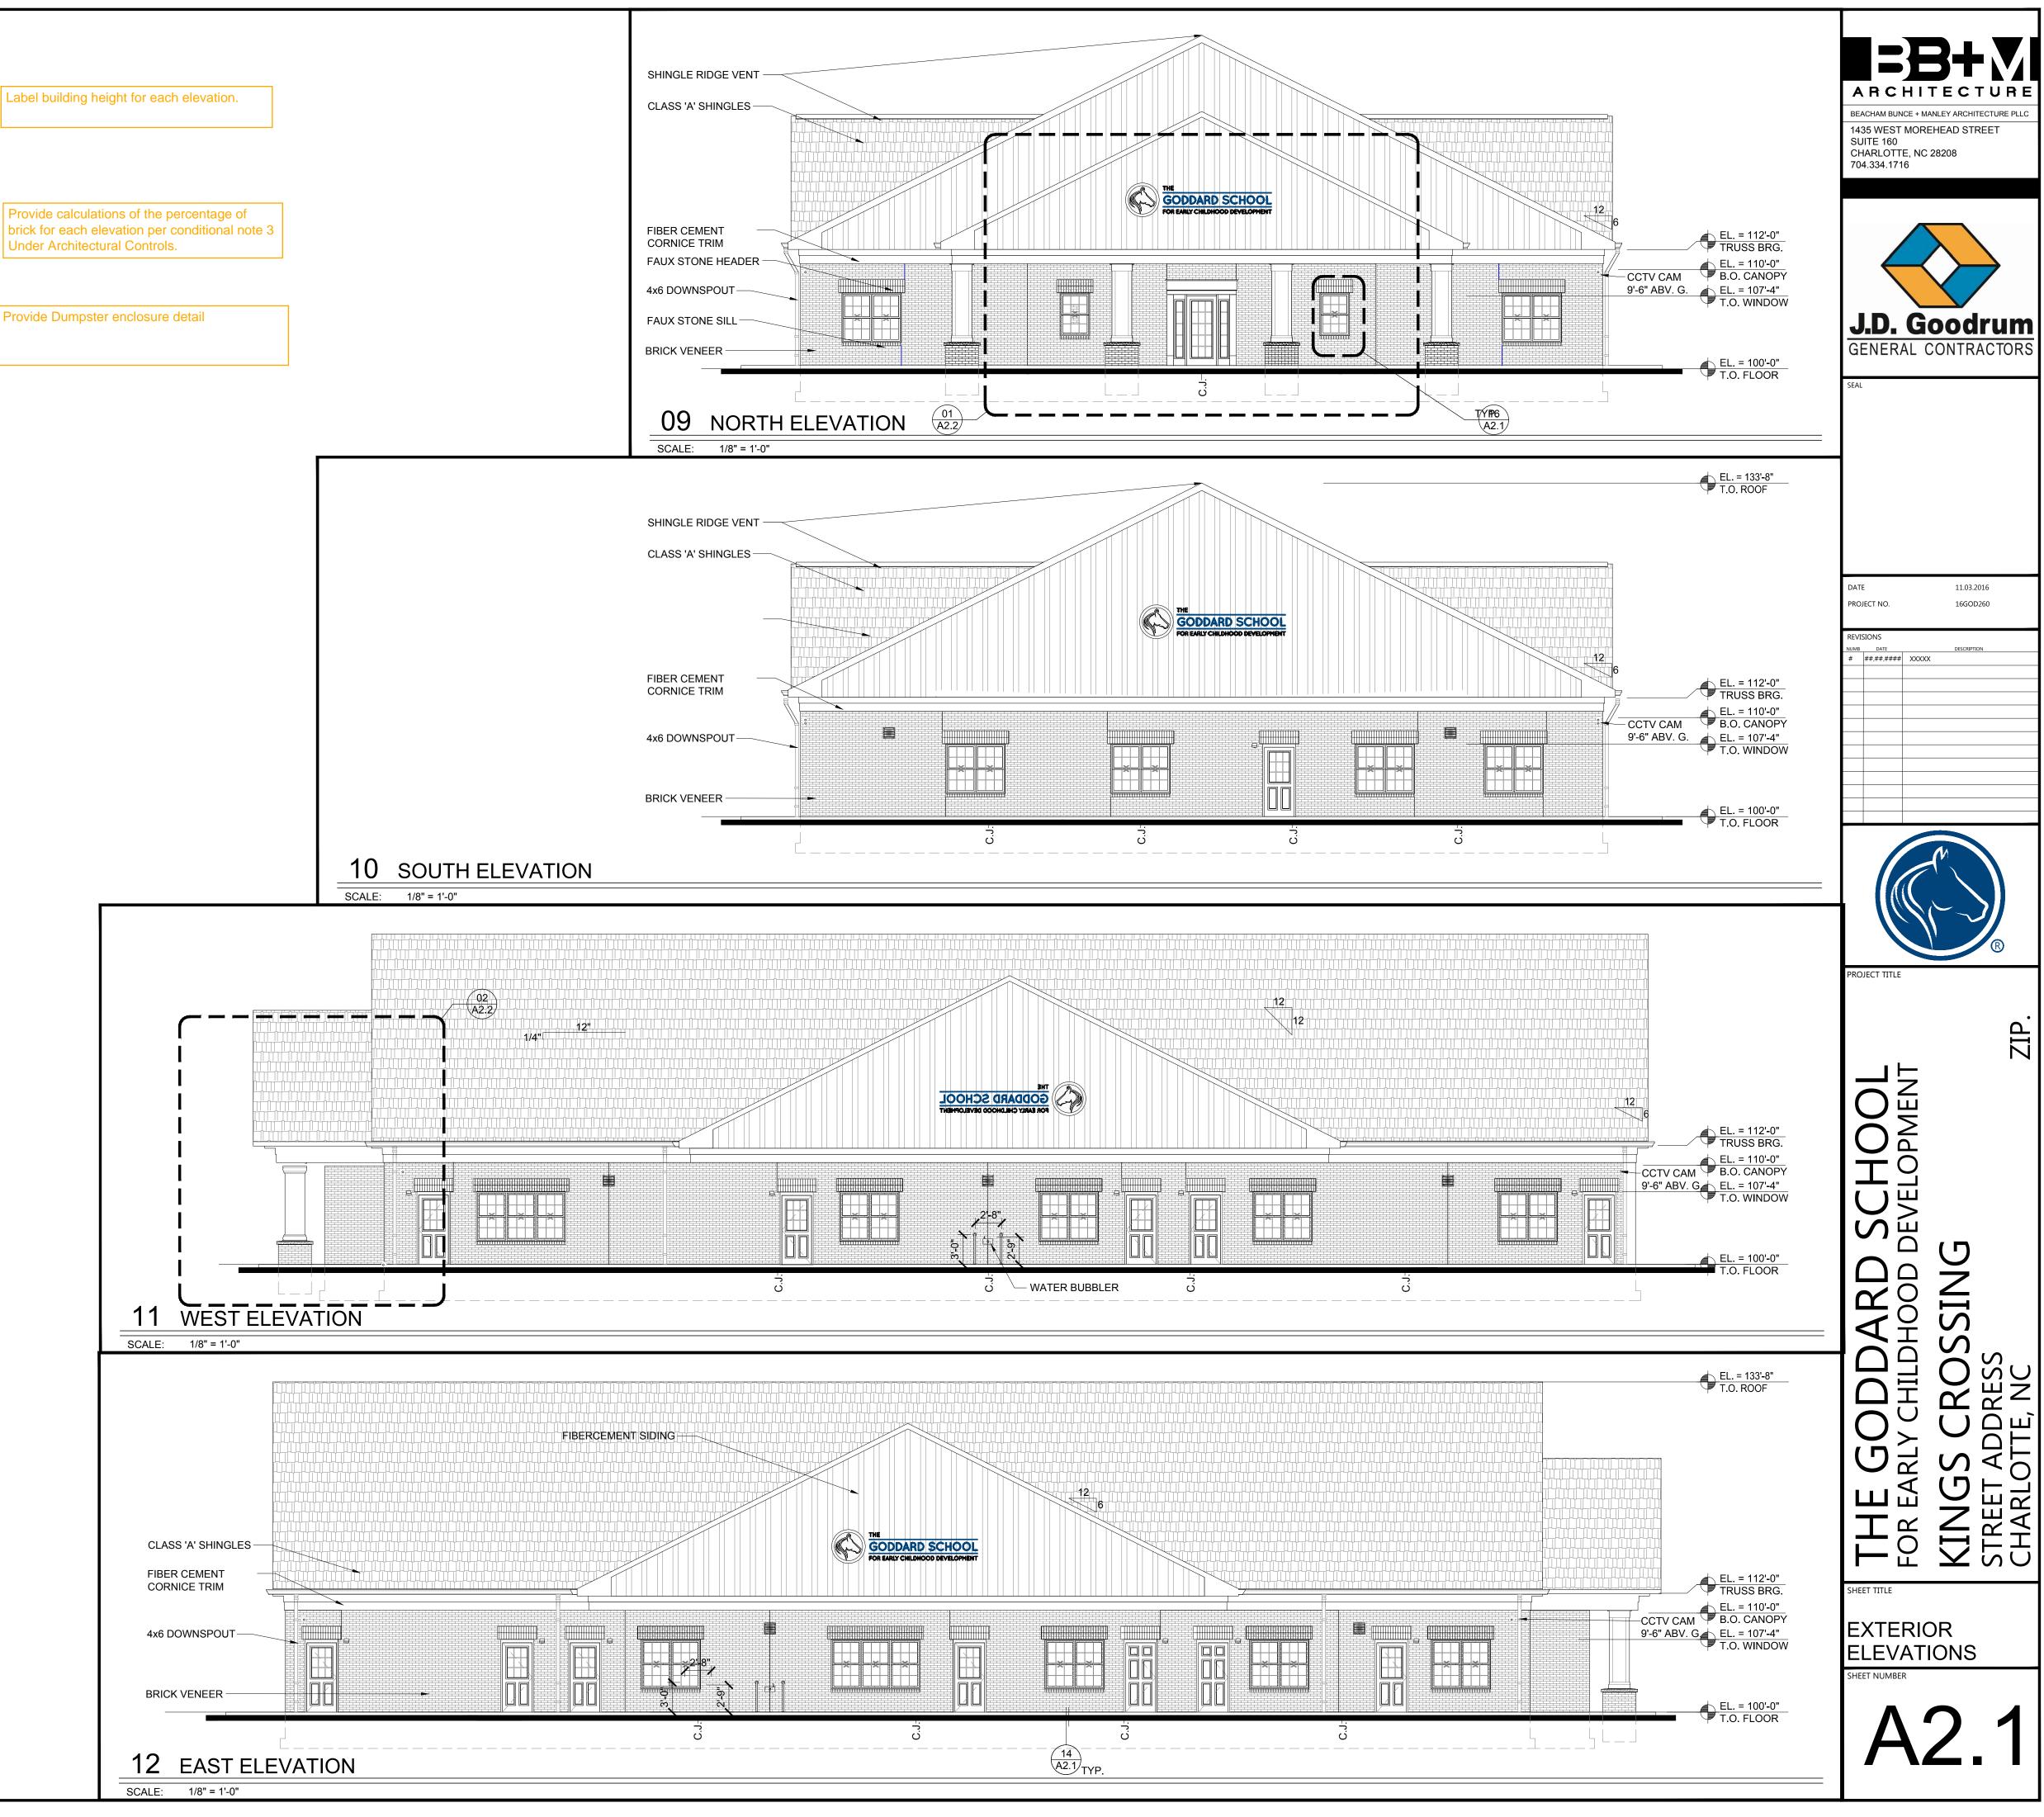



Charlotte-Mecklenburg Planning Department

DATE: February 2, 2017

TO: Donald Moore Zoning Supervisor

FROM:

Ed McKinney Interim, Planning Director

SUBJECT: Administrative Approval for Petition No. 2000-011C Dallas Merle King

Attached is the revised site plan for the petition above. This request allows the modification of the proposed site plan as listed below. Since these changes do not alter the intent of the development and meets the requirements of the Charlotte Zoning Ordinance Section 6.207 <u>Alterations to Approval</u>, minor changes, I am administratively approving this plan. Please use these plans when evaluating requests for building permits and certificates of occupancy.

- To allow the development of a childcare center (Goddard School)
- Building elevations
- Landscaping Plan

Reasons for Staff's support of the request:

• The site plan complies with the conditional notes and still meets the intent of the approved site plan by the County Commissioners.


Note: All other Zoning, Subdivision, Tree Ordinances, Building Codes, and conditional requirements still apply.

Signage was not reviewed as part of this request.

CHARLOTTE-MECKLENBURG PLANNING DEPARTMENT

www.charmeck.org

600 East Fourth Street Charlotte, NC 28202-2853 PH: (704)-336-2205 FAX: (704)-336-5123

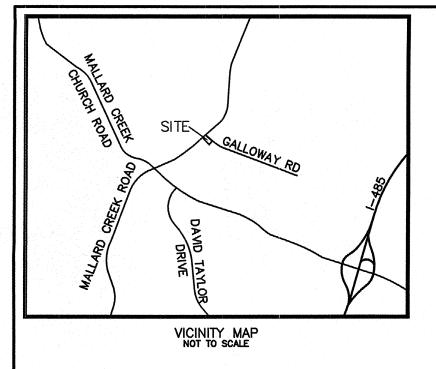

DEVELOPMENT CONDITIONS (PETITION #2000-011C):

<u>GENERAL PROVISIONS</u> UNLESS MORE STRINGENT STANDARDS ARE ESTABLISHED BY THE TECHNICAL DATA SHEET OR THESE DEVELOPMENT STANDARDS, ALL DEVELOPMENT STANDARDS ESTABLISHED UNDER THE MECKLENBURG COUNTY ZONING ORDINANCE (THE "ORDINANCE") 0-1 ZONING DISTRICT CLASSIFICATION SHALL BE FOLLOWED IN CONNECTION WITH DEVELOPMENT TAKING PLACE ON THE SITE.

DESIGN CONCEPT

PERMITTED USES

IN KEEPING WITH THE DESIGN GUIDELINES OUTLINED IN THE DRAFT OF THE NORTHEASTERN PLAN, THE PLAN SHALL PROVIDE FOR AN INTERCONNECTED STREET NETWORK WITH CONNECTIONS TO OTHER PARCELS AND SHELL BE DESIGNED SO AS TO BE PEDESTRIAN AND TRANSIT FRIENDLY.

THE SITE MAY BE DEVELOPED TO GENERAL OR MEDICAL, OR BANK USE (INCLUDING ANY ACCESSORY USE) WHICH IS PERMITTED UNDER PRESCRIBED CONDITIONS IN AN 0-1 ZONING DISTRICT. SQUARE FOOTAGE RESTRICTIONS

THE GROSS FLOOR AREA OF ALL BUILDINGS CONSTRUCTED WITHIN THE SITE MAY NOT EXCEED, IN THE AGGREGATE, 249,000 SQUARE FEET. BUFFERS

BUFFER AREAS ESTABLISHED ON THIS TECHNICAL DATA SHEET SHALL CONFORM TO THE STANDARDS OF SECTION 12.302 OF THE ORDINANCE; SUBJECT; HOWEVER, TO THE PROVISIONS OF SECTION 12.304 THEREOF.

. BUFFER AREAS SHALL REMAIN AS OPEN SPACE AND, SUBJECT TO THE PROVISIONS OF PARAGRAPHS (3) BELOW, WILL BE LEFT UNDISTURBED. BUFFER AREAS WILL BE LEFT UNDISTURBED WHERE SIGNIFICANT EXISTING VEGETATION EXISTS.

NO BUILDINGS, PARKING SPACES, MANEUVERING AREAS OR STORM WATER DETENTION FACILITIES MAY BE LOCATED WITHIN

BUFFER AREAS WHERE EXISTING TREES AND NATURAL VEGETATION HAVE BEEN CLEARED TO ACCOMMODATE PEDESTRIAN SIDEWALKS OR PATHWAYS OR THE INSTALLATION OF UTILITIES, THE CLEARED, UNIMPROVED AREAS WILL BE LANDSCAPED WITH TREES AND SHRUBS

. THE WIDTH OF THE BUFFER AREAS DEPICTED ON THE TECHNICAL DATA SHEET MAY BE REDUCED.

EVENT THE BUFFER REQUIREMENTS DEPICTED ON THIS TECHNICAL PLAN SHOULD CHANGE OR BE ELIMINATED THEN ANY SUCH BUFFER AREA DEPICTED ON THIS PLAN MAY BE REDUCED OR ELIMINATED ACCORDINGLY.

PETITIONER RESERVES THE RIGHT TO REDUCE BUFFER WIDTHS, PER ORDINANCE, WITH THE USE OF SCREENING OR BERMS. SETBACKS, SIDE YARDS AND REAR YARDS

ALL BUILDINGS CONSTRUCTED WITHIN THE SITE SHALL OR EXCEED THE REAR YARD AND SIDE YARD REQUIREMENTS ESTABLISHED UNDER THE ORDINANCE FOR THE 0-1 ZONING DISTRICT.

2. A 40 FOOT BUILDING AND PARKING SETBACK WILL BE ESTABLISHED ALONG MALLARD CREEK ROAD, ALL AS DEPICTED ON THE TECHNICAL DATA SHEET.

. STORM WATER DETENTION FACILITIES MAY NOT BE LOCATED WITHIN ANY SETBACK AREA.

TREES 6" CALIPER AND GREATER WITH IN GALLOWAY AND MALLARD CREEK ROAD SETBACKS SHELL BE PRESERVED AND TREE PROTECTION FENCES SHALL BE PROVIDED.

SCREENING AND LANDSCAPED AREAS

LANDSCAPED AREAS WILL BE PLANTED AND IMPROVED IN SEQUENCES, WHICH ARE KEYED TO EACH PHASE OF DEVELOPMENT TAKING PLACE ON THE SITE.

2. PLANTINGS WITHIN LANDSCAPED AREAS WLL MEET OR EXCEED THE REQUIREMENTS OF THE ORDINANCE

. SCREENING SHALL CONFORM WITH THE STANDARDS AND TREATMENTS SPECIFIED IN SECTION 12.303 OF THE ORDINANCE. 4. ALL TREES WITHIN THE SETBACK WHICH ARE 6 INCHES OR LARGER IN CALIPER WILL BE PRESERVED AND A 5- FOOT WIDE SIDEWALK WITH AN 8-FOOT PLANTING STRIP WILL BE PROVIDED ALONG MALLARD CREEK ROAD. PARKING

OFF STREET PARKING SPACES WILL SATISFY THE MINIMUM STANDARDS ESTABLISHED UNDER THE ORDINANCE.

<u>SIGNS</u>

LIGHTING

. ALL FREESTANDING LIGHTING FIXTURES INSTALLED WITHIN THE SITE WILL BE UNIFORM IN DESIGN.

THE MAXIMUM HEIGHT OF ANY FREESTANDING LIGHTING FIXTURE, INCLUDING ITS BASE, SHALL NOT EXCEED 20 FEET IN HEIGHT. NO WALL PACK TYPE LIGHTING FIXTURES WILL BE ALLOWED.

3. ALL DIRECT LIGHTING WITHIN THE SITE (EXCEPT STREETLIGHTS, WHICH MAY BE ERECTED ALONG MALLARD CREEK ROAD,) SHALL BE DESIGNED SUCH THAT DIRECT ILLUMINATION DOES NOT EXTEND PAST ANY PROPERTY LINE. CONSIDERATION WILL BE GIVEN TO THE IMPACT OF LIGHTING BOTH WITHIN AND WITHOUT THE PERIMETER OF THE SITE. ITEMS FOR CONSIDERATION WILL INCLUDE INTENSITY, CUTOFFS ANGLES, COLOR, ENERGY EFFICIENCY AND SHIELDING OF SOURCES OF LIGHT, THE INTENT BEING TO ELIMINATE GLARE TOWARDS MALLARD CREEK ROAD AND ADJACENT PROPERTIES. Θ

 \odot

 \odot

ALL SIGNS PLACED ON THE SITE WILL BE ERECTED IN ACCORDANCE WITH THE REQUIREMENTS OF THE ORDINANCE. ACCESS POINTS (DRIVEWAYS)

THE NUMBER OF VEHICULAR ACCESS POINTS TO THE SITE SHALL BE LIMITED TO THE NUMBER DEPICTED ON THIS TECHNICAL DATA SHEET

THE PLACEMENT AND CONFIGURATION OF EACH ACCESS POINT ARE SUBJECT TO ANY MINOR MODIFICATIONS REQUIRED TO ACCOMMODATE FINAL SITE AND ARCHITECTURAL CONSTRUCTION PLANS AND DESIGNS AND TO ANY ADJUSTMENTS REQUIRED FOR APPROVAL BY THE COUNTY ENGINEERING DEPARTMENT AND THE NORTH CAROLINA DEPARTMENT OF TRANSPORTATION. FIRE PROTECTION

ADEQUATE FIRE PROTECTION IN THE FORM OF FIRE HYDRANTS WILL BE PROVIDED TO THE MECKLENBURG COUNTY FIRE MARSHALL SPECIFICATIONS. PLANS FOR EACH BUILDING WILL BE SUBMITTED TO THE FIRE MARSHALL'S OFFICE FOR APPROVAL BEFORE THE CONSTRUCTION OF THAT BUILDING COMMENCES.

ARCHITECTURAL CONTROLS

DUMPSTER AREAS WILL BE ENCLOSED ON ALL FOUR SIDES BY A BRICK WALL WITH ONE SIDE BEING A HINGED WOODEN GATE. IF ONE OR MORE SIDES OF A DUMPSTER AREA ADJOIN A REAR WALL OF A BUILDING, THE REAR WALL MAY SUBSTITUTED

FOR A SIDE. 2. ALL MECHANICAL EQUIPMENT INCLUDING ROOF TOP EQUIPMENT SHALL BE SCREENED FROM VIEW FROM STREETS ADJOINING RESIDENTIAL PROPERTIES. . AT LEAST 80% OF ALL THE EXTERIOR OPAQUE VERTICAL SURFACES OF THE FRONT SIDE AND REAR ELEVATIONS OF BUILDING

CONSTRUCTED ON THE SITE WILL CONSIST OF BRICK MATERIALS. STORM WATER MANAGEMENT/SEWER

STORM WATER RUNOFF FROM THE SITE WILL BE MANAGED THROUGH PROVEN TECHNIQUES, WHICH SATISFY THE STANDARDS IMPOSED BY THE MECKLENBURG COUNTY ENGINEERING DEPARTMENT. 2. NO STORM WATER DETENTION SHALL BE WITHIN DESIGNATED BUFFER OR SETBACKS.

PUBIC ROAD IMPROVEMENTS

. PETITIONER SHALL INSTALL A 5-FOOT SIDEWALK AND AN 8-FOOT PLANTING STRIP ALONG MALLARD CREEK ROAD AND

GALLOWAY ROAD. 2. STREET TREES SHALL BE PROVIDED ALONG MALLARD CREEK ROAD AND GALLOWAY ROAD AT 40-FOOT INTERVALS. 3. PETITIONER SHALL IMPROVE GALLOWAY ROAD TO COLLECTOR STREET STANDARDS ALONG HIS FRONTAGE.

NTERSECTION COMMITMENTS


THE PETITIONER MUST CONTRIBUTE THE SUM OF FIFTY THOUSAND DOLLARS (\$50,000.00) TO THE MECKLENBURG COUNTY ENGINEERING DEPARTMENT OR ITS DESIGNEE TO BE USED TO FUND A PORTION OF THE COSTS OF IMPROVING THE INTERSECTION BETWEEN MALLARD CREEK ROAD AND GALLOWAY ROAD AND THE INSTALLATION OF A TRAFFIC SIGNAL AT THAT INTERSECTION (WHEN WARRANTED) BEFORE ANY BUILDING PERMITS FOR DEVELOPMENT ON THE SITE MAY BE ISSUED. WETLANDS


THE WETLANDS AREA GENERALLY DEPICTED ON THE TECHNICAL PLAN WILL BE DELINEATED BY A WETLANDS CONSULTANT AND THEREAFTER THE LIMITS MUST BE APPROVED BY THE U.S. ARMY CORP OF ENGINEERS. THE AREA WITHIN THE EXACT LIMITS SO APPROVED WILL THEN BE LEFT IN ITS CURRENT CONDITION AS UNDISTURBED OPEN SPACE.


BUILDING HEIGHT LIMITATIONS

NO BUILDING IN EXCESS OF THREE STORIES IN HEIGHT MAY BE CONSTRUCTED ON THE SITE EXCEPT WITHIN THE AREA IDENTIFIED ON THE TECHNICAL PLAN AS AREA A, WHERE BUILDINGS MAY BE UP TO FOUR STORIES IN HEIGHT.


THE GODDARD SCHOOL MALLARD CREEK RD., CHARLOTTE, NC

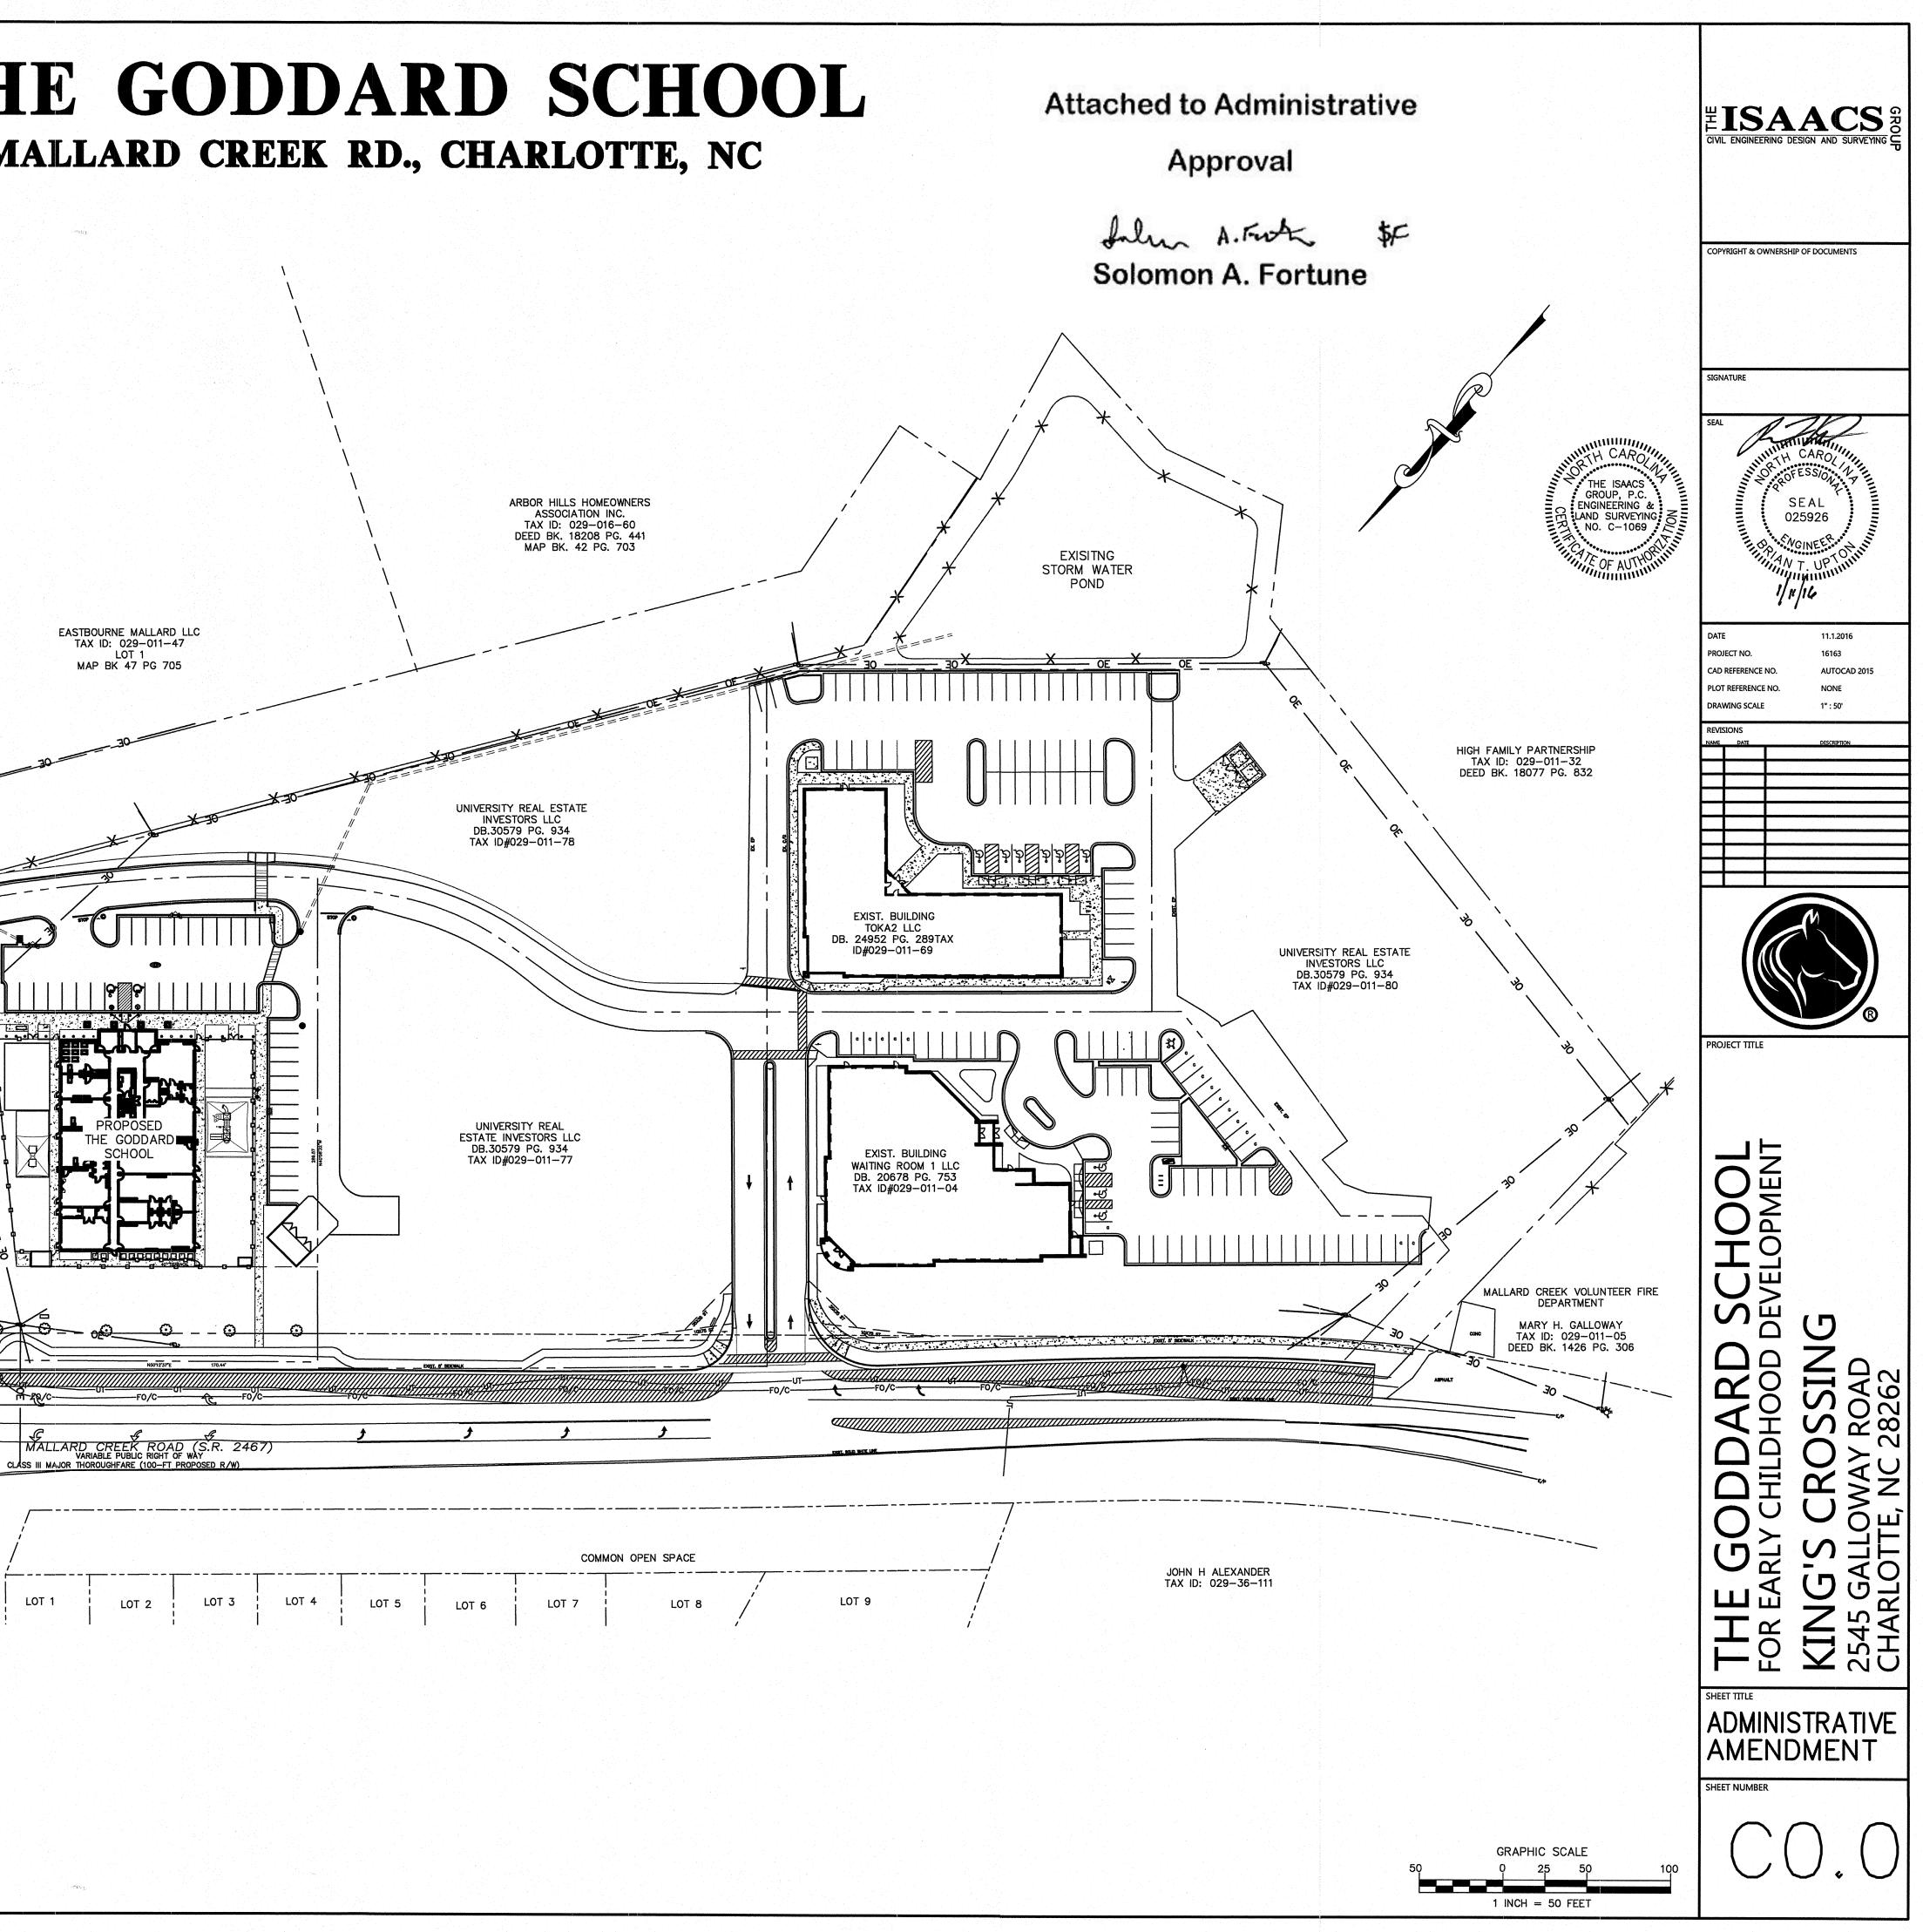

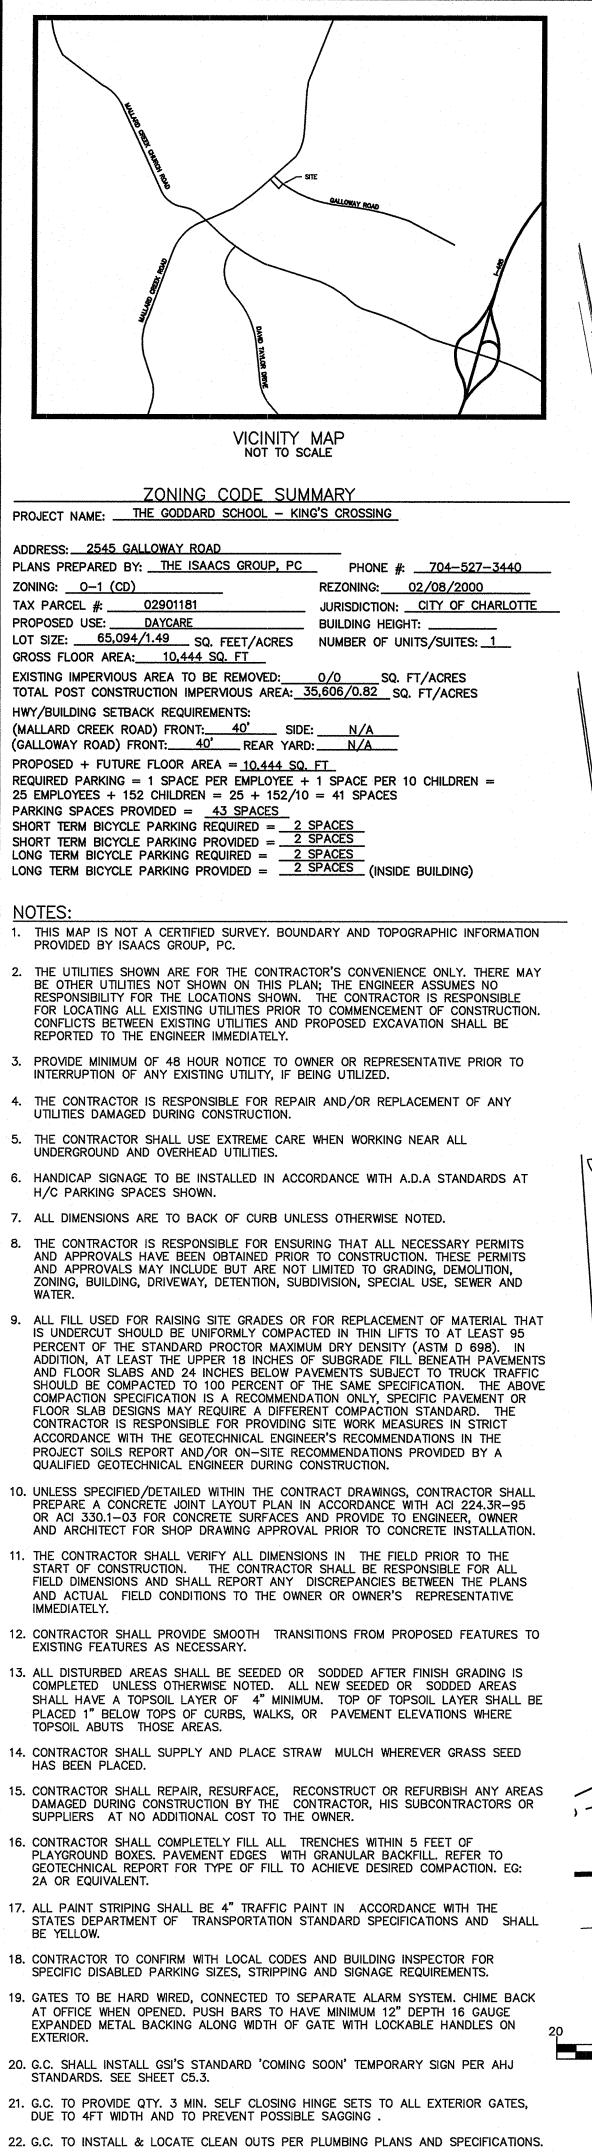

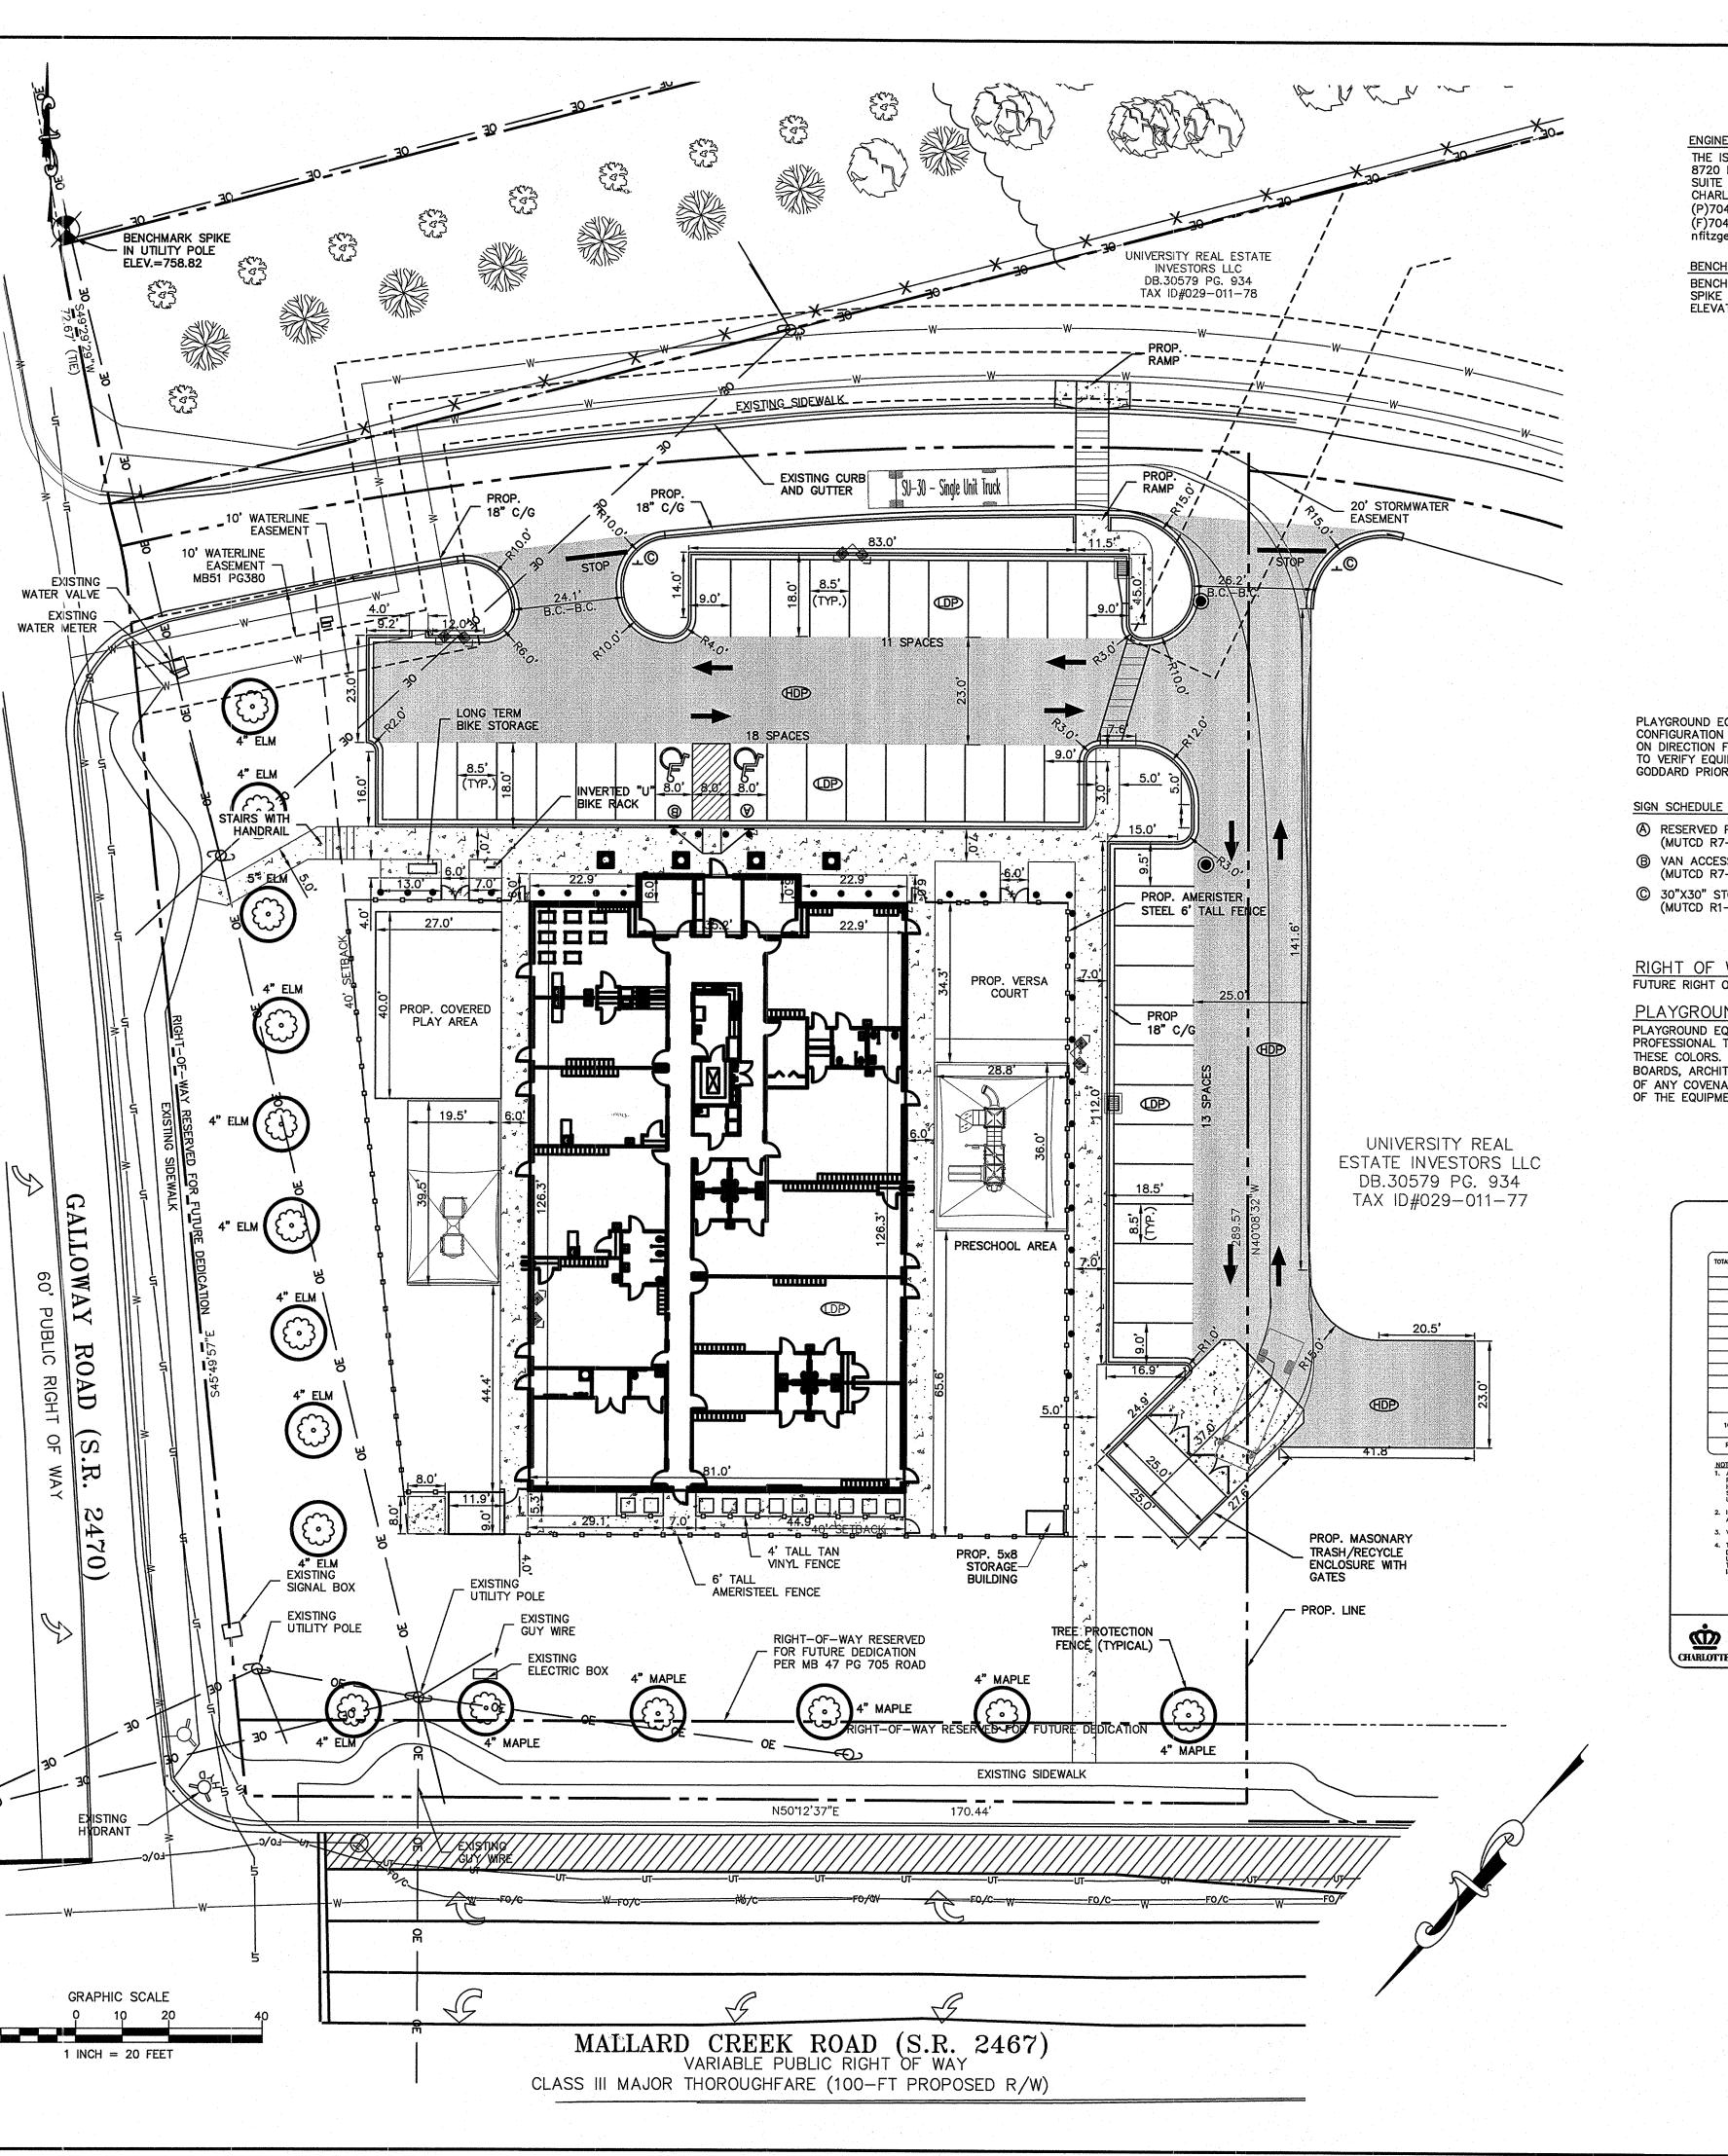

ENGINEER CONTACT ISAACS CONTRACTOR TO VERIFY FINAL LIGHT POLE LOCATIONS AND THE ISAACS GROUP, P.C. FIXTURE SPECIFICATIONS WITH OWNER PRIOR TO INSTALLATION 8720 RED OAK BVLD. CIVIL ENGINEERING DESIGN AND SURVEYING SUITE 420 CHARLOTTE, NC 28217 (P)704-227-9408 SIGNAGE NOTE: (F)704-527-8335 REFER TO ARCHITECTURAL PLANS FOR ACTUAL BUILDING DIMENSIONS. nfitzgerald@isaacsgrp.com BENCHMARK NOTE: CONTRACTOR TO COORDINATE FINAL SIGN BENCHMARK LOCATED ON A LOCATIONS WITH OWNER PRIOR TO SPIKE IN A UTILITY POLE. COPYRIGHT & OWNERSHIP OF DOCUMENTS ELEVATION = 758.82INSTALLATION SIGNAGE TO BE PERMITTED SEPARATELY. SIGNATURE ч CAR THE ISAACS GROUP, P.C ENGINEERING & LAND SURVEYING SEAL NO. C-1069 025926 RECOMMENDED PAVING SPECIFICATIONS 12-22-16 LIGHT DUTY PAVEMENT (LDP): PLAYGROUND EQUIPMENT AND 6" COMPACTED AGGREGATE BASE COURSE (CABC) 11.1.2016 DATE CONFIGURATION SUBJECT TO CHANGE BASED 2" BINDER SURFACE COURSE, 119.0A ON DIRECTION FROM GODDARD. CONTRACTOR PROJECT NO. 16163 " SURFACE COURSE, S9.5A TO VERIFY EQUIPMENT LOCATION WITH CAD REFERENCE NO. AUTOCAD 2015 GODDARD PRIOR TO INSTALLATION. HEAVY DUTY PAVEMENT (HDP): PLOT REFERENCE NO. NONE 8" COMPACTED AGGREGATE BASE COURSE (CABC) DRAWING SCALE 1" : 20' 2" BINDER SURFACE COURSE, 119.0A 2" SURFACE COURSE, SF9.5A (A) RESERVED PARKING-MAX PENALTY \$250 (MUTCD R7-8 & R7-8D) CONCRETE DUMPSTER AND HEAVY DUTY PAVEMENT: NPF 12/22/16 REVISIONS PER CITY COMMENTS B VAN ACCESSIBLE HANDICAPPED PARKING SIGN " COMPACTED AGGREGATE BASE COURSE (CABC) (MUTCD R7-8, R7-8A & R7-8D) 6" 4,000 PSI CONCRETE WITH FIBER MESH AND BROOM FINISH © 30"X30" STOP SIGN CONCRETE SIDEWALK PAVEMENT: 4" 3,600 PSI CONCRETE (MUTCD R1-1) SUBGRADE SHALL BE COMPACTED TO 98% MIN. OF THE STANDARD MAXIMUM DRY DENSITY (ASTM D698). **RIGHT OF WAY NOTE:** FUTURE RIGHT OF WAY ALONG MALLARD CREEK TO BE DEDICATED PRIOR TO ISSUANCE OF C.O. PLAYGROUND NOTES PLAYGROUND EQUIPMENT IS DESIGNED WITH THE PRIMARY COLORS BLUE, RED, GREEN AND YELLOW. DEVELOPER/DESIGN PROFESSIONAL TO CONFIRM THAT THERE ARE NO RESTRICTIONS THAT WILL NOT PERMIT THE INSTALLATION OF EQUIPMENT WITH THESE COLORS. DEVELOPER/DESIGN PROFESSIONAL TO VERIFY WITH ANY GOVERNING BODY NOT LIMITED TO PLANNING AND ZONING BOARDS, ARCHITECTURAL REVIEW BOARDS, OR HOME OWNER'S ASSOCIATIONS AS WELL AS WITH AND NOT LIMITED TO THE REVIEW OF ANY COVENANTS AND RESTRICTIONS OR DESIGN GUIDELINES. GODDARD SYSTEMS, INC. (GSI) CAN PROVIDE COLOR ELEVATIONS OF THE EQUIPMENT IF NECESSARY. PLEASE CONTACT YOUR GSI REPRESENTATIVE IF THE PRIMARY COLORS ARE NOT PERMITTED. PROJECT TITLE PARKING SPACE PAVEMENT MARKINGS (MUST NOT DESTRUCT ______ (MUST NOT DESTRUCT ______) (MUST NOT DESTRUCT ______ (MUST NOT DESTRUCT ______) (MUST NOT DESTRUCT _______) (MUST NOT DESTRUCT ________) (MUST NOT DESTRUCT _______) (MUST NOT DESTRUCT ________) (MUST NOT DESTRUCT _______) (MUST NOT DESTRUCT ________) (MUST NOT DESTRUCT _______) (MUST NOT DESTRUCT _______) (MUST NOT DESTR ACCESSIBLE PARKING REQUIREMENTS ACCESSIBLE ROUTE (SEE NOTE 2) TOTAL PARKING SPACES PROVIDED OF ACCESSIBLE SPACES REQUIRED TO BE VAN ACCESSIBLE SPACES REQUIRED TO BE VAN ACCESSIBLE SEE STD. NO 50.09 FOR DIMENSIONS 1 TO 25 26 TO 50 NOTE: ONE OUT OF EVERY SIX (6) ACCESSIBLE SPACES, BUT NOT LESS THAN ONE, IS REQUIRED TO BE VAI ACCESSIBLE, PER SECTION 1106.5 OF NC STATE BUILDING CODE Ø 51 TO 75 11' 5' 8' 8' 8' 8' 8' 8' 8' 8' 8' 8' 76 TO 100 C 101 TO 150 VAN VAN ACCESSIBLE ACCESSIBLE SPACE SPACE (OPTION 1) (OPTION 2) 151 TO 200 Σ 201 TO 300 301 TO 400 401 TO 500 י ם (A) (\mathbb{C}) 2% OF TOTAL 1 IN EVERY 6 ACCESSIBLE SPACES 501 TO 1000 TO VAN ACCESSIBLE RESERVED PARKING NO RESERVED 1 IN EVERY 6 ACCESSIBLE SPACES 1001 AND OVER 20 PLUS 1 FOR EACH 100 OVER 1000 PARKING REFERENCE: SECTION 1106 OF NC BUILDING CODE G ANY Time NUTCD R7-8 ALL 12"x18" ACCESSIBLE SIGNS (R7-8 & R7-1) SHALL BE MOUNTED AT 7 FEET FROM GRADE TO BOTTOM EDGE OF SIGN FACE (MUTCO), MOUNTING HEICHT CAN BE REDUCED TO 5 FEET IF PLACED IN AM AREA BEIMEEN SIDEWALK AND BUILDING FACE IN WHICH PEDESTRIANS ARE NOT EXPECTED TO UNDER AND BUILDING FACE IN WHICH PEDESTRIANS ARE NOT EXPECTED TO S Ш U OPTIONAL ACCESIBLE LOADING ZONE SIGN MAXIMUM PENALTY CLDSM 50.10C \$250 12"x9" 2. IF ACCESSIBLE ROUTE IS A RAISED SIDEWALK AREA, THEN RAMPS ARE REQUIRED AT LOADING ZONE AREA, MAINTAIN MIN, 4' WIDE CONTINUOUS PASSAGE. SIN 262 262 MAXIMUM PENALTY \$250 3. VERTICAL CLEARANCE FOR VANS MUST BE GREATER THAN 98-INCHES. CLDSM 50.10C 4. THIS DETAIL IS TO PROVIDE GENERAL GUIDANCE FOR PARKING LAYOUT A DESIGN REFER TO MANUAL ON UNIFORM TRAFFIC CONTROL DEVICES (MUTCH) U.S. DEPARTMENT OF TRANSPORTATION AND NORTH CAROLINA DEPARTMENT OF TRANSPORTATION SUPPLEMENT AND NORTH CAROLINA DEPARTMENT OF SEE STANDARD NO. 50.10C FOR SUPPLEMETAL SKIN DETAIL 0 $\boldsymbol{\alpha}$ ÑO 4 Ĭ S Ϋ́ α NOT TO SCAL **DD** HILD \sim CITY OF CHARLOTTE \frown ത് ACCESSIBLE PARKING AND LAND DEVELOPMENT STANDARDS STD. NO. REV. SIGNAGE STANDARDS CHARLOTTE. INCLUDES CHARLOTTE BTJ R 1 C \bigcirc Оц **U** R < O 4 Шш AR (Attached to Administrative ~ T R KIV O ~ 0 Approval LL SHEET TITLE SITE PLAN Julia A.Froth Solomon A. Fortune SHEET NUMBER

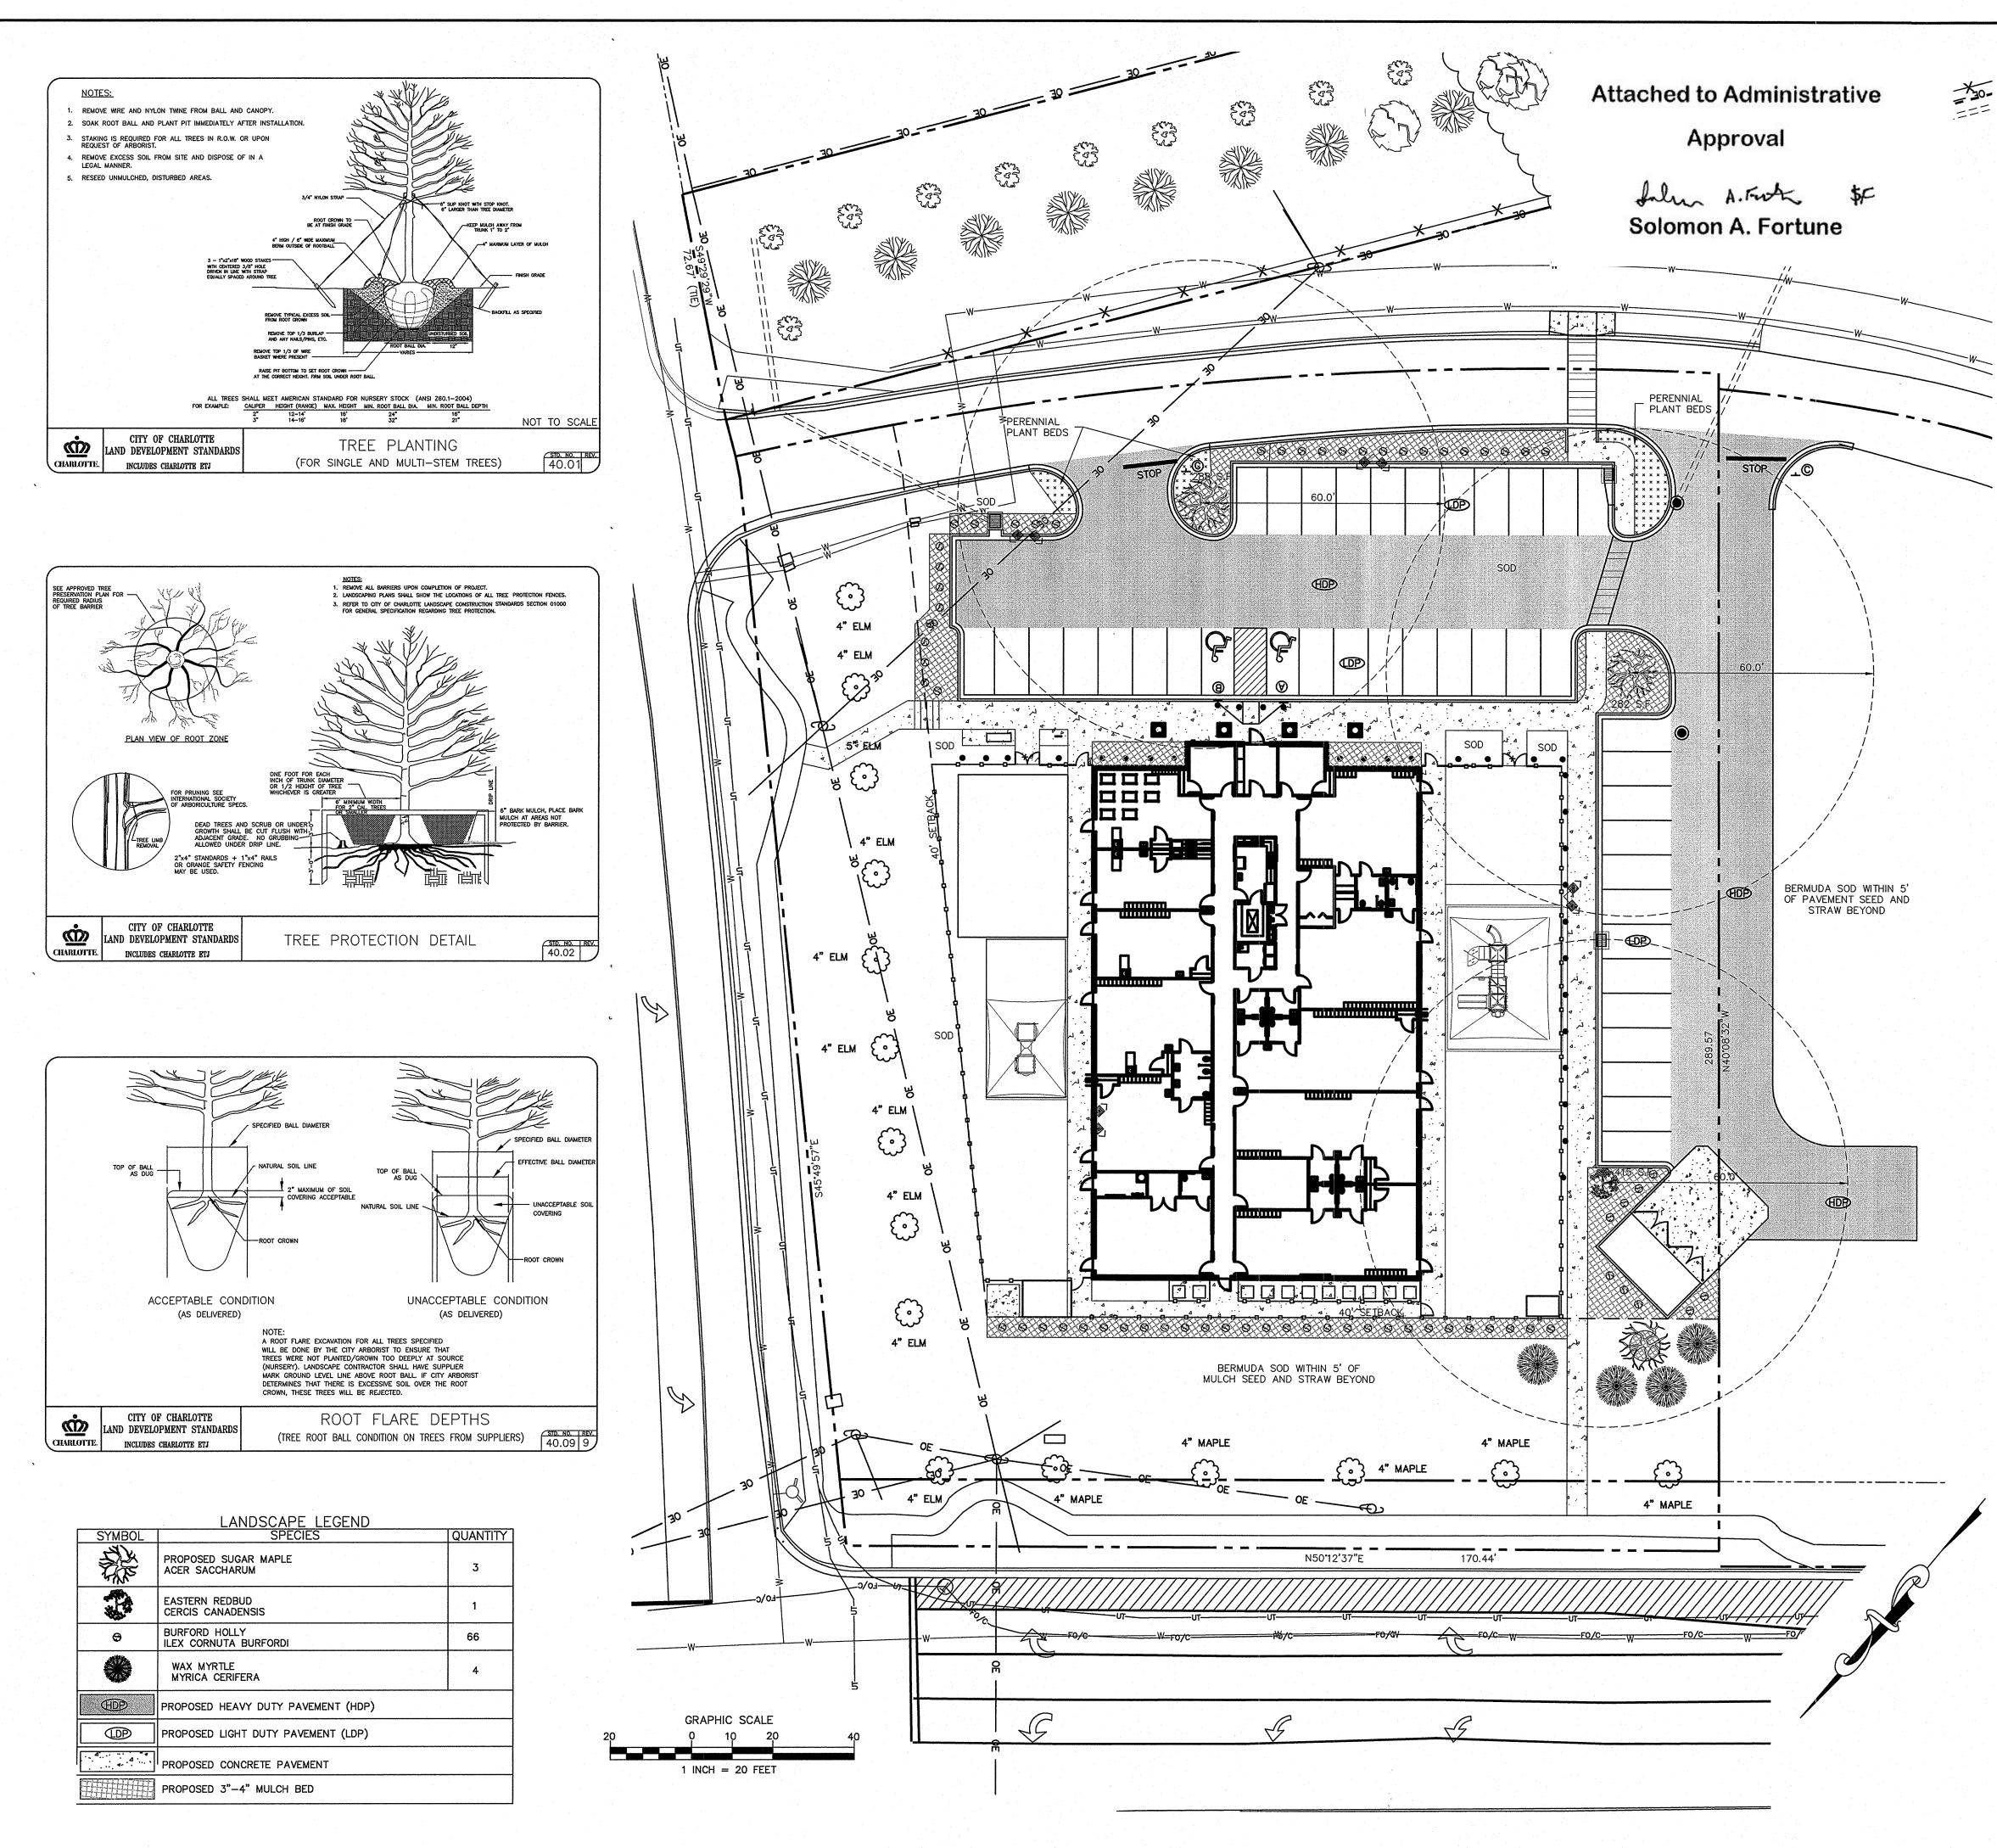

LANDSCAPING REQUIREMENTS: NTERNAL PLANTING:

- REQ'D PLANTING AREA = 10% OF TOTAL IMPERVIOUS SURFACE INTERNAL LANDSCAPING = 1 LMT REQ'D PER 10,000 S.F. IMPERVIOUS AREA IMPERVIOUS AREA
 - = 33,606 SF = 33,606/10,000 = 4 TREES REQUIRED 4 TREES PROVIDED

PERIMETER PLANTING : ONE SMT REQ'D PER 30' OF STREET FRONTAGE:

- GALLOWAY ROAD ROAD = 247 L.F. GALLOWAY ROAD REQUIRED STREET TREES = 247 L.F./40 = 7 SMT GALLOWAY ROAD PROPOSED STREET TREES = 9 PROP. SMT MALLARD CREEK ROAD = 215 L.F.
- MALLARD CREEK ROAD REQUIRED STREET TREES =210 L.F./40 = 6 SMT MALLARD CREEK ROAD PROPOSED STREET TREES = 6 PROP. LMT
- EACH PARKING SPACE MUST BE WITHIN 60 FEET OF A TREE

RRIGATION NOTE: RRIGATION TO BE DESIGNED/ BUILT BY LANDSCAPE OR IRRIGATION CONTRACTOR.

- L.M.T. TO HAVE A MINIMUM TREE CALIPER OR 2.0 INCHES MEASURED 6 INCHES ABOVE GROUND ON ALL TREES AND THE MINIMUM HEIGHT SHALL BE 8 FEET. ALL MULTI-STEM PLANTS MUST BE TREE FORM (MAXIMUM 3 TRUNKS) AND MINIMUM 8' TALL. MULCH IS REQUIRED, STAKING/GUYING IS OPTIONAL.
- L.M.T. & S.M.T. REPRESENTS LARGE MATURING & SMALL MATURING TREES FROM APPROVED LIST IN APPENDIX OF THE CITY OF CHARLOTTE ZONING ORDINANCE FOR SCREENING AND BUFFER TREES, AND FROM THE URBAN FORESTRY APPROVED LIST FOR STREET TREES AND INTERNAL PLANTINGS REQUIRED BY THE TREE ORDINANCE. MINIMUM TREE CALIPER MEASURED 6 INCHES ABOVE GROUND ON ALL TREES SHALL BE 2.0 INCHES AND THE MINIMUM HEIGHT SHALL BE 8 FEET. ALL MULTI-STEM PLANTS MUST BE TREE FORM (MAXIMUM 3 TO 5 TRUNKS) AND MINIMUM 8' TALL.
- SHRUBS USED FOR SCREENING TO BE EVERGREEN FROM THE APPROVED LIST IN APPENDIX 1 OF THE CHARLOTTE ZONING ORDINANCE. SHRUBS TO BE AT LEAST 2.0' TALL AND MIN 2.0' SPREAD WHEN PLANTED AND NO FURTHER APART THAN 5'. THEY MUST BE OF A VARIETY AND ADEQUATELY MAINTAINED SO THAT AN AVERAGE OF 5 TO 6 FEET COULD BE EXPECTED AS NORMAL GROWTH WITHIN 4 YEARS OF PLANTING.

CHARLOTTE URBAN FORESTRY - TREE PLANTING AND PRESERVATION REQUIREMENTS (UPDATED 10/10/16) PLANT MATERIAL:

- 1. MINIMUM TREE SIZE AT PLANTING IS 2"CALIPER AND 8'TALL FOR SINGLE-STEM TREES. ALL MULTI-STEM PLANTS MUST BE TREE FORM, MAXIMUM 3 TO 5 TRUNKS, AND MINIMUM 10'TALL. WHERE 3"SINGLE-STEM CALIPER TREES ARE SPECIFIED/REQUIRED THE MINIMUM HEIGHT SHALL BE 10'TALL, IF MULTI-STEM
- TREES ARE SPECIFIED THEN THEY SHALL BE A MINIMUM OF 12'TALL. 2. ALL NEW TREES MUST HAVE STRAIGHT TRUNKS WITH STRONG CENTRAL LEADERS INTACT TO THE TOP OF THE CROWN UNLESS MULTI-STEM TREES ARE SPECIFIED. ALL REQUIRED TREES SHALL BE TYPICAL OF THEIR SPECIES AND VARIETY, HAVE NORMAL GROWTH HABITS, HAVE WELL-DEVELOPED BRANCHES, BE VIGOROUS AND HAVE FIBROUS ROOT SYSTEMS. TREES WITH MAJOR GIRDLING ROOTS WILL NOT BE ACCEPTED. TREES WITH CO-DOMINANT BRANCHING WILL NOT BE ACCEPTED. TREES THAT HAVE BEEN SHEARED, TOPPED OF CUT BACK TO MULTIPLY THE BRANCHING STRUCTURE WILL NOT BE ACCEPTED. TREES SHALL BE FREE OF ABRASIONS, DAMAGE, DISEASE, PESTS AND CRACKS. ALL PRUNING CUTS GREATER THAN 1/2 INCH DIAMETER SHALL HAVE CALLUS TISSUE FORMED PRIOR TO PLANTING. NO PRUNING CUT ON THE TRUNK SHALL BE MORE THAN ONE-HALF THE DIAMETER OF THE CENTRAL LEADER AT THE HEIGHT WHERE THE CUT WAS MADE. ROOT FLARES SHALL BE LOCATED AT GRADE. TREES WITH MORE THAN 2"OF SOIL COVERING THE
- ROOT BALL/FLARE FROM WILL NOT BE ACCEPTED (CLDS.40.09). 3. SIZE OF REQUIRED PLANTS, SPREAD OF ROOTS AND SIZE OF BALLS SHALL BE IN ACCORDANCE WITH ANSI Z60.1 (LATEST EDITION) AS PUBLISHED BY THE AMERICAN NURSERY & LANDSCAPE ASSOCIATION, EXCEPT WHERE SPECIFIED/AUTHORIZED BY URBAN FORESTRY. ALL REQUIRED TREES OF A PARTICULAR SPECIES AND VARIETY SHALL BE UNIFORM IN SIZE AND CONFIGURATION. 4. PERIMETER TREES IN URBAN ZONES SHALL BE 3"IN CALIPER AND BE FREE OF BRANCHES UP TO 6'FROM
- THE TOP OF ROOT CROWN (BALL). 5. A MINIMUM OF 50% OF NEW TREES MUST BE NATIVE SPECIES, AND SITES WITH MORE THAN 20 TREES
- REQUIRED WILL HAVE TO INSTALL MULTIPLE (3 OR MORE) SPECIES PURSUANT TO THE TREE ORDINANCE GUIDELINES. 6. 75% OF REQUIRED TREES MUST BE LARGE MATURE SPECIES EXCEPT IN SITUATIONS WITH OVERHEAD POWER LINE CONFLICTS.

PLANTING REQUIREMENTS:

- 1. SEE CLDS 40.01 & 40.09 (ON PLAN) FOR DETAILED TREE PLANTING REQUIREMENTS.
- 2. PLASTIC HOSE PARTS WILL NOT BE ACCEPTED FOR TREE STAKING. SEE CLDS 40.01 FOR APPROVED STAKING METHOD/MATERIALS. 3. ALL STRAPPING, AND TOP 1/3 OF WIRE BASKET AND BURLAP MUST BE CUT AWAY AND REMOVED FROM
- ROOT BALL WHEN PLANTING. 4. FOR NEW PLANTING AREAS, REMOVE ALL PAVEMENT, GRAVEL SUB-BASE AND CONSTRUCTION DEBRIS: REMOVE COMPACTED SOIL AND ADD 18" NEW TOPSOIL, OR TILL AND AMEND THE TOP 18" OF EXISTING SOIL TO MEET TOPSOIL/PLANTING MIX STANDARDS FOR TREES (WITHIN ENTIRE MINIMUM AREA OF 274 SQUARE FEET)
- 5. TREES PLANTED ON PUBLIC PROPERTY WILL NEED APPROVAL FROM THE CITY ARBORIST AND/OR NCDOT. 6. REVIEW SOIL REQUIREMENTS IN THE TREE ORDINANCE GUIDELINES AT: HTTP://CHARLOTTENC.GOV/LD THEN CLICK TREES.

UTILITY ISSUES:

- 1. IF ANY UTILITY IS BEING INSTALLED IN OR NEAR ANY REQUIRED TREE(S) OR TREE SAVE AREA(S), CALL URBAN FORESTRY SPECIALIST TO RESOLVE PRIOR TO UTILITY INSTALLATION. 2. LARGE MATURING TREES MAY NOT BE PLANTED WITHIN 25'OF OVERHEAD POWER DISTRIBUTION OR
- TRANSMISSION LINES. 3. IF TREES CONFLICT WITH ANY UTILITIES OR SIGNS; CALL URBAN FORESTER TO RESOLVE BEFORE PLANTING. 4. ADJUST TREE PLANTING LOCATIONS TO AVOID EXISTING UNDERGROUND UTILITIES. PLANT 15'FROM ALL
- UNDERGROUND UTILITIES.
- 5. NO LIGHT POLES, UTILITIES OR TRANSFORMERS CAN BE INSTALLED IN TREE ISLANDS. 6. COMMERCIAL SCALE LIGHTING (> 15'IN HEIGHT) MUST BE A MINIMUM DISTANCE OF 30'FROM A TREE. PEDESTRIAN SCALE LIGHTING (< 15'IN HEIGHT) MUST BE A MINIMUM DISTANCE OF 15'FROM A TREE. SHOW SITE LIGHTING ON LANDSCAPE PLAN.


TREE SAVE AND PRESERVATION:

- TREE PROTECTION MUST BE INSTALLED AND VERIFIED BY URBAN FORESTRY PRIOR TO STARTING ANY
- CONSTRUCTION ACTIVITY. 2. SHOW TREE PROTECTION AND TREES SAVE AREAS ON EROSION CONTROL, GRADING AND LANDSCAPE PLAN
- SHEETS. 3. COMMERCIAL TREE SAVE AREAS MUST BE RECORDED ON A FINAL PLAT WITH THE MECKLENBURG COUNTY REGISTER OF DEEDS BEFORE URBAN FORESTRY HOLDS CAN BE RELEASED. A 10'NO BUILD ZONE AROUND TREE SAVE AREAS MUST BE REFERENCED ON THE PLAT. 4. TREE SAVE AREAS SHALL BE FREE OF INVASIVE PLANT SPECIES. IF AN AREA PROPOSED FOR TREE SAVE
- CONTAINS INVASIVE PLANT SPECIES AT TIME OF PROPOSAL, SUCH INVASIVE PLANT SPECIES SHALL BE REMOVED PRIOR TO FINAL CO.
- 5. THE AREA OF ANY EASEMENTS (WATER, SEWER, UTILITY, ETC.) CAN NOT BE COUNTED TOWARD THE TREE SAVE REQUIREMENT. 6. ANY ALTERATIONS TO TREE SAVE AREAS MUST BE ACCOMPLISHED WITHOUT MECHANIZED EQUIPMENT.
- 7. NO STRUCTURE WILL BE ALLOWED WITHIN 10'OF TREE SAVE AREAS UNLESS APPROVED BY URBAN FORESTRY. 8. ALL TREES ON PUBLIC PROPERTY ARE PROTECTED AND REMOVAL MUST BE PERMITTED BY THE CITY
- ARBORIST (704)336-4262. 9. CONTACT URBAN FORESTRY SPECIALIST PRIOR TO ANY CRANE SET-UP, MACHINERY OPERATION OR TEMPORARY BUILDING ERECTION THAT MAY IMPACT CHARLOTTE TREE ORDINANCE PROTECTED TREES OR TREE SAVE AREAS, INCLUDING TREES LOCATED IN STREET RIGHT OF WAY. IMPACTS MAY INCLUDE BUT ARE
- NOT LIMITED TO: ENCROACHING WITHIN TREE DRIP-LINES, EXCAVATION, SOIL COMPACTION, TREE TRIMMING, ERECTING AND DISMANTLING OF CONSTRUCTION CRANES. GENERAL:

- I. SUBMIT REQUIRED CO/HOLD RELEASE FORM AT HTTP://CHARLOTTENC.GOV/LD FOR AN INSPECTION OF TREE PROTECTION / PLANTING AREAS, A MINIMUM OF 5 DAYS BEFORE THE CO / HOLD RELEASE IS NEEDED. 2. VISIT CITY OF CHARLOTTE'S LAND DEVELOPMENT WEBSITE FOR ADDITIONAL INFORMATION AND URBAN FORESTRY REQUIREMENTS: HTTP://CHARLOTTENC.GOV/LD
- **ISAACS** OPYRIGHT & OWNERSHIP OF DOCUMENTS SIGNATURE FESSI SEAL 025926 DATE 11.1.2016 PROJECT NO. 16163 CAD REFERENCE NO. AUTOCAD 2015 PLOT REFERENCE NO. NONE DRAWING SCALE 1" : 20' REVISIONS REVISIONS PER CITY CO **REVISIONS PER ZONI** PROJECT TITLE Р Ο し S Í \square \square 0 · کن · la superior de la seconda d \sim S **NO** S 0 무 M ОШ 2 AO < U ШЪ S $\boldsymbol{\alpha}$ J Υ Σ Τ D \bigcirc $\mathbf{\nabla} \mathbf{\nabla} \mathbf{\nabla}$ LL SHEET TITLE LANDSCAPE PLAN SHEET NUMBER

ISAA GROUP, P.C

ENGINEERING & AND SURVEYING

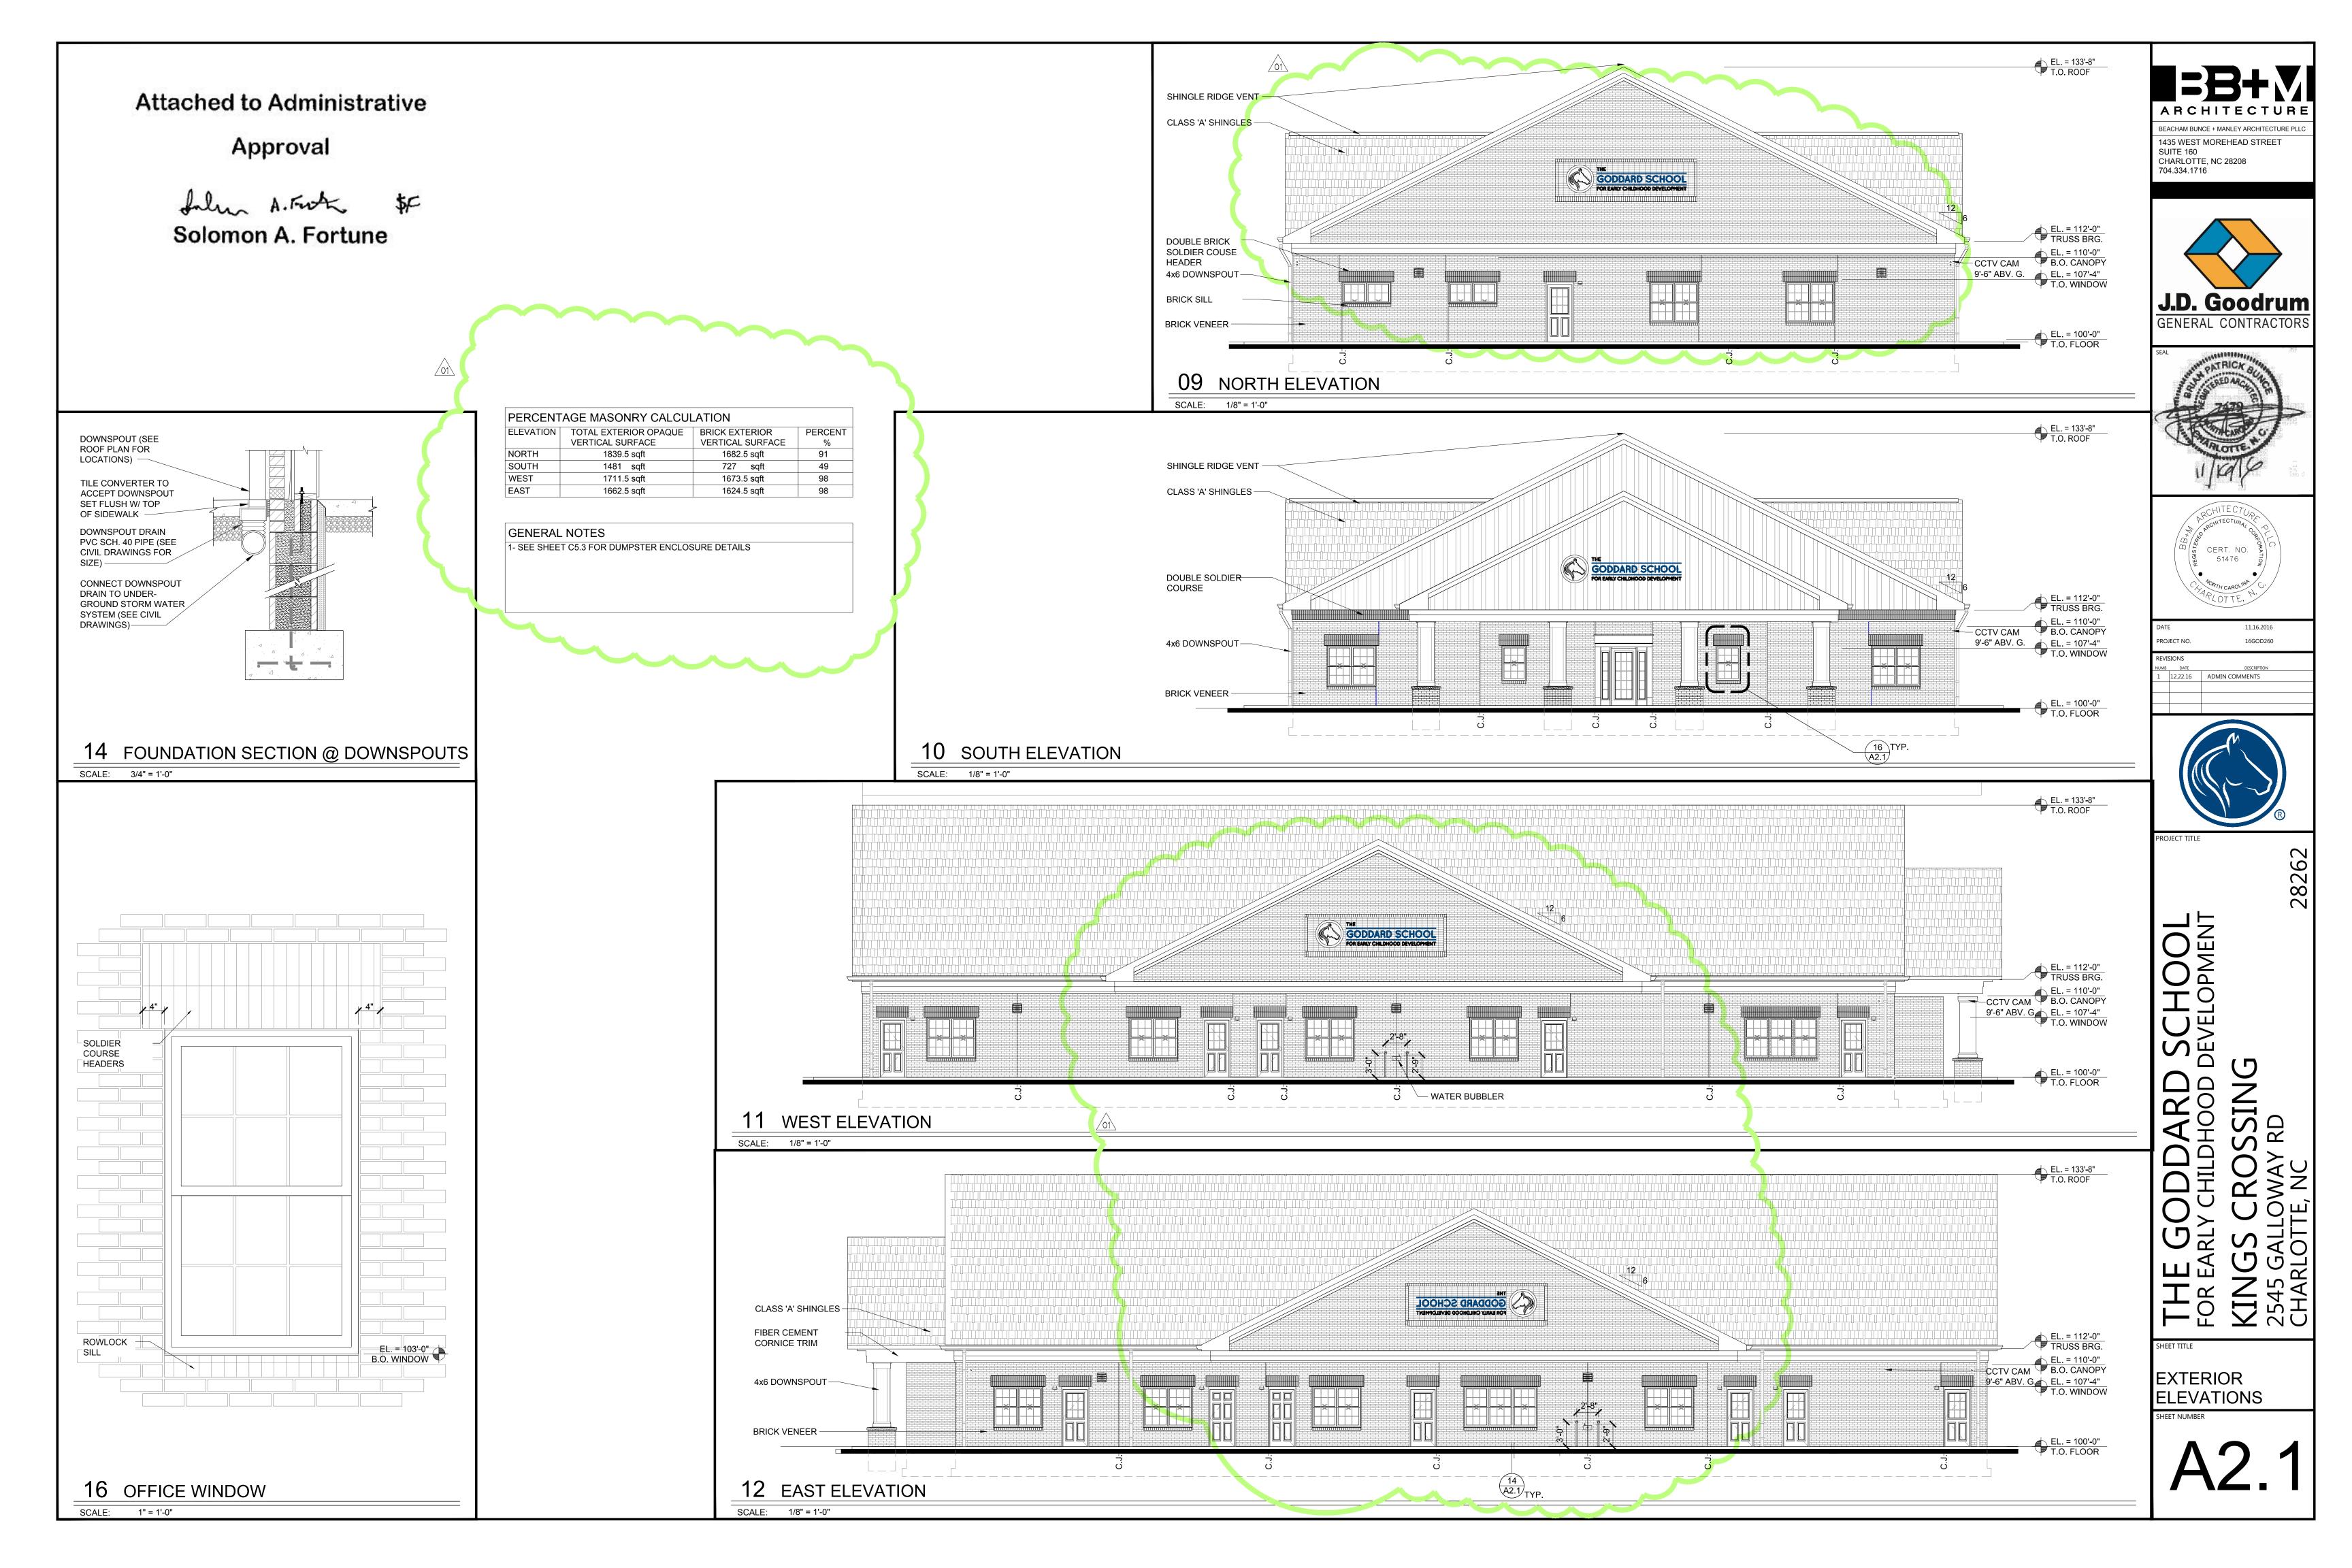



Charlotte-Mecklenburg Planning Department

DATE: April 10, 2018

TO: Donald Moore Zoning Supervisor **EXTE:** April 10, 2010

FROM: Taiwo Jaiyeoba Planning Director

SUBJECT: Administrative Approval for Petition No. 2000-011C Dallas Merle King

Attached is the revised site plan for the petition above. This request allows the modification of the proposed site plan as listed below. Since these changes do not alter the intent of the development and meets the requirements of the Charlotte Zoning Ordinance Section 6.207 <u>Alterations to Approval</u>, minor changes, I am administratively approving this plan. Please use these plans when evaluating requests for building permits and certificates of occupancy.

- To allow the development of a medical office
- Building elevations
- Landscaping Plan

Reasons for Staff's support of the request:

• The site plan complies with the conditional notes and still meets the intent of the approved site plan by the County Commissioners.


Note: All other Zoning, Subdivision, Tree Ordinances, Building Codes, and conditional requirements still apply.

Signage was not reviewed as part of this request.


CHARLOTTE-MECKLENBURG PLANNING DEPARTMENT


www.charmeck.org


600 East Fourth Street Charlotte, NC 28202-2853 PH: (704)-336-2205 FAX: (704)-336-5123

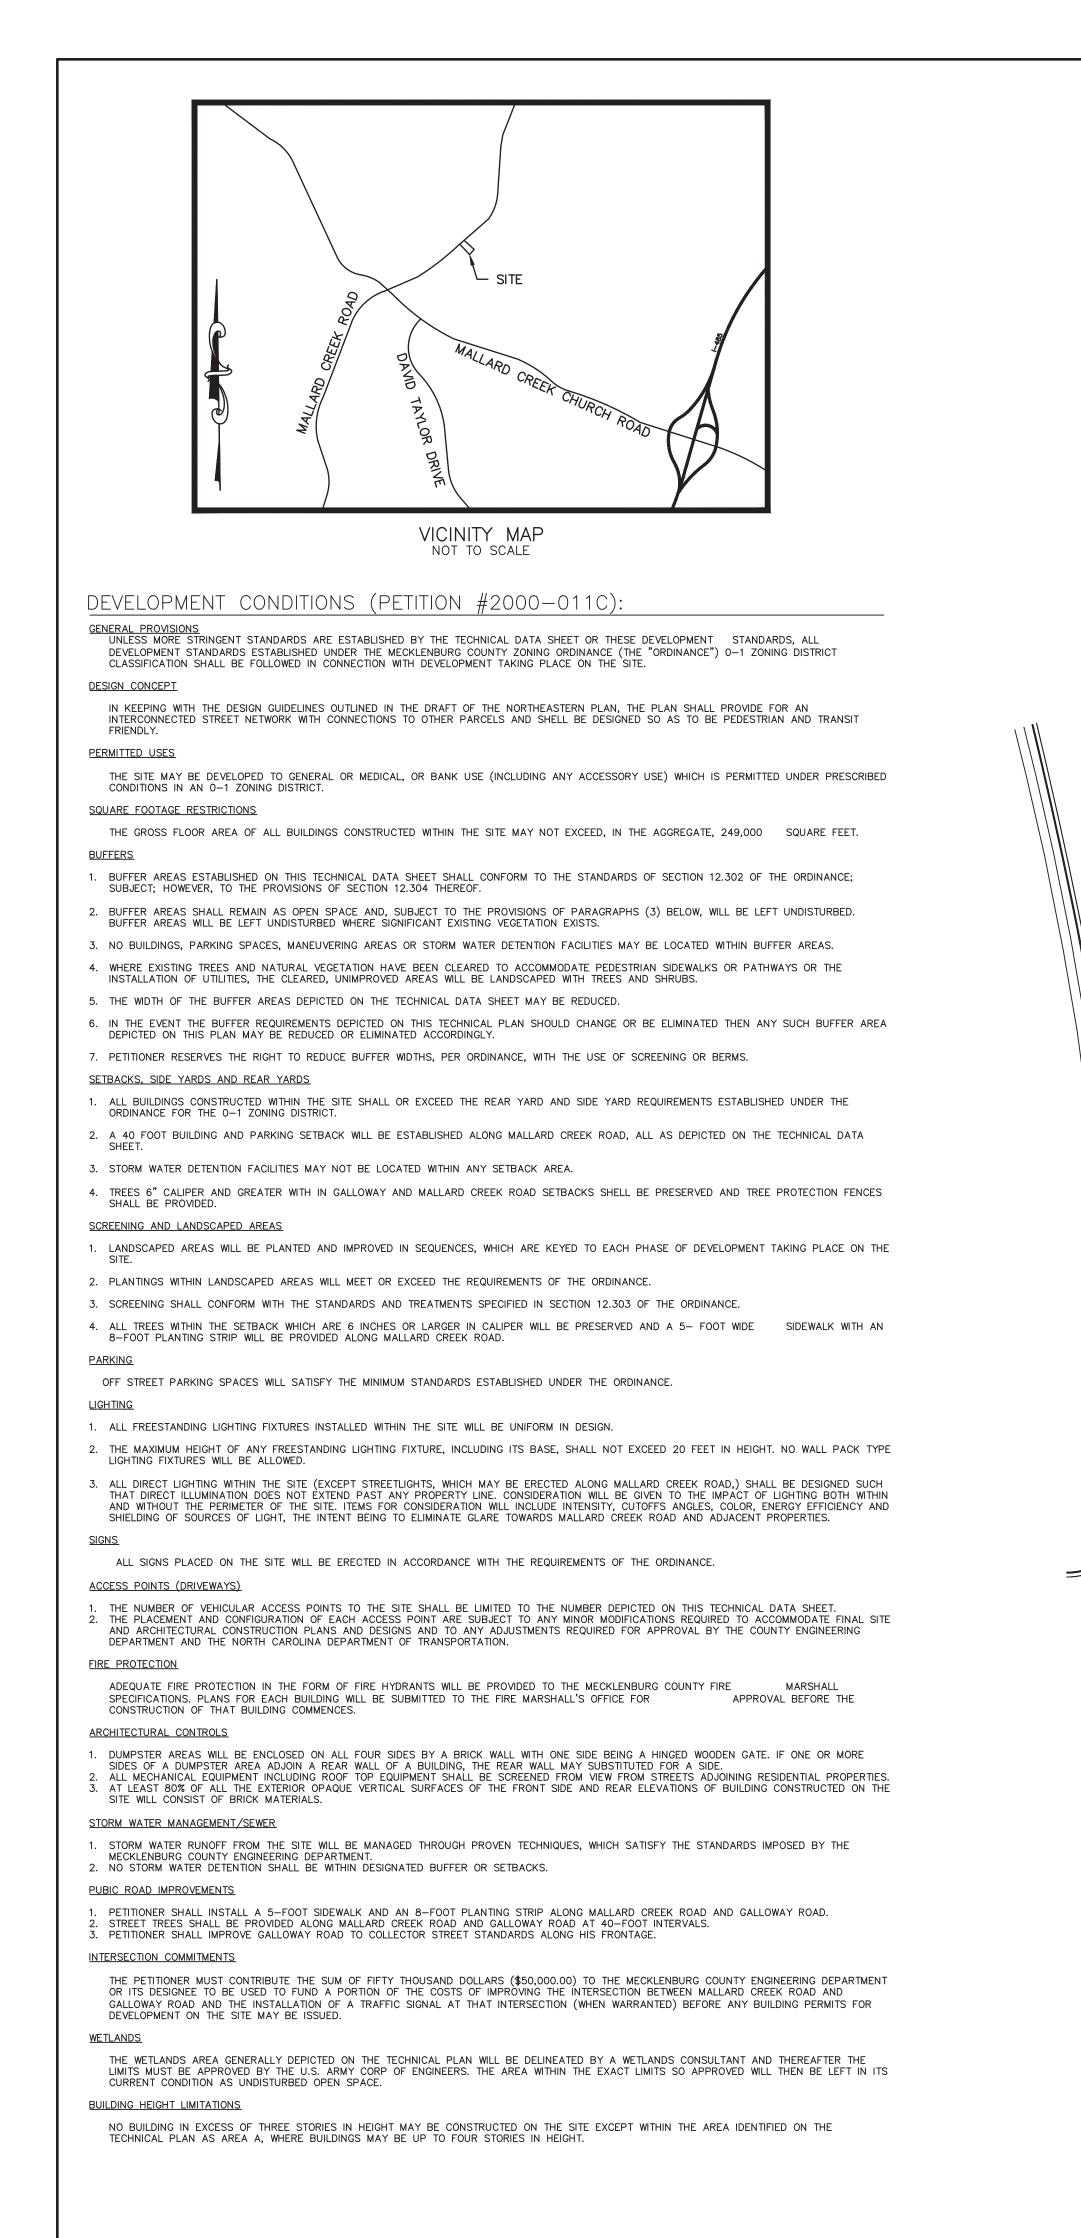



KING'S CROSSING MEDICAL OFFICE BUILDING

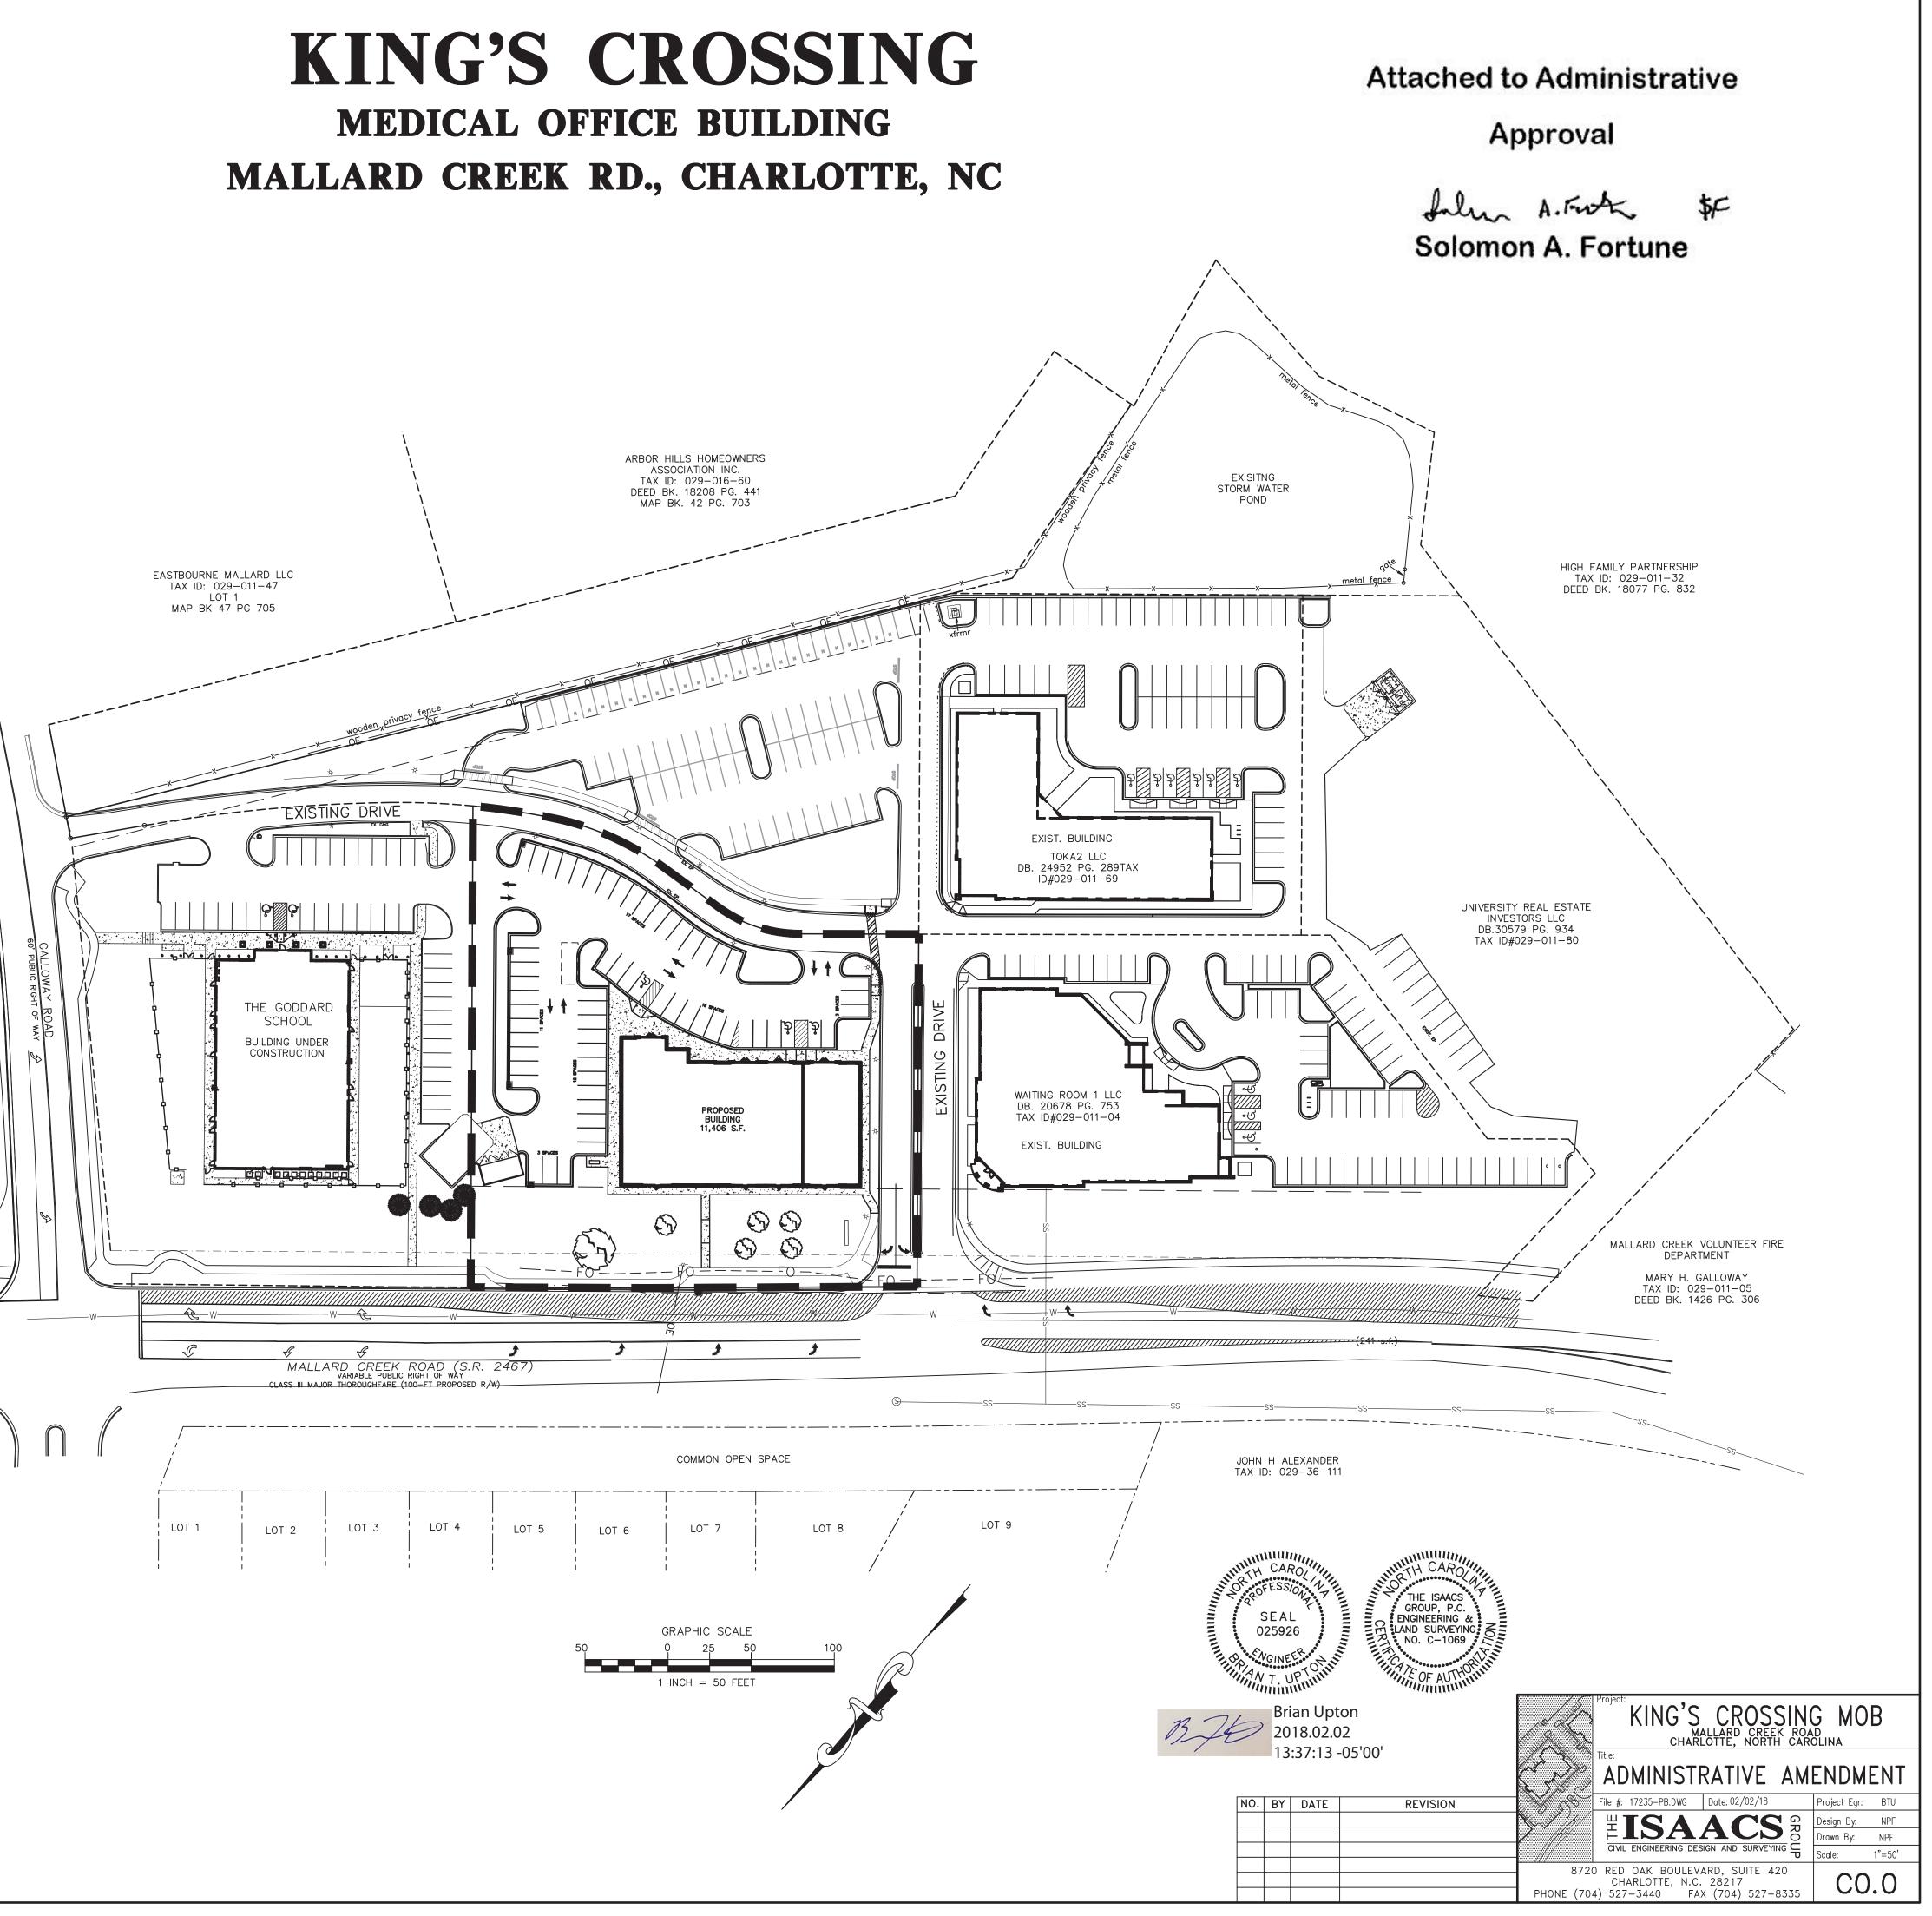

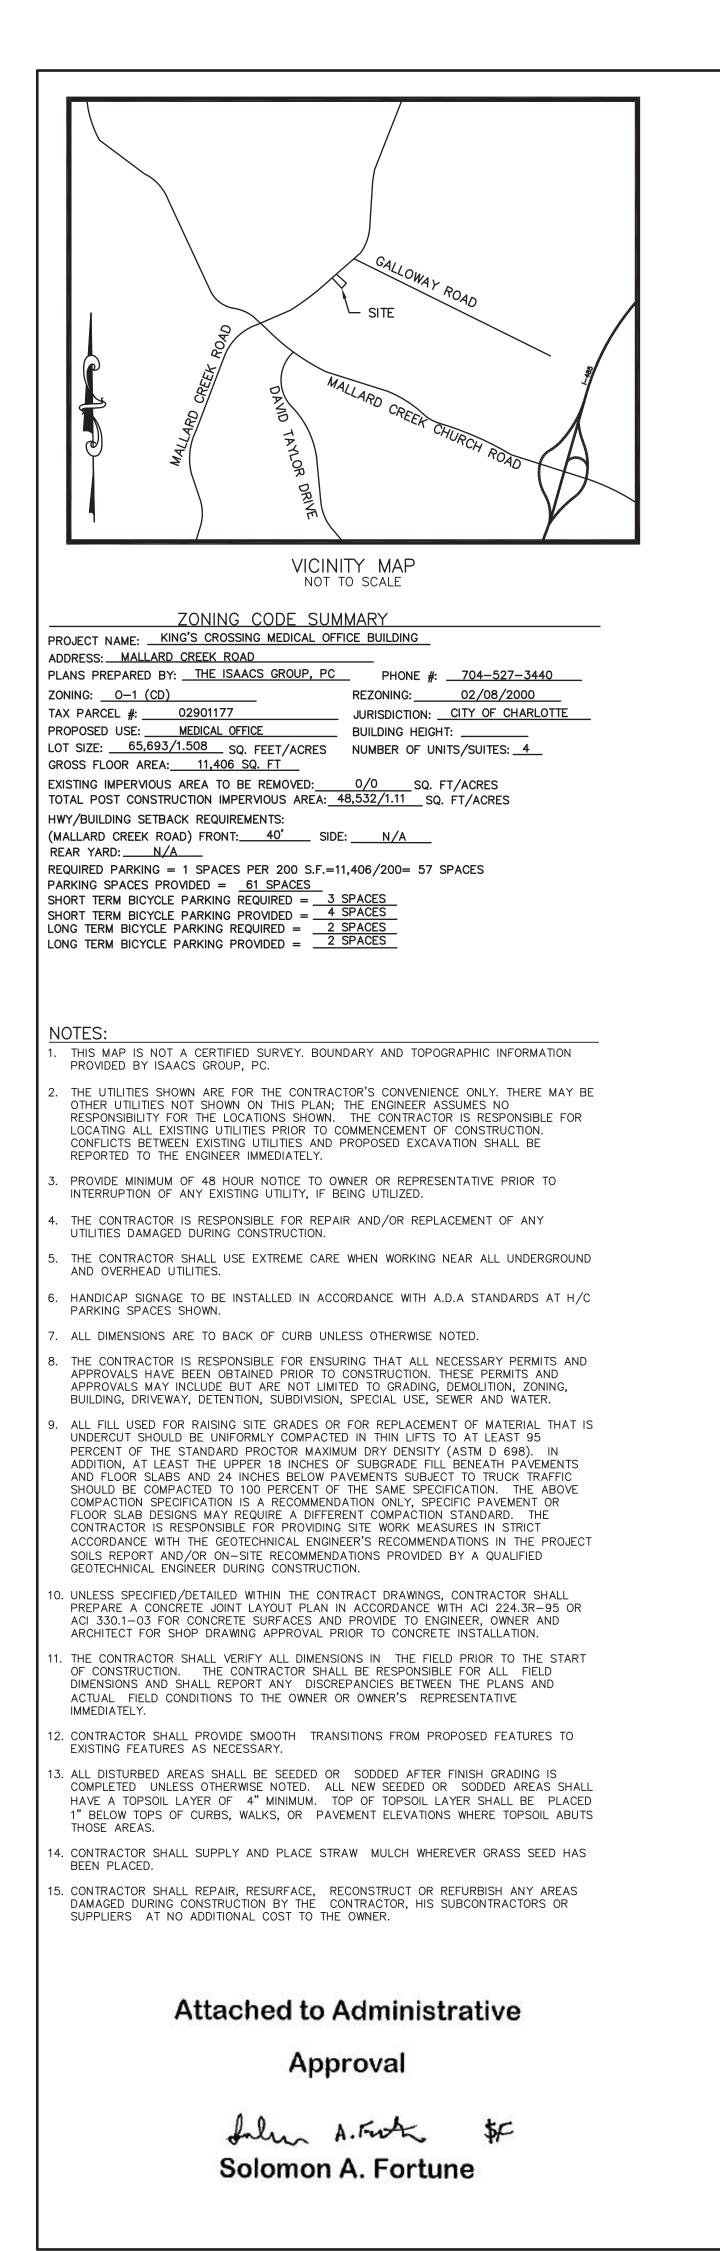

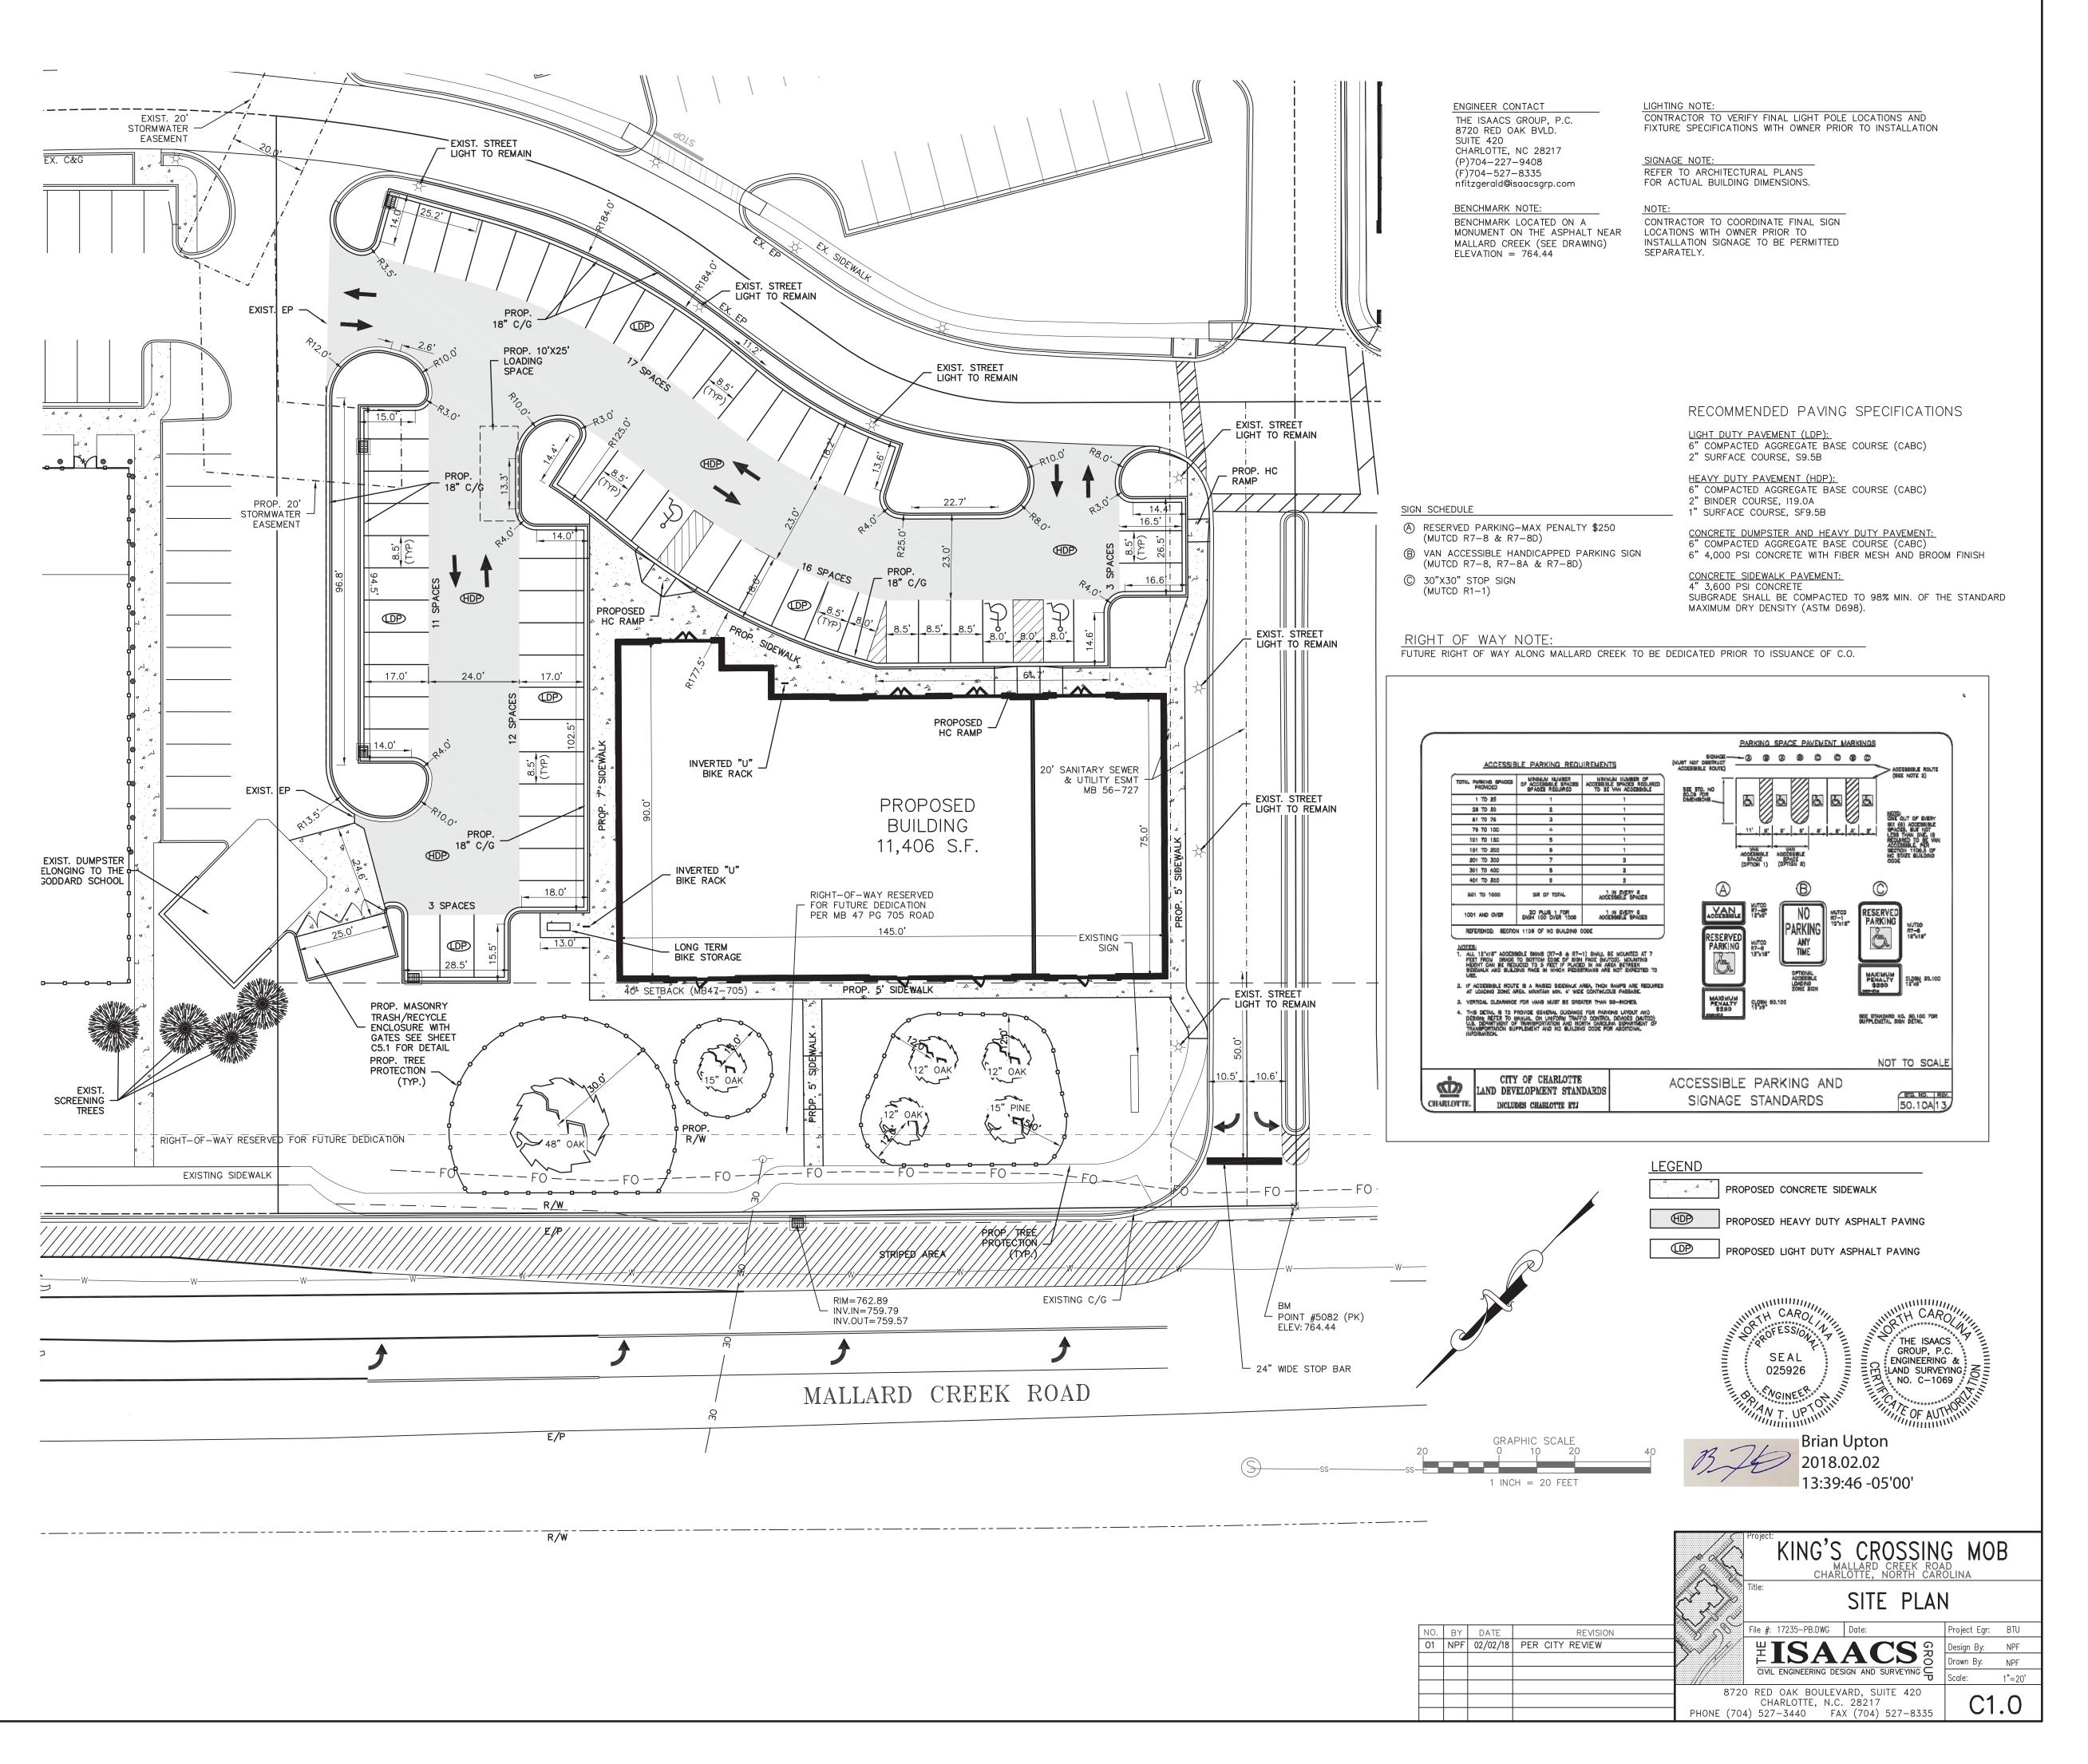


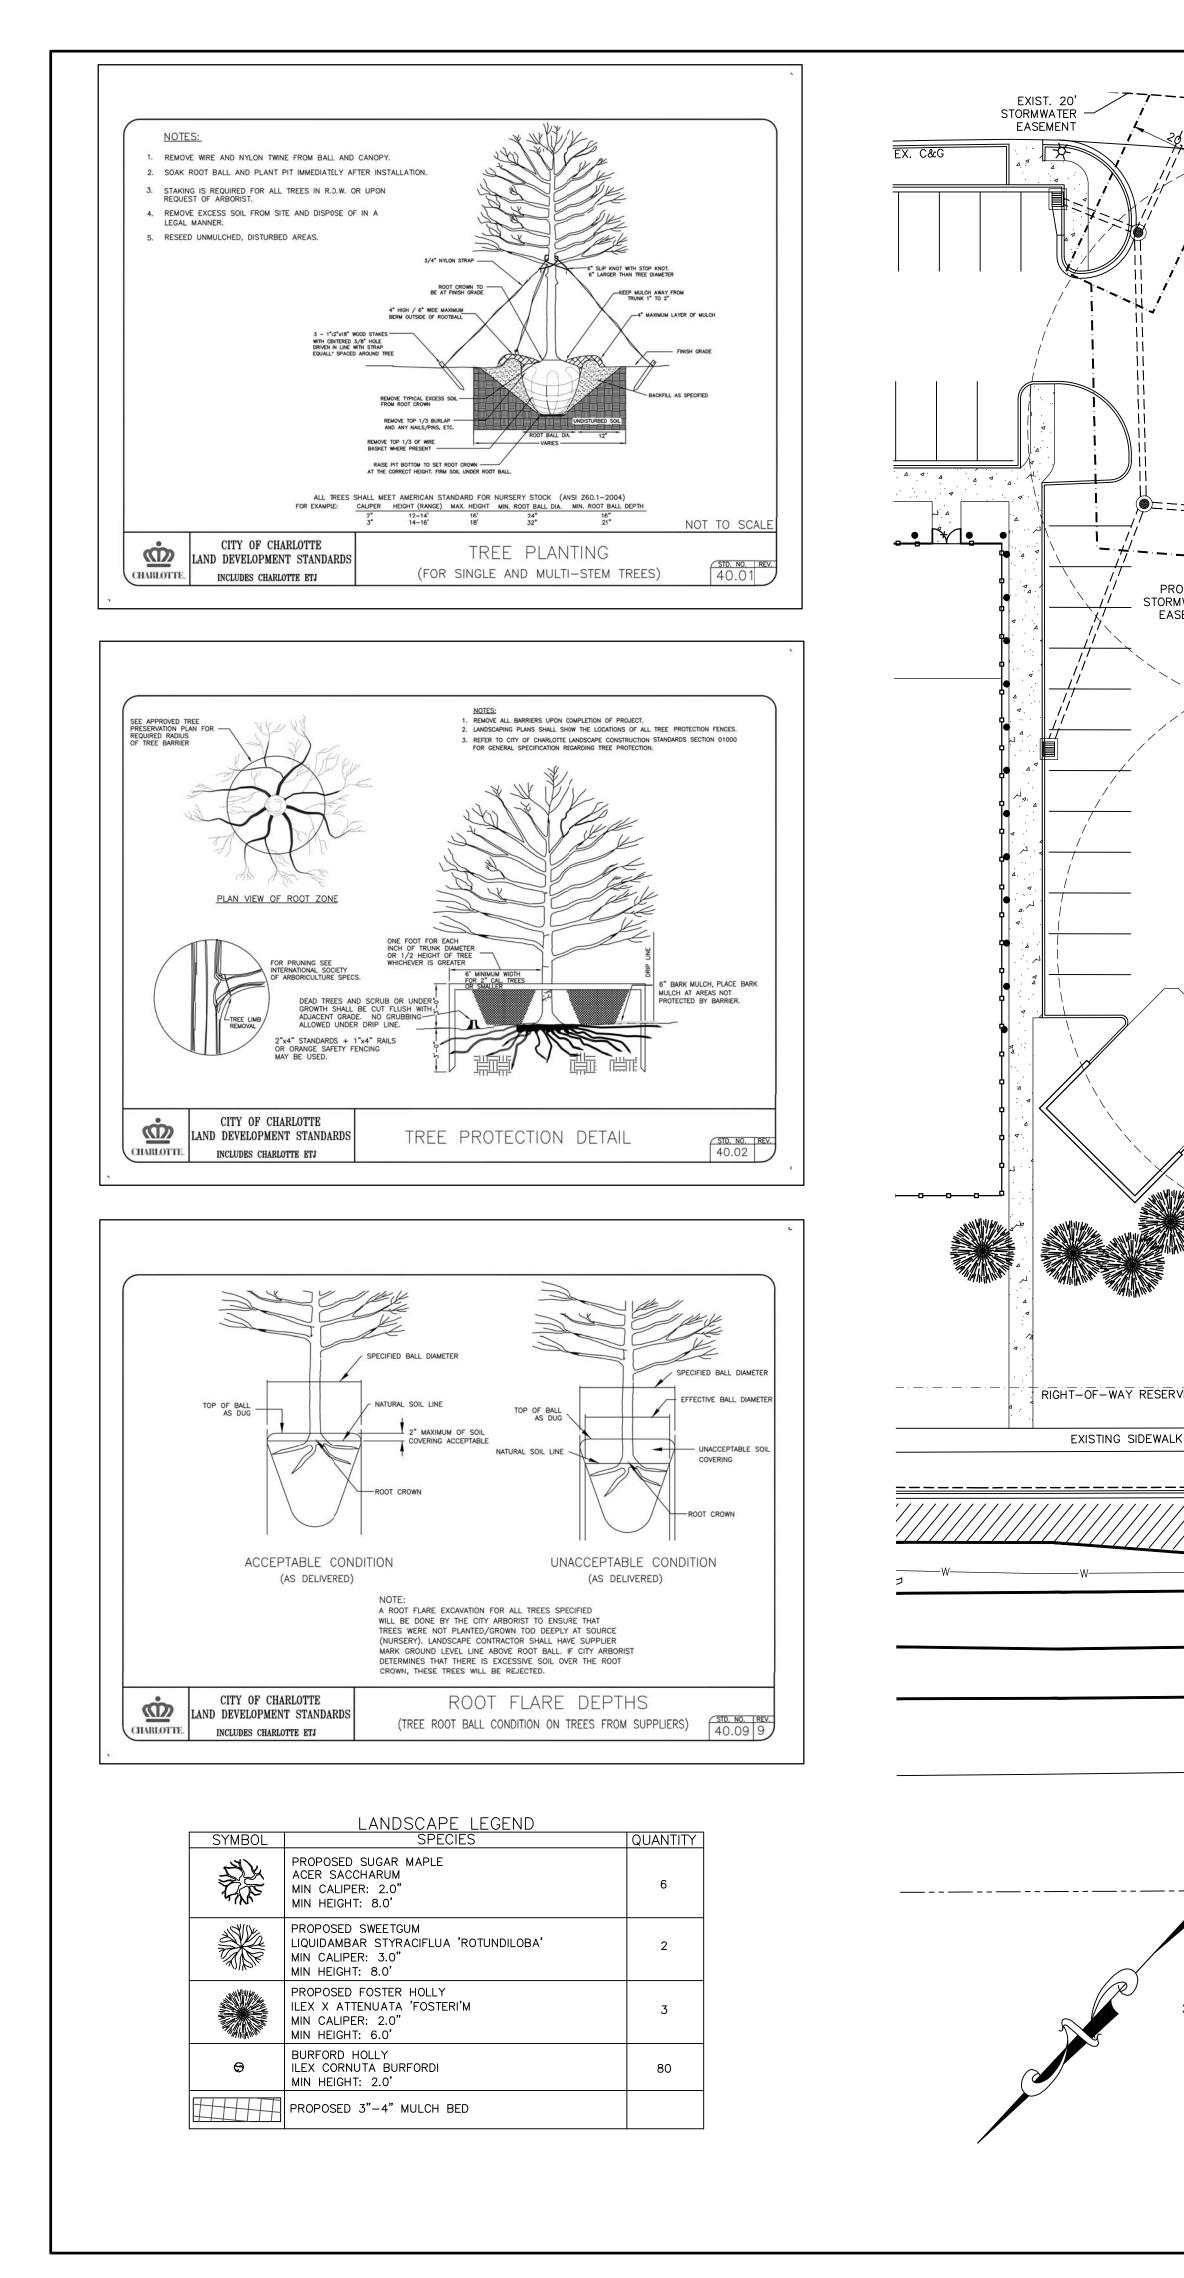


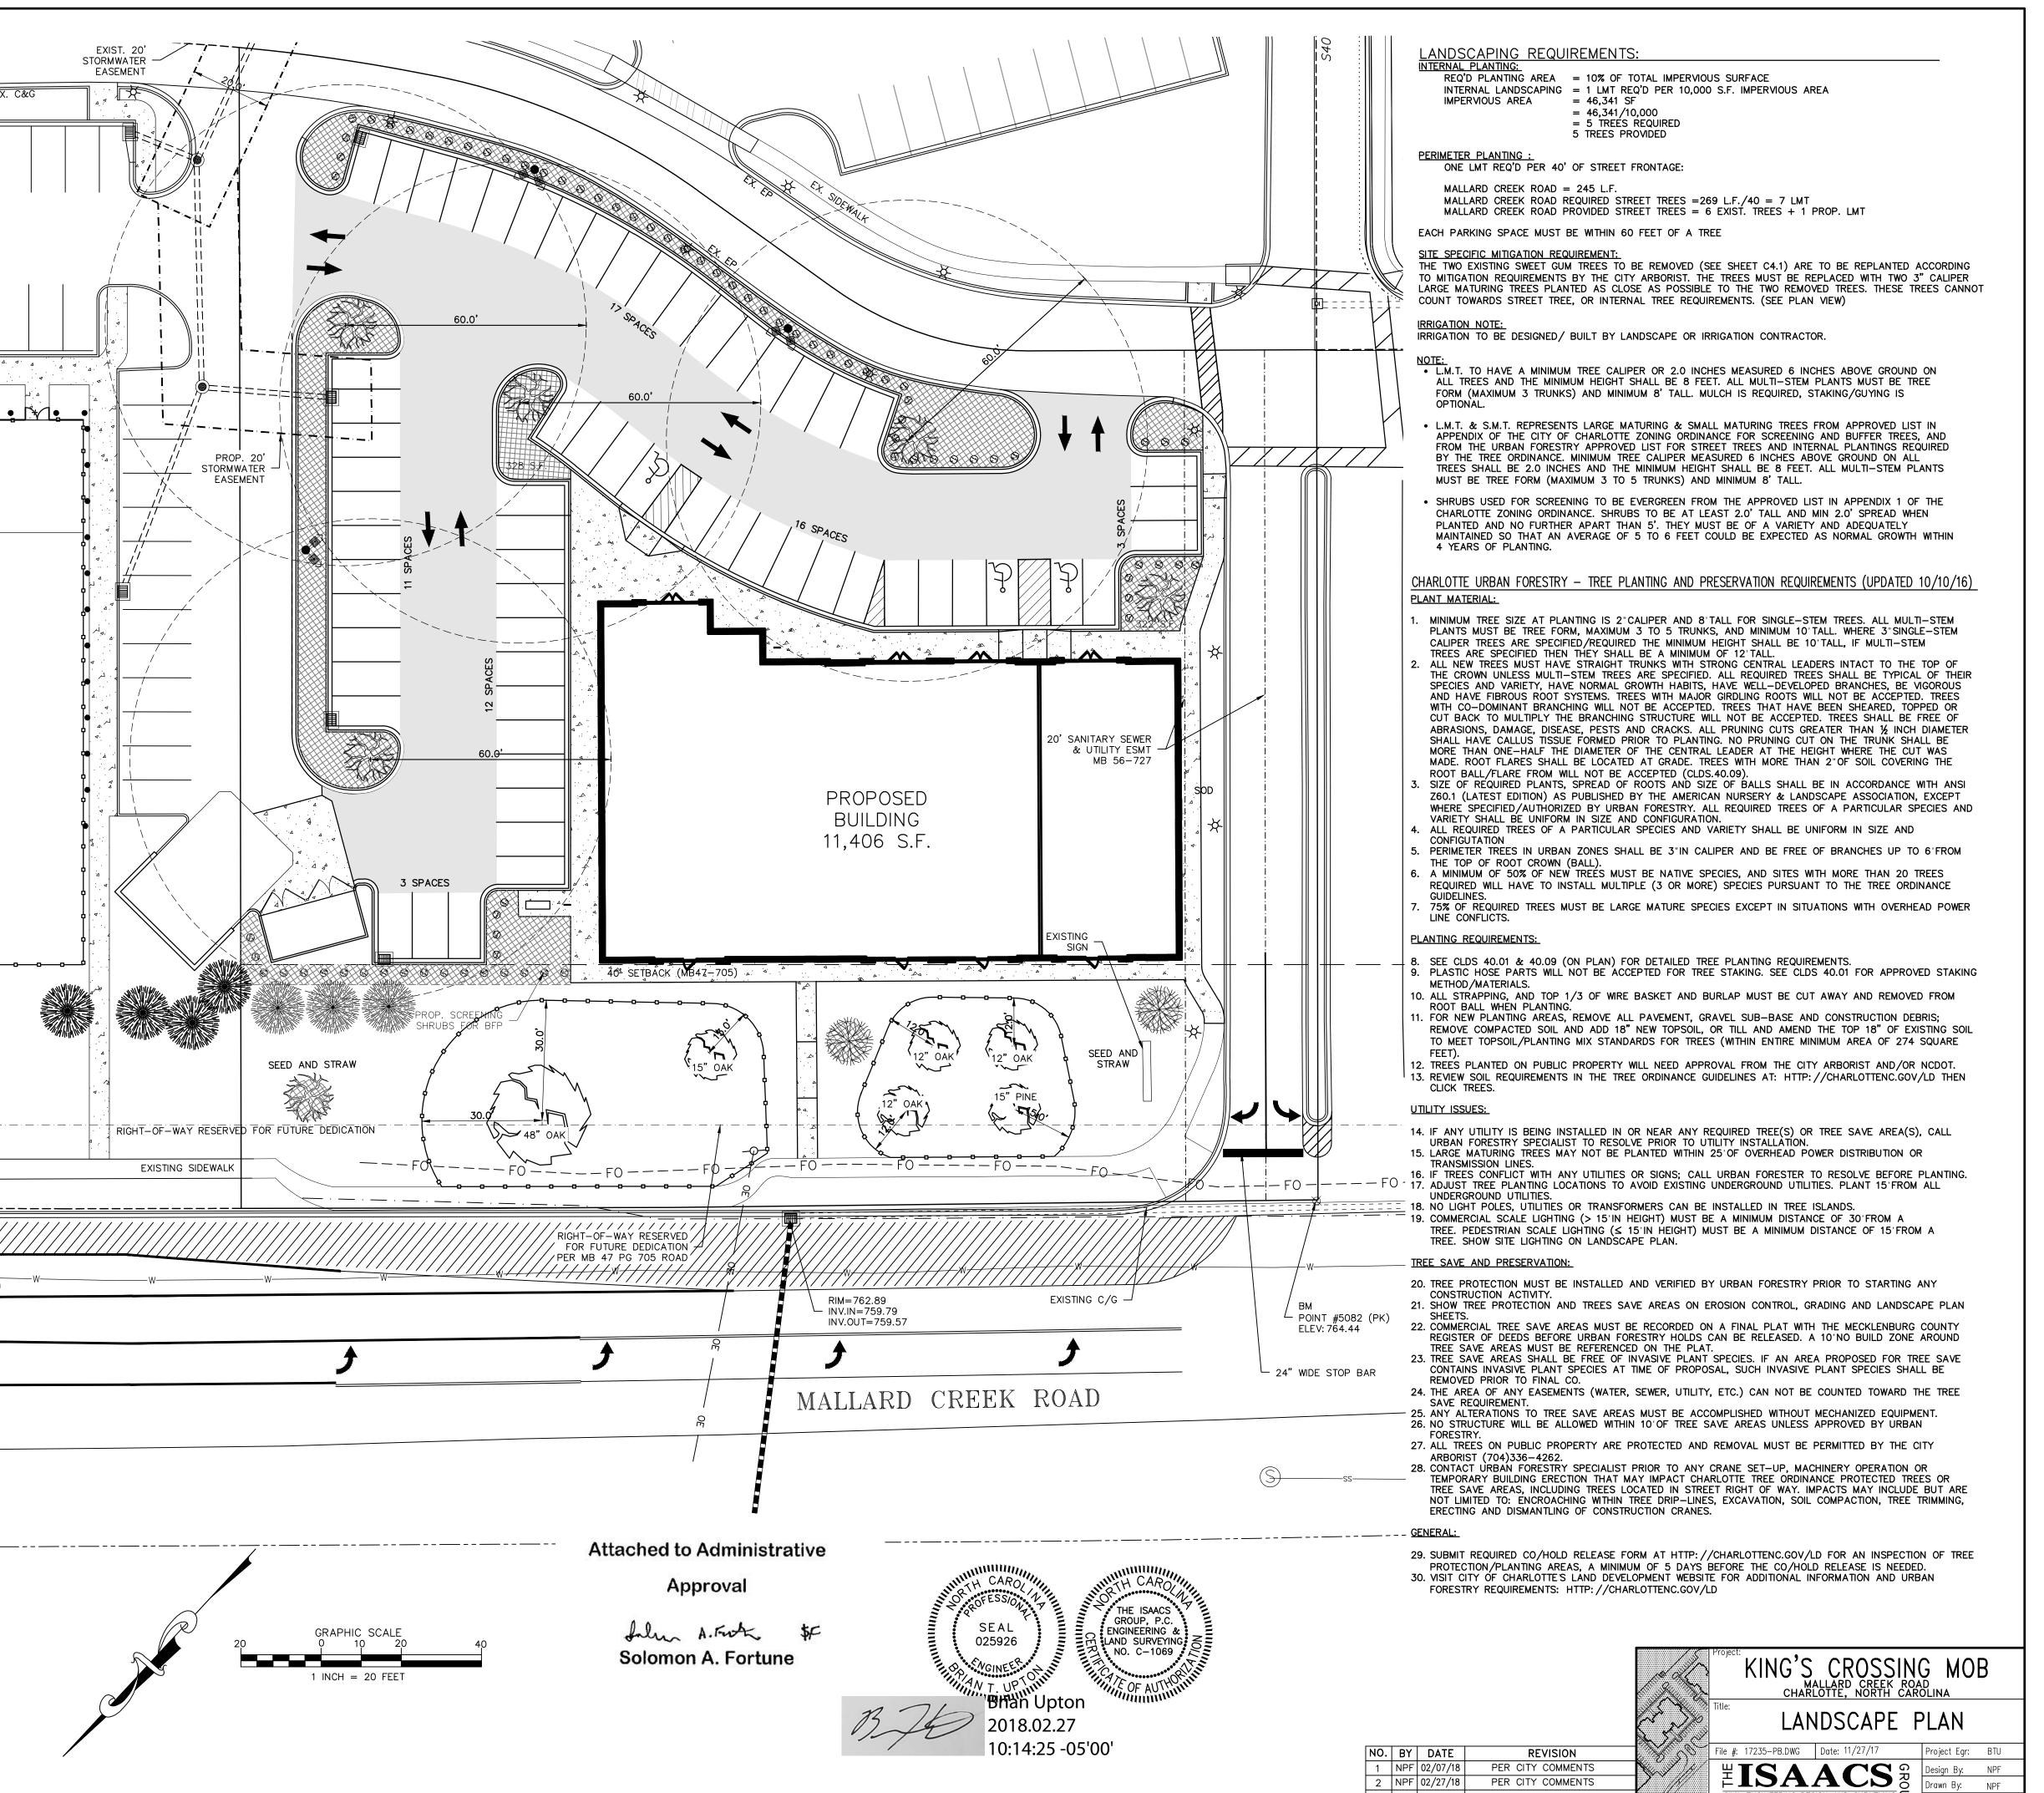

						ALLARD CREEK ROA	O IVIO	D
				Title:	LAN	IDSCAPE F	PLAN	
NO.	ΒY	DATE	REVISION	File #:	17235-PB.DWG	Date: 11/27/17	Project Egr:	BTU
1	NPF	02/07/18	PER CITY COMMENTS	<u></u> щ -			Design By:	NPF
2	NPF	02/27/18	PER CITY COMMENTS	⊢ -	ISA.	ACS	Drawn By:	NPF
				CIVIL	. ENGINEERING DES	SIGN AND SURVEYING	Scale:	1"=20'
				CH	ARLOTTE, N.C.	ARD, SUITE 420 28217 X (704) 527-8335	C1	.1

EXTERIOR FINISH SCEHDULE						
	BRICK VENEER					
BR-01	BRICK VENEER-					
	E.I.F.S.					
EIFS -01	E.I.F.S - BUILDING;					
EIFS -01	E.I.F.S - BUILDING;					

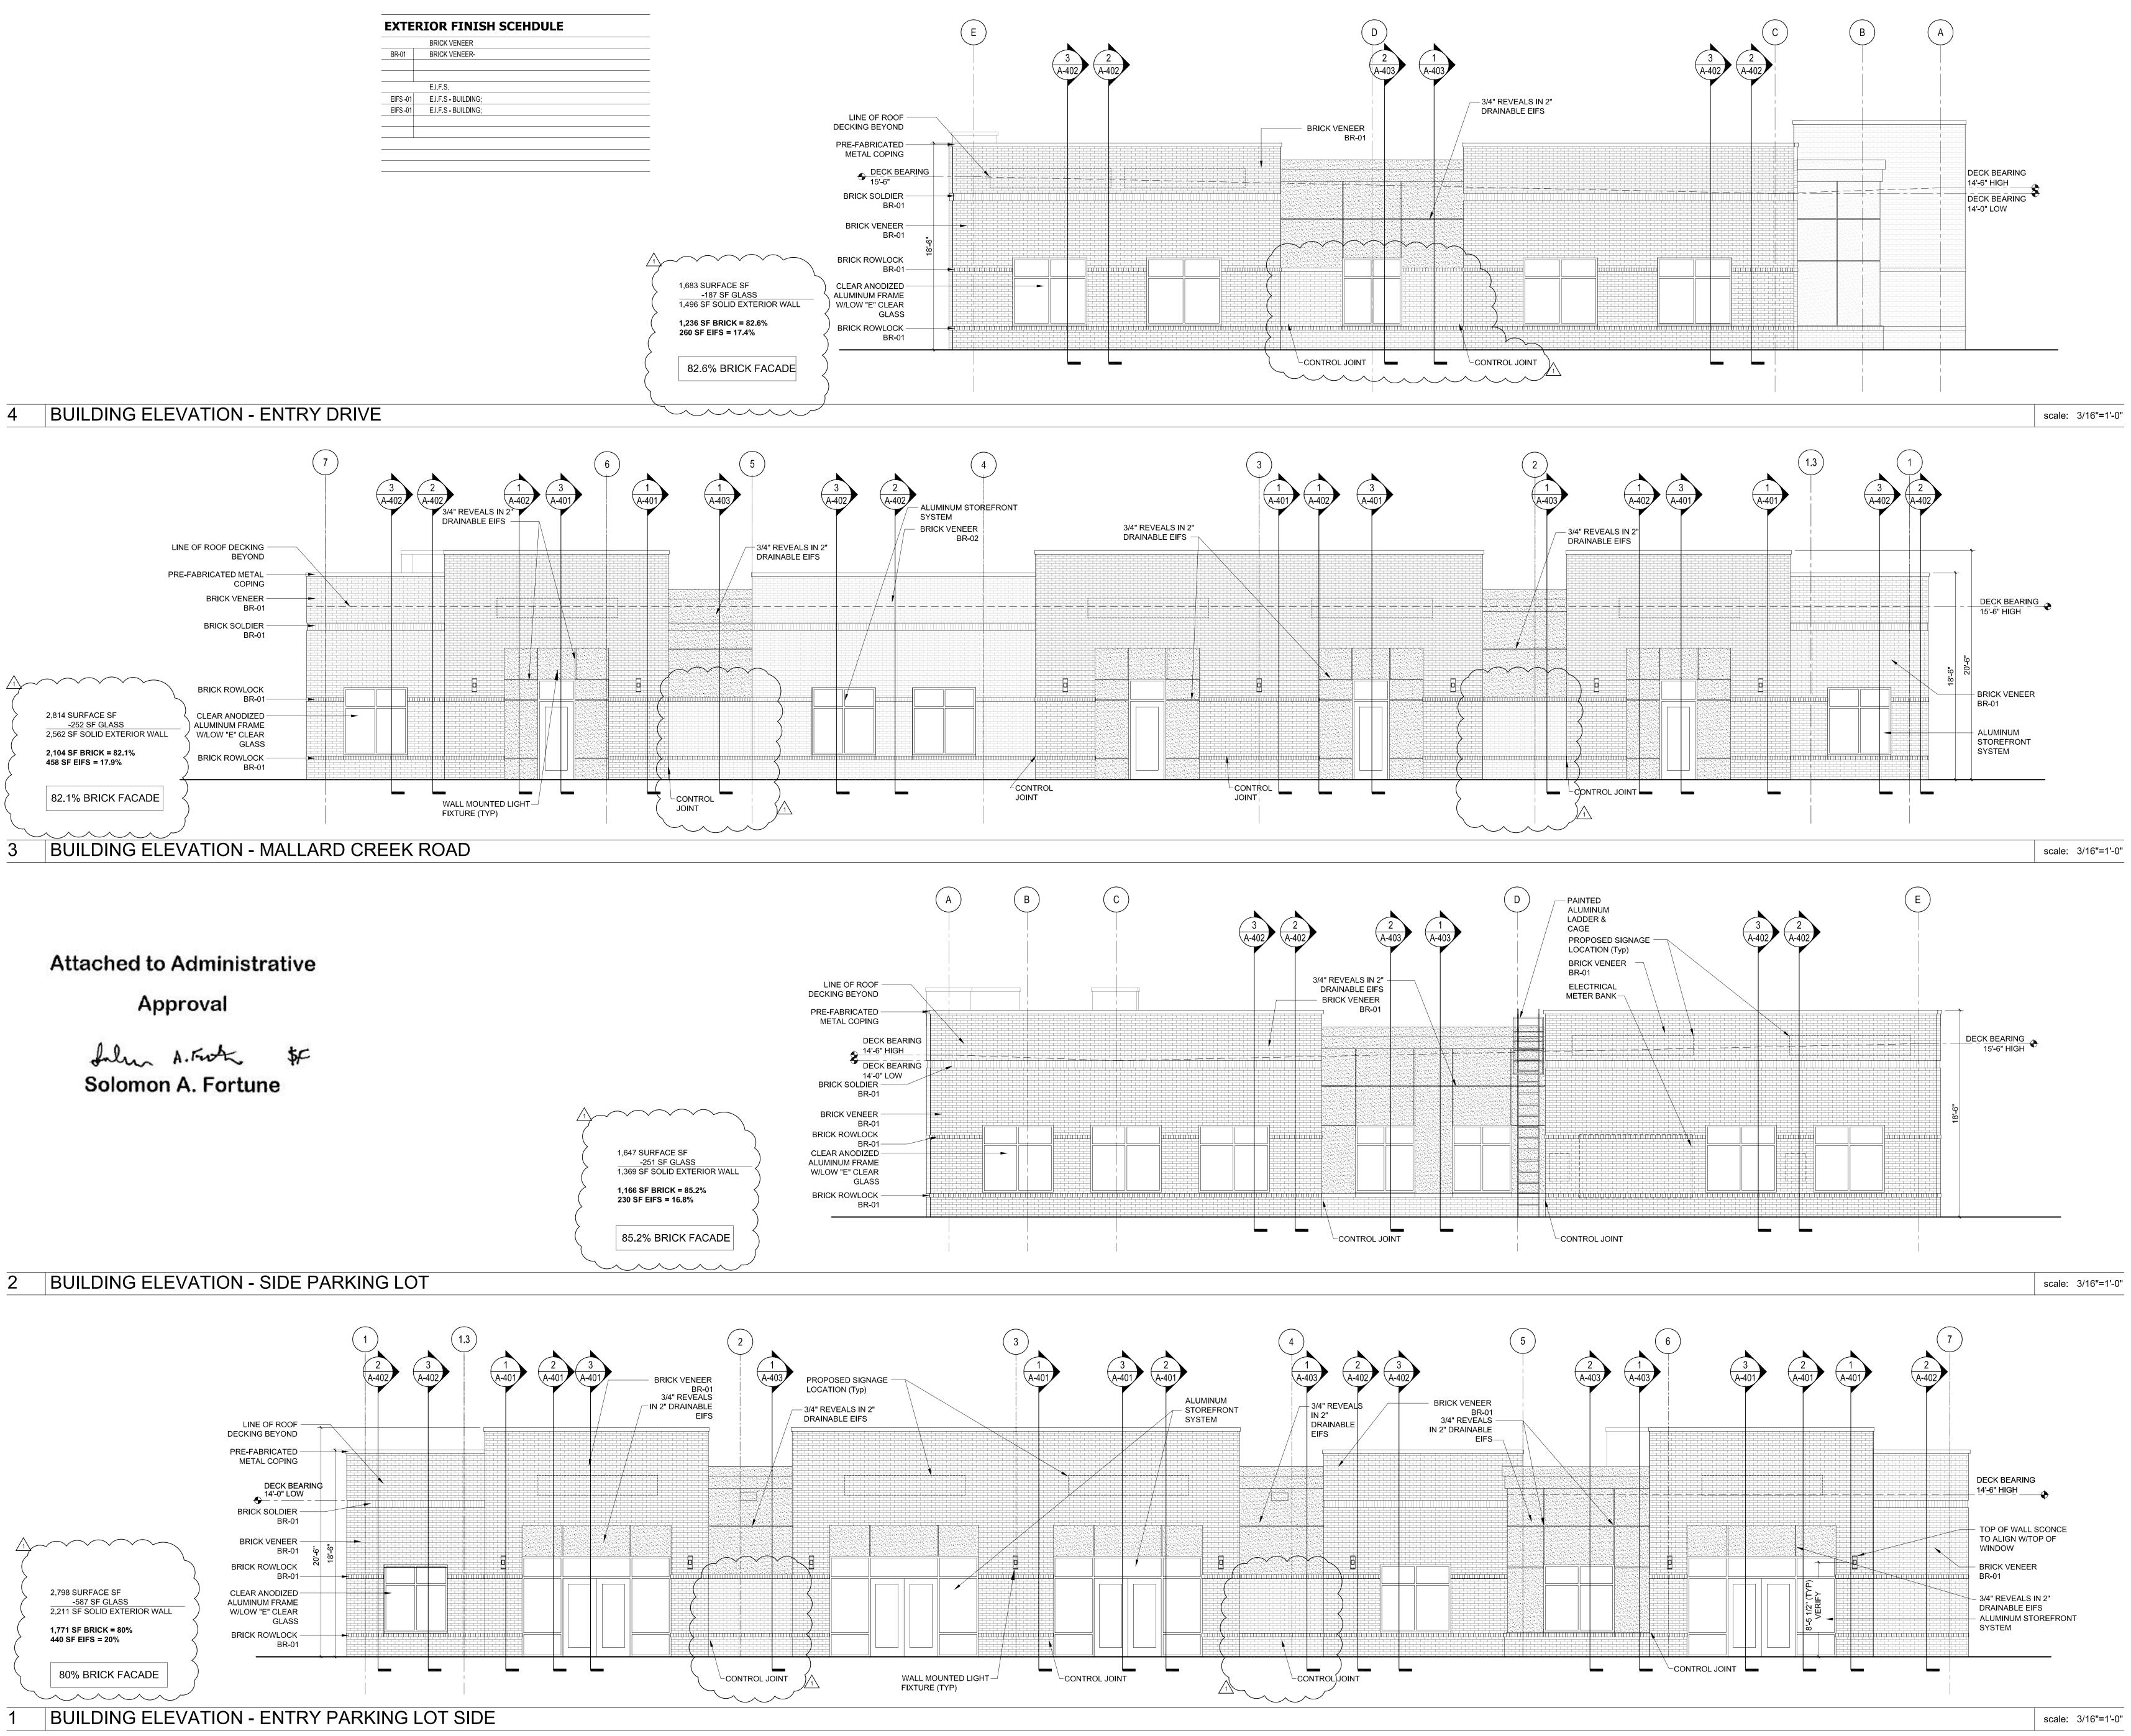

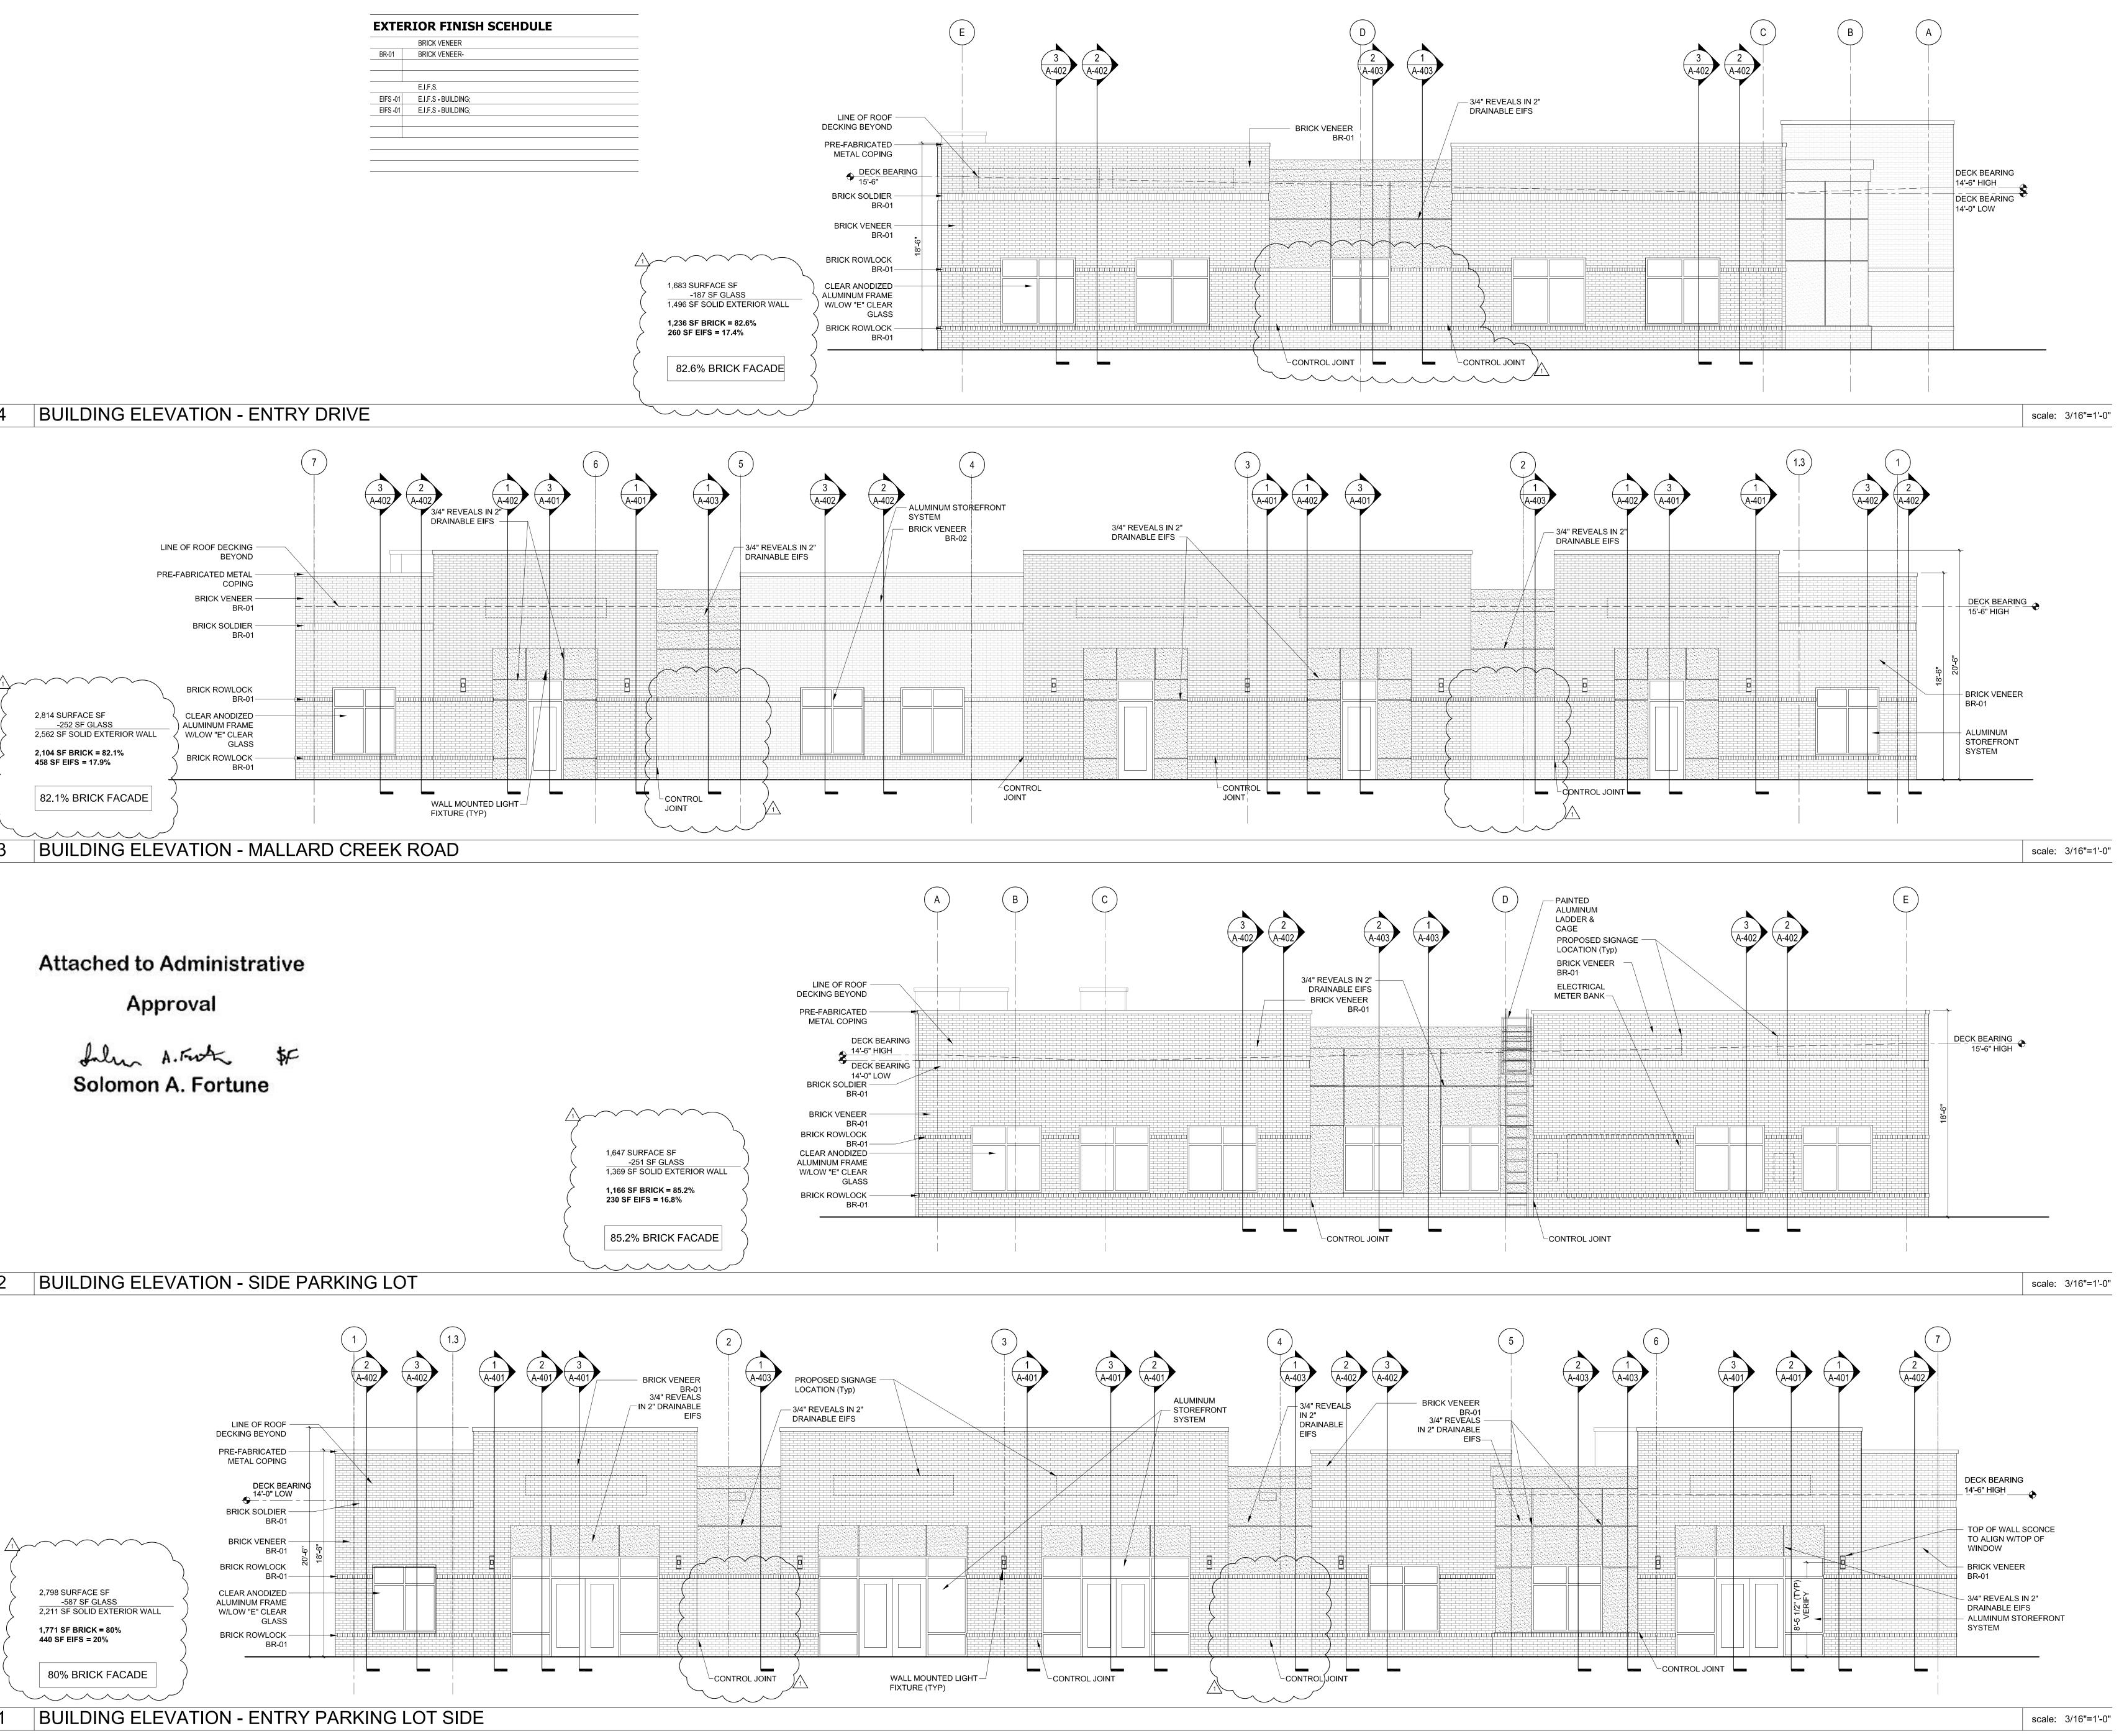



KINGS CROSSING

MEDICAL OFFICE BUILDING CHARLOTTE, NC ODA Project No. 163045 FOR CONSTRUCTION

01.19.2018

REVISIONS						
No.	Date					
1	Description CODE REVIEW COMMENTS	01.23.18				
L 1		-				



