
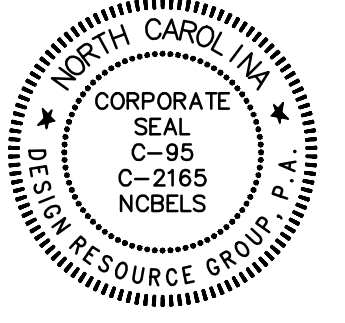


**SITE DATA**


TAX MAP NO:	029-651-01 & 029-651-02
PREVIOUS REZONING:	PETITION # 2012-074
EXISTING ZONING:	B-1(CD) & O-1(CD)
PROPOSED ZONING:	MUDD-O
SITE AREA:	±24.605 ACRES
PROPOSED USE:	MULTIFAMILY APARTMENTS, TOWNHOMES, POTENTIAL 1ST FLOOR OFFICE/NON-OFFICE COMMERCIAL
PROPOSED UNITS:	366 MULTIFAMILY APARTMENTS 56 TOWNHOMES TOTAL UNITS = 422
PROPOSED DENSITY:	17.15 DUA
BUILDING HEIGHT:	NOT TO EXCEED 65'
PARKING REQUIRED:	SHALL MEET ORDINANCE REQUIREMENTS
OPEN SPACE:	SHALL MEET ORDINANCE REQUIREMENTS
TREE SAVE:	CORRIDOR 150% - SHALL MEET THE TREE ORDINANCE REQUIREMENTS

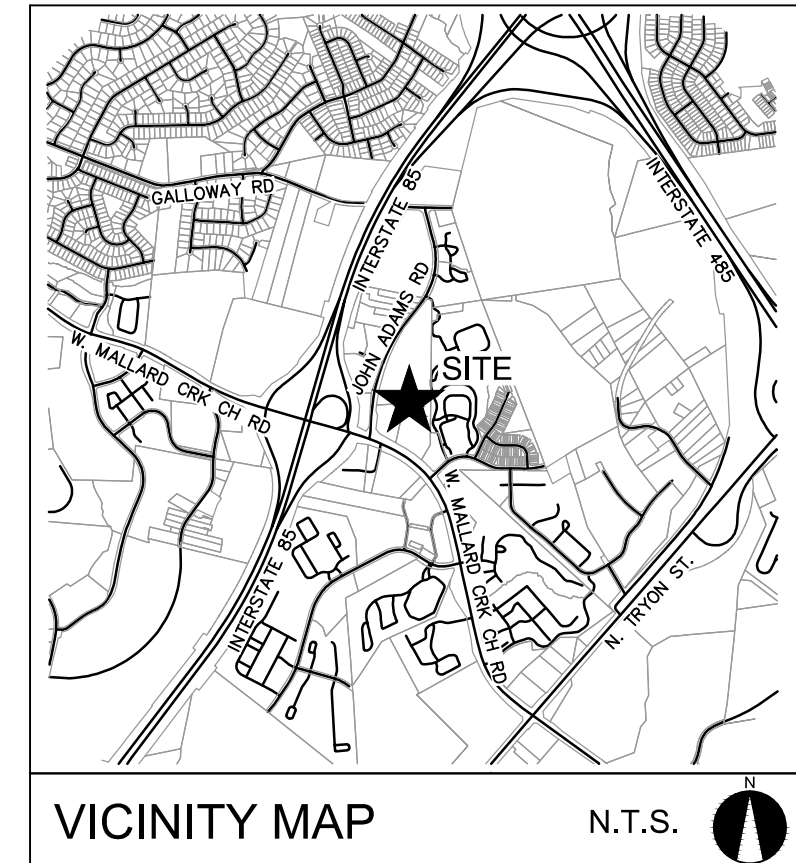

REZONING PETITION  
 FOR PUBLIC HEARING  
 2020-048  
 REZONING PETITION

**JOHN ADAMS PROPERTY**  
 CHARLOTTE, NORTH CAROLINA  
**FLOURNOY DEVELOPMENT GROUP**  
 1100 BROOKSTONE CENTRE PARKWAY  
 COLUMBUS, GA 31904


**TECHNICAL DATA SHEET**

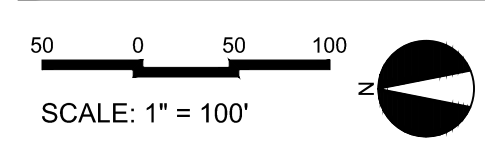


PROJECT #: 501-003  
 DRAWN BY: JO  
 CHECKED BY: NB

MARCH 5, 2020

REVISIONS:  
 1. 05/11/20 - PER REVIEW COMMENTS  
 2. 07/27/20 - PER REVIEW COMMENTS

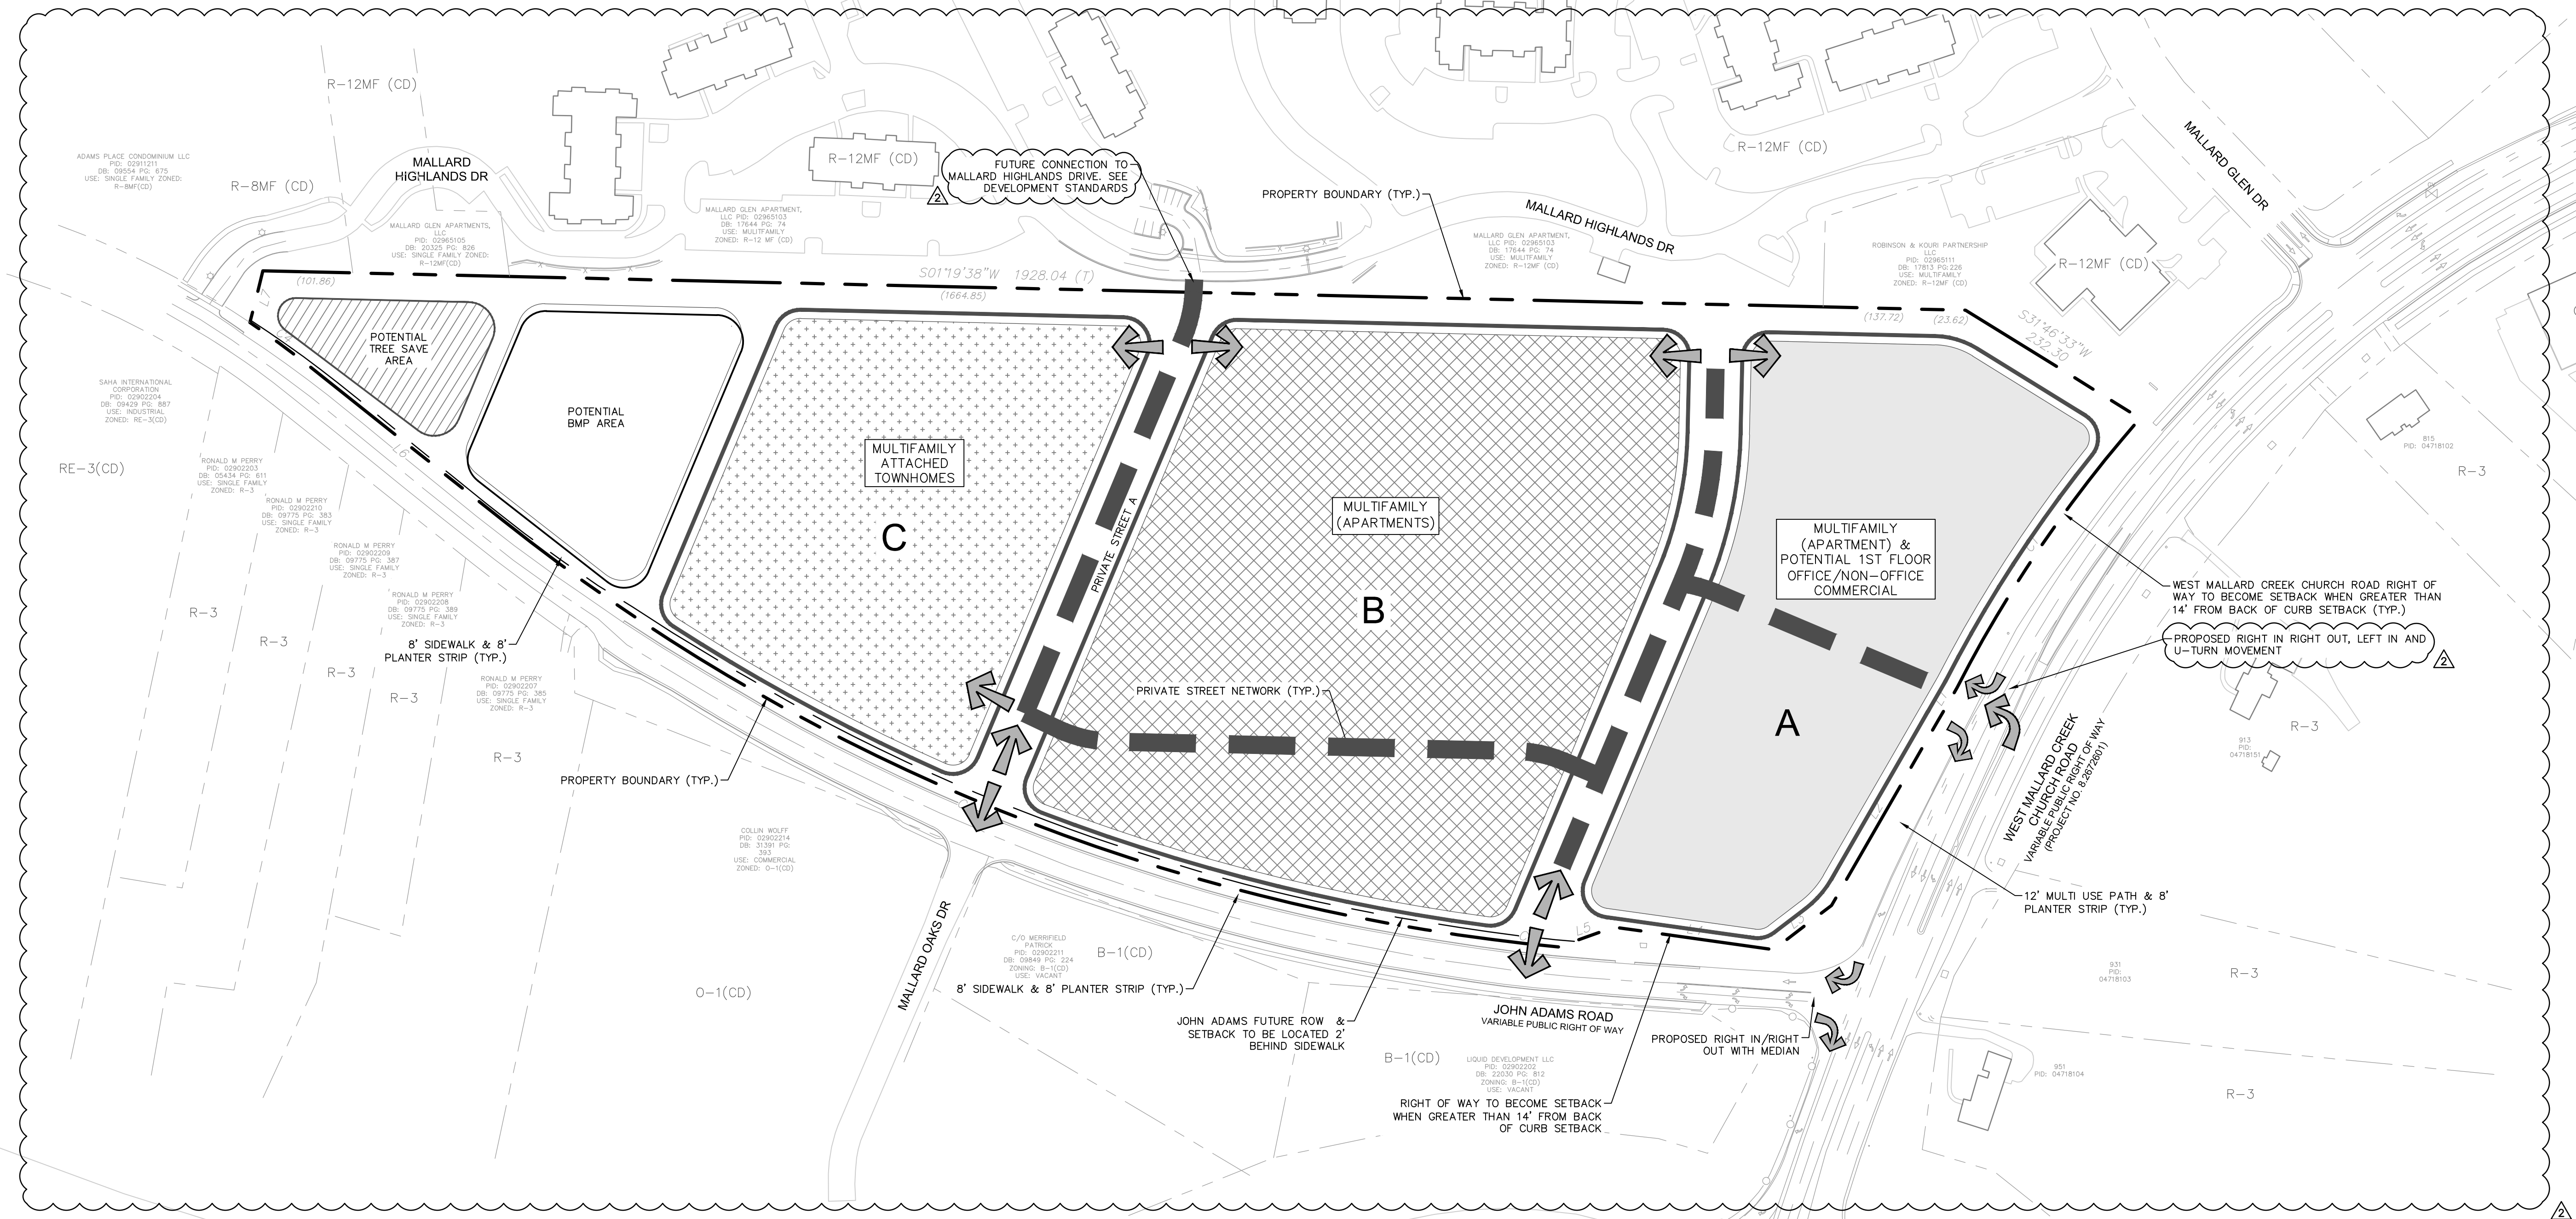



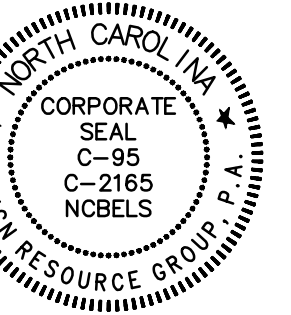

REZONING PETITION

FOR PUBLIC HEARING

2020-048

REZONING PETITION

JOHN ADAMS PROPERTY  
CHARLOTTE, NORTH CAROLINA

FLOURNOY DEVELOPMENT GROUP  
1100 BROOKSTONE CENTRE PARKWAY  
COLUMBUS, GA 31904

CONCEPTUAL  
SITE PLAN

50 0 50 100  
SCALE: 1" = 100'



PROJECT #: 501-003  
DRAWN BY: JO  
CHECKED BY: NB

MARCH 5, 2020

REVISIONS:  
1. 05/11/20 - PER REVIEW COMMENTS  
2. 07/27/20 - PER REVIEW COMMENTS

RZ 2.0

SITE DATA	
TAX MAP NO:	029-651-01 & 029-651-02
PREVIOUS REZONING:	PETITION # 2012-074
EXISTING ZONING:	B-1(CD) & O-1(CD)
PROPOSED ZONING:	MUDD-O
SITE AREA:	±24.605 ACRES
PROPOSED USE:	MULTIFAMILY APARTMENTS, TOWNHOMES, POTENTIAL 1ST FLOOR OFFICE/NON-OFFICE COMMERCIAL
PROPOSED UNITS:	366 MULTIFAMILY APARTMENTS 56 TOWNHOMES TOTAL UNITS = 422
PROPOSED DENSITY:	17.15 DUA
BUILDING HEIGHT:	NOT TO EXCEED 65'
PARKING REQUIRED:	SHALL MEET ORDINANCE REQUIREMENTS
OPEN SPACE:	SHALL MEET ORDINANCE REQUIREMENTS
TREE SAVE:	CORRIDOR 150% - SHALL MEET THE TREE ORDINANCE REQUIREMENTS

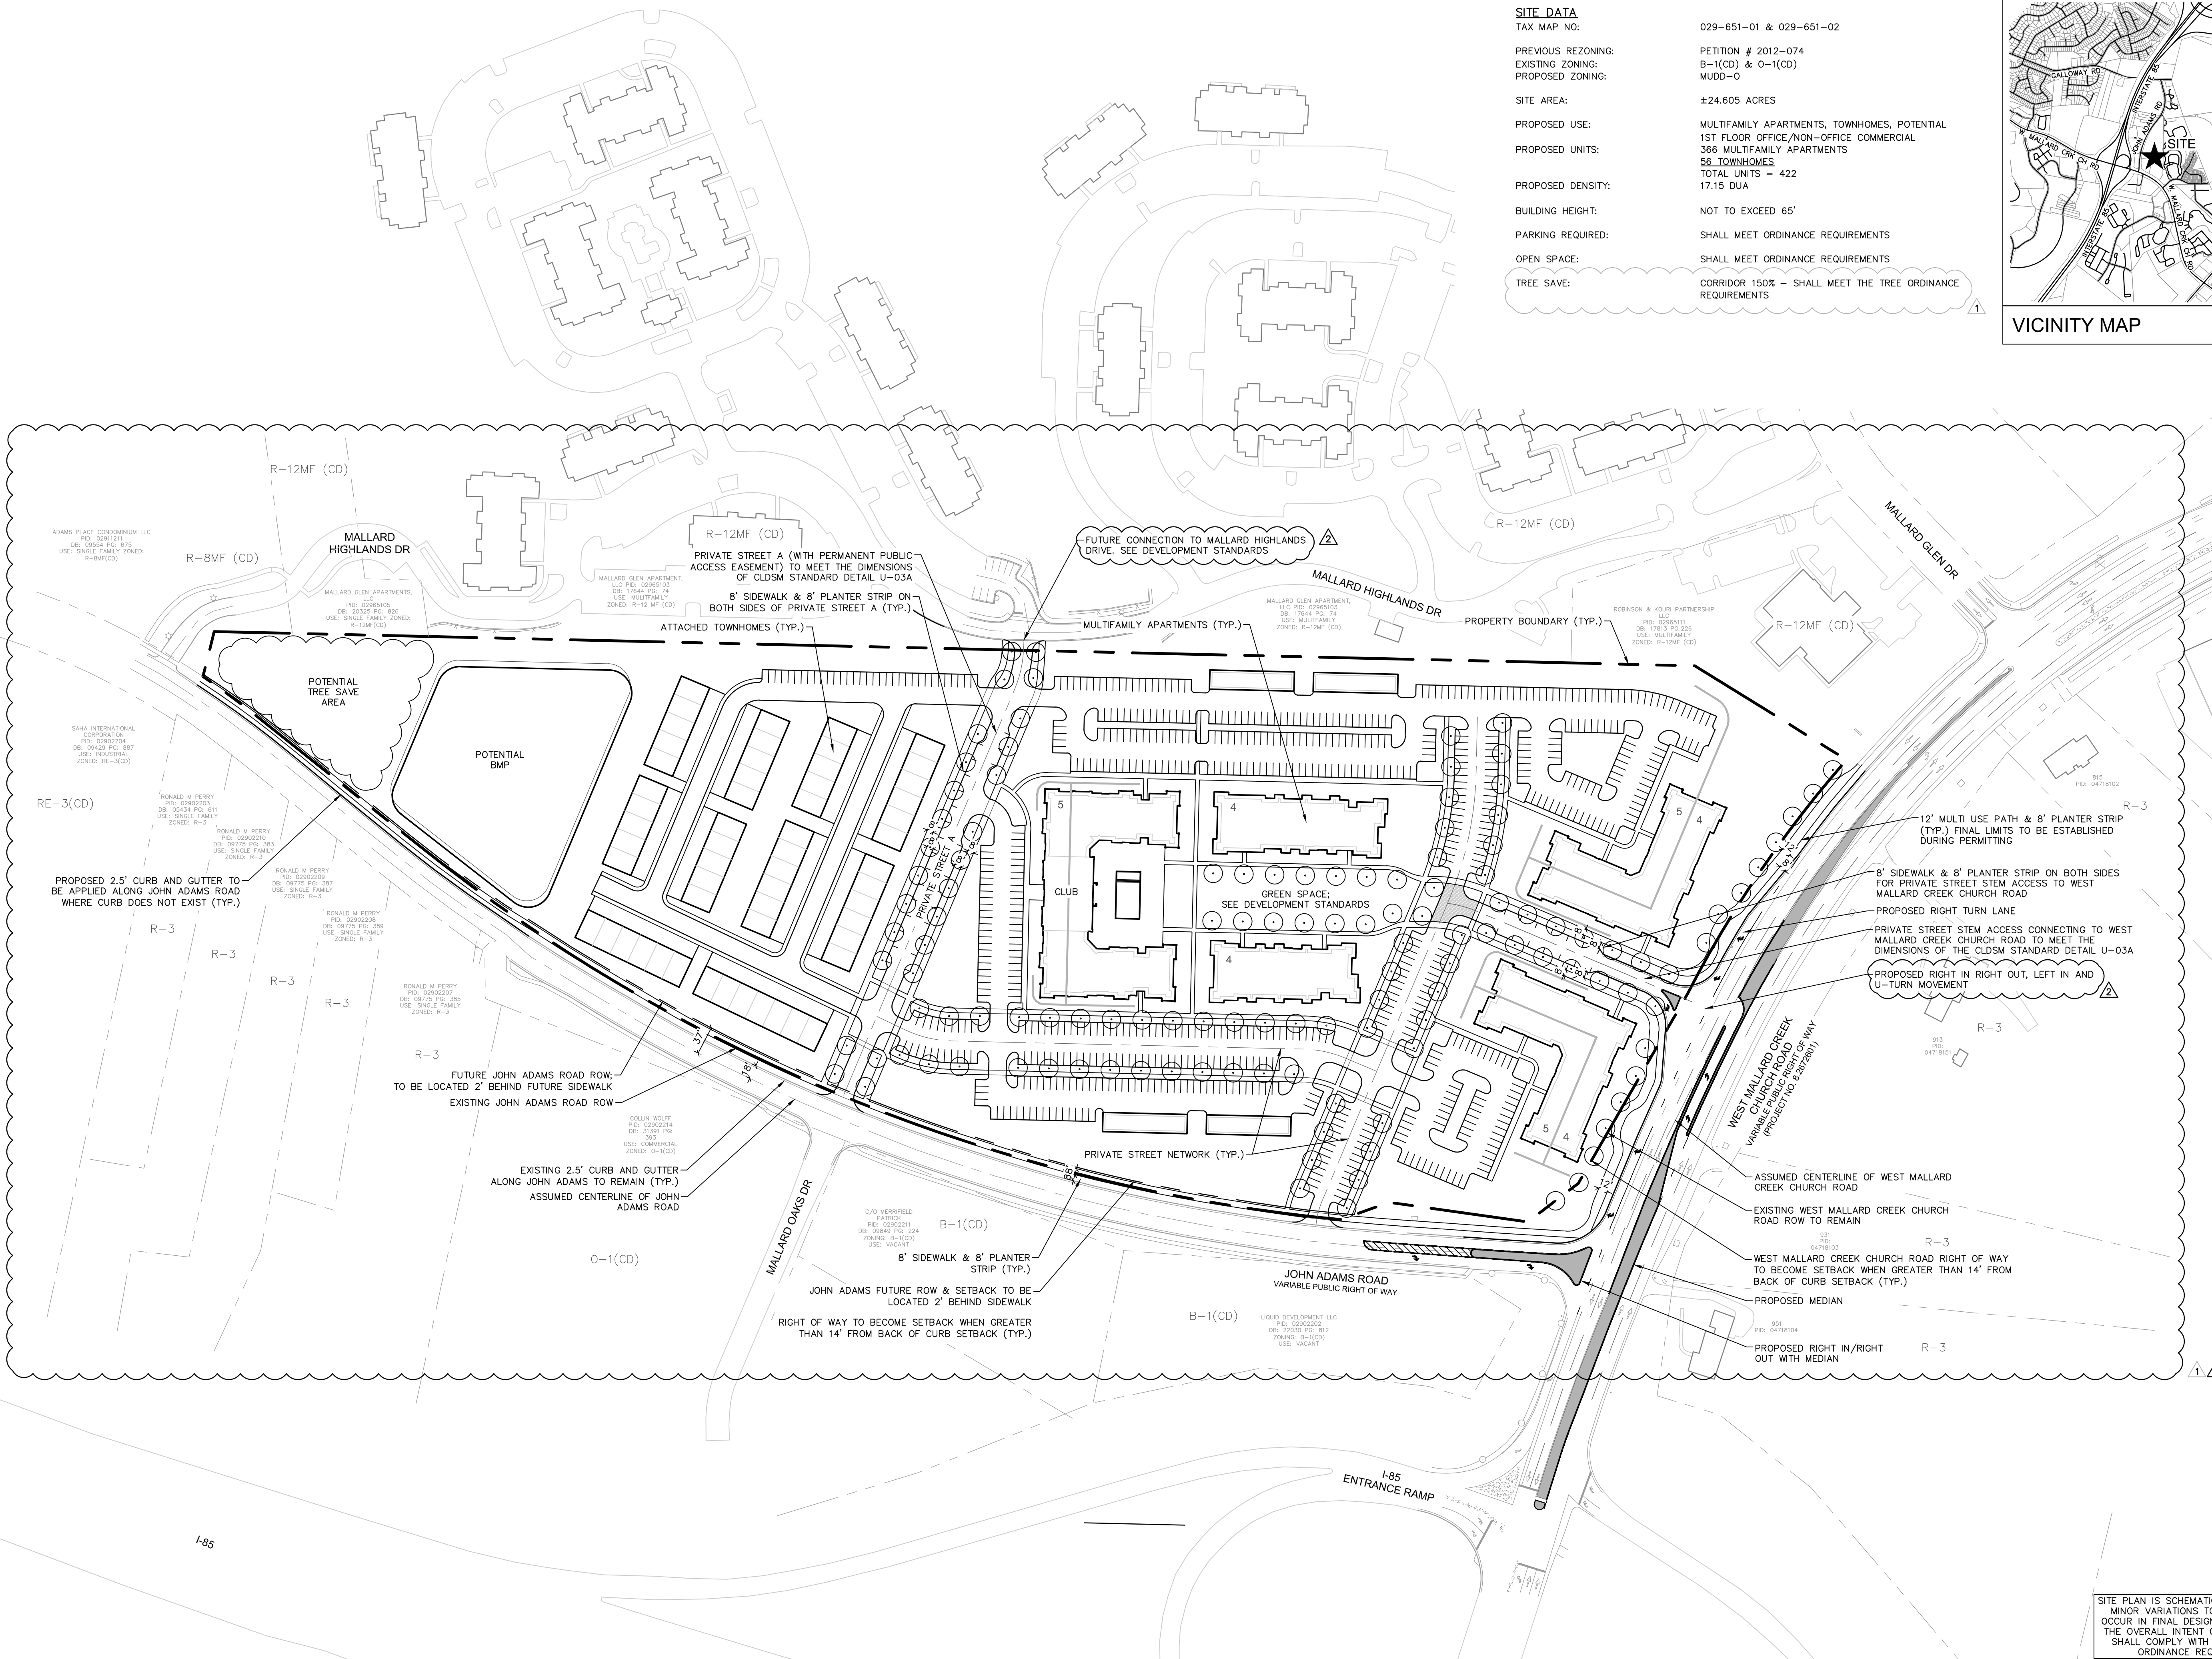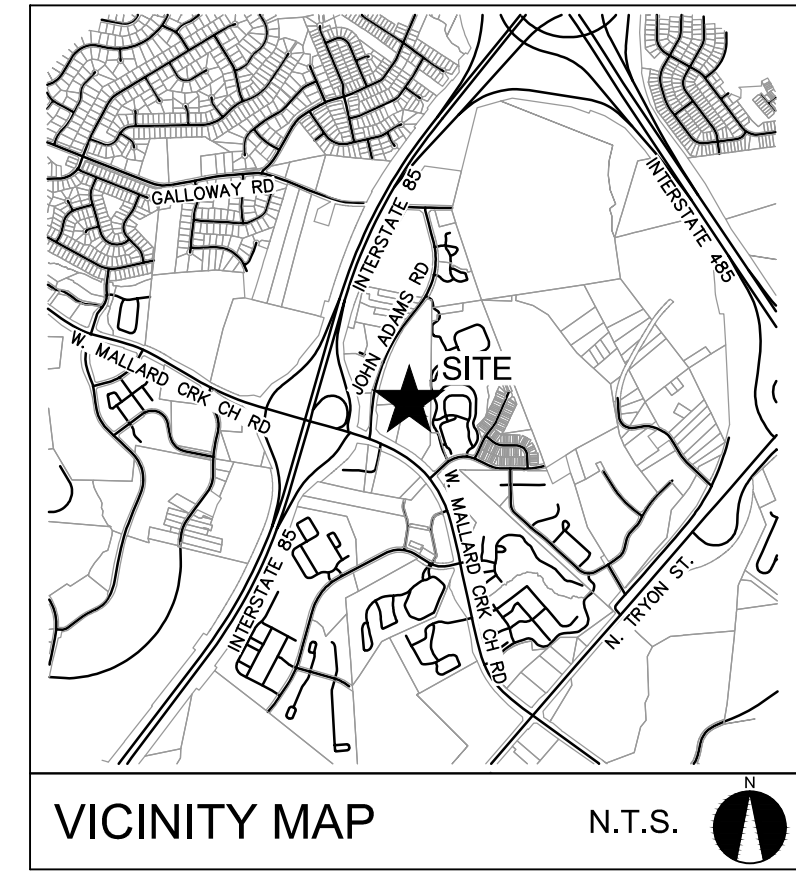

SITE PLAN IS SCHEMATIC IN NATURE. SOME MINOR VARIATIONS TO THE PLAN MAY OCCUR IN FINAL DESIGN BUT SHALL MEET THE OVERALL INTENT OF THIS PLAN AND SHALL COMPLY WITH THE APPLICABLE ORDINANCE REQUIREMENTS.



**SITE DEVELOPMENT DATA:**

- ACREAGE: ± 24.605 ACRES
- TAX PARCEL #: 029-651-01 AND 029-651-02
- EXISTING ZONING: B-1(CD) & 0-1(CD)
- PROPOSED ZONING: MUDD-O
- EXISTING USES: VACANT
- PROPOSED USES: RESIDENTIAL DWELLINGS UNITS AS PERMITTED BY RIGHT, AND UNDER PRESCRIBED CONDITIONS, AND UP TO 10,000 SQUARE FEET OF OFFICE AND NON-OFFICE COMMERCIAL USES, TOGETHER WITH ACCESSORY USES, AS ALLOWED IN THE MUDD ZONING DISTRICT (ALL AS MORE SPECIFICALLY DESCRIBED AND RESTRICTED BELOW IN SECTION 2).
- MAXIMUM NUMBER OF RESIDENTIAL DWELLING UNITS: UP TO 366 MULTI-FAMILY RESIDENTIAL DWELLING UNITS AND FIFTY-SIX (56) ATTACHED (TOWNHOME STYLE) UNITS, EITHER FOR SALE OR FOR RENT, AS ALLOWED BY RIGHT AND UNDER PRESCRIBED CONDITIONS IN THE MUDD ZONING DISTRICT.
- MAXIMUM BUILDING HEIGHT: NOT TO EXCEED 65 FEET. HEIGHT TO BE MEASURED PER THE ORDINANCE.
- PARKING: AS REQUIRED BY THE ORDINANCE.

**1. GENERAL PROVISIONS:**

a. SITE LOCATION. THESE DEVELOPMENT STANDARDS, THE TECHNICAL DATA SHEET, SCHEMATIC SITE PLAN AND OTHER SITE PLAN SHEETS FORM THIS REZONING PLAN (COLLECTIVELY REFERRED TO AS THE "REZONING PLAN") ASSOCIATED WITH THE REZONING PETITION FILED BY FLOURNOY DEVELOPMENT ("PETITIONER") TO ACCOMMODATE THE DEVELOPMENT OF A HIGH-QUALITY RESIDENTIAL COMMUNITY WITH GROUND FLOOR OFFICE AND NON-OFFICE COMMERCIAL USES ON AN APPROXIMATELY ±24.605 ACRE SITE LOCATED AT 900 AND 934 W. MALLARD CREEK CHURCH ROAD (THE "SITE").

b. ZONING DISTRICTS/ORDINANCE. DEVELOPMENT OF THE SITE WILL BE GOVERNED BY THE REZONING PLAN AS WELL AS THE APPLICABLE PROVISIONS OF THE CITY OF CHARLOTTE ZONING ORDINANCE (THE "ORDINANCE"). UNLESS THE REZONING PLAN ESTABLISHES MORE STRINGENT STANDARDS, THE REGULATIONS ESTABLISHED UNDER THE ORDINANCE FOR THE MUDD ZONING CLASSIFICATION SHALL GOVERN ALL DEVELOPMENT TAKING PLACE ON THE SITE, SUBJECT TO THE OPTIONAL PROVISIONS PROVIDED BELOW.

c. GRAPHICS AND ALTERATIONS. THE SCHEMATIC DEPICTIONS OF THE USES, PARKING AREAS, SIDEWALKS, STRUCTURES AND BUILDINGS, BUILDING ELEVATIONS, DRIVEWAYS, STREETS, BUILDING AND PARKING ENVELOPES OTHER DEVELOPMENT MATTERS AND SITE ELEMENTS (COLLECTIVELY THE "DEVELOPMENT/SITE ELEMENTS") SET FORTH ON THE REZONING PLAN SHOULD BE REVIEWED IN CONJUNCTION WITH THE PROVISIONS OF THESE DEVELOPMENT STANDARDS. THE LAYOUT, LOCATIONS, SIZES AND FORMULATIONS OF THE DEVELOPMENT/SITE ELEMENTS DEPICTED ON THE REZONING PLAN ARE GRAPHIC REPRESENTATIONS OF THE DEVELOPMENT/SITE ELEMENTS PROPOSED. CHANGES TO THE REZONING PLAN NOT ANTICIPATED BY THE REZONING PLAN WILL BE REVIEWED AND APPROVED AS ALLOWED BY SECTION 6.207 OF THE ORDINANCE.

SINCE THE PROJECT HAS NOT UNDERGONE THE DESIGN DEVELOPMENT AND CONSTRUCTION PHASES, IT IS INTENDED THAT THIS REZONING PLAN PROVIDE FOR FLEXIBILITY IN ALLOWING SOME ALTERATIONS OR MODIFICATIONS FROM THE GRAPHIC REPRESENTATIONS OF THE DEVELOPMENT/SITE ELEMENTS. THEREFORE, THERE MAY BE INSTANCES WHERE MINOR MODIFICATIONS WILL BE ALLOWED WITHOUT REQUIRING THE ADMINISTRATIVE AMENDMENT PROCESS PER SECTION 6.207 OF THE ORDINANCE. THESE INSTANCES WOULD INCLUDE CHANGES TO GRAPHICS IF THEY ARE:

- i. MINOR AND DON'T MATERIALLY CHANGE THE OVERALL DESIGN INTENT DEPICTED ON THE REZONING PLAN.

THE PLANNING DIRECTOR WILL DETERMINE IF SUCH MINOR MODIFICATIONS ARE ALLOWED PER THIS AMENDED PROCESS, AND IF IT IS DETERMINED THAT THE ALTERATION DOES NOT MEET THE CRITERIA DESCRIBED ABOVE, THE PETITIONER SHALL THEN FOLLOW THE ADMINISTRATIVE AMENDMENT PROCESS PER SECTION 6.207 OF THE ORDINANCE; IN EACH INSTANCE, HOWEVER, SUBJECT TO THE PETITIONER'S APPEAL RIGHTS SET FORTH IN THE ORDINANCE.

d. NUMBER OF BUILDINGS PRINCIPAL AND ACCESSORY. THE TOTAL NUMBER OF PRINCIPAL BUILDINGS TO BE DEVELOPED ON THE SITE WILL BE LIMITED TO NINETEEN (19). ACCESSORY BUILDINGS AND STRUCTURES LOCATED ON THE SITE SHALL NOT BE CONSIDERED IN ANY LIMITATION ON THE NUMBER OF BUILDINGS ON THE SITE. ACCESSORY BUILDINGS AND STRUCTURES WILL BE CONSTRUCTED UTILIZING SIMILAR BUILDING MATERIALS, COLORS, ARCHITECTURAL ELEMENTS AND DESIGNS AS THE PRINCIPAL BUILDING(S) LOCATED WITHIN THE SAME DEVELOPMENT AREA AS THE ACCESSORY STRUCTURE/BUILDING.

**2. PERMITTED USES, DEVELOPMENT AREA LIMITATIONS:**

a. THE PRINCIPAL BUILDINGS CONSTRUCTED ON THE SITE MAY BE DEVELOPED WITH UP TO 366 MULTI-FAMILY RESIDENTIAL DWELLINGS UNITS, FIFTY-SIX (56) ATTACHED (TOWNHOME STYLE) UNITS, EITHER FOR SALE OR FOR RENT, AND UP TO 10,000 SQUARE FEET OF OFFICE AND/OR COMMERCIAL USES AS PERMITTED BY RIGHT, UNDER PRESCRIBED CONDITIONS ABOVE TOGETHER WITH ACCESSORY USES ALLOWED IN THE MUDD ZONING DISTRICT SUBJECT TO THE FOLLOWING:

- i. NO SINGLE OFFICE OR COMMERCIAL SPACE SHALL BE GREATER THAN 2,500 SQUARE FEET.
- ii. EDEE USES SHALL BE LIMITED TO LIMITED SERVICE RESTAURANTS.

A "LIMITED SERVICE RESTAURANT" SHALL MEAN A RESTAURANT WITH NO MORE THAN 2,000 SQUARE FEET OF GROSS FLOOR AREA SERVING PRIMARILY ITEMS THAT DO NOT REQUIRE ON-PREMISE COOKING OF FOOD (OTHER THAN HEATING, MICRO-WAVE COOKING OR SIMILAR PROCESS AND THE BAKING OF PREMIXED DOUGH).

**3. OPTIONAL PROVISIONS:**

a. TO ALLOW PARKING AND CIRCULATION BETWEEN THE BUILDINGS IN DEVELOPMENT AREAS A AND B AND THE STREET AS GENERALLY DEPICTED ON SHEET RZ-02.

**4. ACCESS AND TRANSPORTATION IMPROVEMENTS:**

a. ACCESS TO THE SITE WILL BE FROM JOHN ADAMS ROAD AND W. MALLARD CREEK CHURCH ROAD AS GENERALLY DEPICTED ON SHEET RZ-01.

b. PRIVATE STREET A SHALL CONNECT TO MALLARD HIGHLANDS DRIVE AS FEASIBLE AND WILL BE CONSTRUCTED TO MEET THE SUBDIVISION REGULATIONS.

c. THE ALIGNMENT OF THE VEHICULAR CIRCULATION AND DRIVEWAYS MAY BE MODIFIED BY THE PETITIONER TO ACCOMMODATE CHANGES IN TRAFFIC PATTERNS, PARKING LAYOUTS AND ANY ADJUSTMENTS REQUIRED FOR APPROVAL BY THE CHARLOTTE DEPARTMENT OF TRANSPORTATION (CDOT) AND/OR NCDOT IN ACCORDANCE WITH PUBLISHED STANDARDS SO LONG AS THE STREET NETWORK SET FORTH ON THE REZONING PLAN IS NOT MATERIALLY ALTERED.

d. ALL REQUIRED ROADWAY IMPROVEMENT WILL BE APPROVED AND CONSTRUCTED PRIOR TO THE ISSUANCE OF THE CERTIFICATE OF OCCUPANCY FOR THE FIRST BUILDING ON THE SITE SUBJECT TO THE PETITIONER'S ABILITY TO POST A BOND FOR ANY IMPROVEMENTS NOT IN PLACE AT THE TIME OF THE ISSUANCE OF THE FIRST CERTIFICATE OF OCCUPANCY.

e. THE PETITIONER WILL DEDICATE VIA FEE SIMPLE CONVEYANCE ANY ADDITIONAL RIGHT-OF-WAY INDICATED ON THE REZONING PLAN AS RIGHT-OF-WAY TO BE DEDICATED. THE ADDITIONAL RIGHT-OF-WAY WILL BE DEDICATED PRIOR TO THE ISSUANCE OF THE FIRST CERTIFICATE OF OCCUPANCY. THE PETITIONER WILL PROVIDE A PERMANENT SIDEWALK EASEMENT FOR ANY OF THE PROPOSED SIDEWALKS LOCATED ALONG THE PUBLIC STREETS LOCATED OUTSIDE OF THE RIGHT-OF-WAY WHERE ROW DEDICATION IS NOT PROVIDED. THE PERMANENT SIDEWALK EASEMENT WILL BE LOCATED A MINIMUM OF TWO (2) FEET BEHIND THE SIDEWALK WHERE FEASIBLE.

**5. STREETSCAPE, BUFFER, LANDSCAPING OPEN SPACE AND SCREENING:**

a. A THIRTY (30) FOOT SETBACK AS MEASURED FROM THE EXISTING AND/OR FUTURE BACK OF CURB ALONG W. MALLARD CREEK CHURCH ROAD WILL BE PROVIDED.

b. A TWENTY (20) FOOT SETBACK AS MEASURED FROM THE EXISTING AND/OR FUTURE BACK OF CURB ALONG JOHN ADAMS ROAD AND PUBLIC STREET A WILL BE PROVIDED.

c. AN EIGHT (8) FOOT PLANTING STRIP AND A TWELVE (12) FOOT SIDEWALK WILL BE PROVIDED ALONG THE SITE'S FRONTAGE ON W. MALLARD CREEK CHURCH ROAD.

d. AN EIGHT (8) FOOT PLANTING STRIP AND AN EIGHT (8) FOOT SIDEWALK WILL BE PROVIDED ALONG PUBLIC STREET A AND JOHN ADAMS ROAD AS GENERALLY DEPICTED.

e. THE PETITIONER WILL PROVIDE AN IMPROVED OPEN SPACE AMENITY AREA AS GENERALLY DEPICTED ON THE REZONING PLAN. THE IMPROVED OPEN SPACE AREA WILL CONTAIN A MINIMUM OF 15,000 SQUARE FEET AND WILL BE IMPROVED WITH LANDSCAPING, HARDSCAPE AREAS, WALKWAYS, SEATING AREAS, AND LIGHTING.

f. METER BANKS WILL BE SCREENED WHERE VISIBLE FROM PUBLIC VIEW AT GRADE LEVEL.

g. THE PETITIONER MAY CHOOSE TO LOCATE THE REQUIRED DUMPSTER AND RECYCLING CONTAINERS OUTSIDE OF THE BUILDINGS IN DUMPSTERS OR IN A TRASH COMPACTOR. THE FINAL LOCATION OF THE TRASH HANDLING CONTAINERS TO BE DETERMINED DURING THE LAND DEVELOPMENT APPROVAL PROCESS.

**6. GENERAL DESIGN GUIDELINES:**

a. THE BUILDING MATERIALS USED ON THE PRINCIPAL BUILDINGS CONSTRUCTED ON SITE WILL BE A COMBINATION OF PORTIONS OF THE FOLLOWING: BRICK, STONE, PRECAST STONE, PRECAST CONCRETE, SYNTHETIC STONE, CEMENTITIOUS FIBER BOARD, STUCCO, EIFS, DECORATIVE BLOCK AND/OR WOOD ("PROFFERED EXTERIOR BUILDING MATERIALS"). VINYL OR ALUMINUM AS A BUILDING MATERIAL MAY ONLY BE USED ON WINDOWS, SOFFITS AND ON HANDRAILS/RAILINGS. THE PROPOSED BUILDING WILL BE DESIGNED AND CONSTRUCTED SO THAT EACH BUILDING ELEVATION(S) THAT ABUT/FACE AN EXISTING OR PROPOSED PUBLIC OR PRIVATE STREET HAVE AT LEAST 25% MASONRY (INCLUDING BUT NOT LIMITED TO BRICK, STONE, PRECAST BRICK, PRECAST STONE, AND/OR STUCCO) INCLUDING WINDOWS, DOORS AND ROOFS.

b. THE MAXIMUM CONTIGUOUS AREA WITHOUT WINDOWS OR DOORS ON ANY FLOOR SHALL NOT EXCEED 20 FEET IN LENGTH. WHERE BLANK OR UNARTICULATED WALLS 20' OR GREATER CANNOT BE ADDRESSED PRINCIPALLY WITH DOORS OR WINDOWS, THEY SHALL BE TREATED WITH A COMBINATION THE FOLLOWING OPTIONS: (I) A HIGHER LEVEL OF TRANSPARENCY ON THE GROUND FLOOR (EXAGGERATED OR LARGER WINDOWS INDICATIVE OF LIVING AREAS); AND (II) HORIZONTAL AND VERTICAL VARIATIONS IN WALL PLANES. IF THE FINAL ARCHITECTURAL DESIGN CANNOT MEET THE DESIGN STANDARDS FOR BLANK WALL ARTICULATION, ALTERNATIVE INNOVATIVE DESIGN SOLUTIONS MAY BE CONSIDERED FOR APPROVAL BY THE PLANNING DIRECTOR.

c. WHERE GROUND FLOOR CONNECTION TO UNITS IS NOT POSSIBLE AND A SHARED OR COMMON ENTRY IS USED, TRANSITION FROM THE STREET TO THE ENTRY ITSELF IS PROVIDED TO CREATE A UNIQUE SENSE OF ENTRY FOR PEDESTRIANS. THE GROUND LEVEL TRANSITIONS ARE THOUGHTFULLY DESIGNED AND INCORPORATED INTO THE OVERALL CHARACTER OF THE BUILDING AND INCLUDE ANY / ALL THE FOLLOWING: CHANGES IN GRADE OR SETBACK, STAIRS, LOW MASONRY WALLS, ORNAMENTAL RAILING, CHANGES IN PAVING MATERIAL, ADDITIONAL LANDSCAPING OR OTHER METHODS.

d. BUILDINGS ARE PLACED TO PRESENT A FRONT OR SIDE FAÇADE TO ALL NETWORK REQUIRED STREETS (PUBLIC OR PRIVATE).

e. BUILDINGS FRONT A MINIMUM OF 50% OF THE TOTAL NETWORK REQUIRED STREET FRONTAGE ON THE SITE (EXCLUSIVE OF DRIVEWAYS, PEDESTRIAN ACCESS, POINTS, ACCESSIBLE OPEN SPACE, TREE SAVE OR NATURAL AREAS, TREE REPLANTING AREAS AND STORM WATER FACILITIES).

f. PROVIDE USABLE AND ACCESSIBLE OPEN SPACE AT A MINIMUM OF 1 SQUARE FOOT/100 SQUARE FEET GROSS FLOOR AREA OR 1 SQUARE FEET /200 SQUARE FEET LOT AREA, WHICHEVER IS GREATER, INCORPORATING SEATING, PLANTINGS AND/OR OTHER AMENITIES.

g. INTERNAL SIDEWALK CONNECTIONS SHALL BE PROVIDED BETWEEN MULTI-FAMILY BUILDINGS AND FROM MULTI-FAMILY BUILDINGS TO ALL PUBLICLY ACCESSIBLE ON-SITE FACILITIES (PARKING AREAS, BICYCLE FACILITIES, OPEN SPACE, ETC.) AND ANY ABUTTING OR ADJACENT GREENWAYS, BIKEWAYS, TRAILS, DEVELOPMENTS AND TRANSIT STOPS. INTERNAL SIDEWALKS SHALL BE HARD SURFACED AND AT LEAST 5 FEET IN WIDTH UNLESS CONNECTING TO FOUR UNITS OR LESS.

h. FENCES OR WALLS USED FOR SCREENING SHALL BE CONSTRUCTED IN A DURABLE FASHION OF BRICK, STONE, OTHER FINISHED MASONRY MATERIALS, WOOD SPLIT-RAIL, METAL OR OTHER MATERIALS SPECIFICALLY DESIGNED AS FENCING MATERIALS.

i. SERVICE EQUIPMENT SUCH AS DUMPSTERS, REFUSE AREAS, RECYCLING AND STORAGE ARE SCREENED FROM VIEW FROM PUBLIC STREETS WITH LANDSCAPING AND MATERIALS AND DESIGN TO BE COMPATIBLE WITH PRINCIPAL STRUCTURES. SUCH DESIGN INCLUDES A MINIMUM 20% PREFERRED EXTERIOR BUILDING MATERIALS OR A CLASS B BUFFER NOT LESS THAN 10 FEET IN DEPTH AT ALL ABOVE GRADE PERIMETER NOT PAVED FOR ACCESS.

j. ALL ROOFTOP MECHANICAL EQUIPMENT ON BUILDINGS SHALL BE SCREENED FROM THE PUBLIC PRIMARY VIEW FROM BELOW BY INTEGRATING THE EQUIPMENT INTO THE BUILDING AND ROOF DESIGN TO THE MAXIMUM EXTENT FEASIBLE, USING PARAPET WALLS OR SIMILAR ARCHITECTURAL TREATMENTS.

k. VENTILATION GRATES OR EMERGENCY EXIT DOORS LOCATED AT THE FIRST FLOOR LEVEL IN THE BUILDING FAÇADE ORIENTED TO ANY PUBLIC STREET MUST BE DECORATIVE.

l. FOR PITCHED ROOFS (NOT INCLUDING DETAILS THAT MAY INCLUDE CRICKETS, TOWERS OR OTHER ELEMENTS THAT SLOPE BACK TO THE PRIMARY ROOF) THE MINIMUM (4:12), EXCLUDING BUILDINGS WITH A FLAT ROOF AND PARAPET WALLS.

**7. ENVIRONMENTAL FEATURES:**

a. THE SITE SHALL COMPLY WITH THE CHARLOTTE CITY COUNCIL APPROVED AND ADOPTED POST CONSTRUCTION STORMWATER ORDINANCE.

b. THE LOCATION, SIZE, AND TYPE OF STORM WATER MANAGEMENT SYSTEM DEPICTED ON THE REZONING PLAN ARE SUBJECT TO REVIEW AND APPROVAL AS PART OF THE FULL DEVELOPMENT PLAN SUBMITTAL AND ARE NOT IMPLICITLY APPROVED WITH THIS REZONING PETITION. ADJUSTMENTS MAY BE NECESSARY IN ORDER TO ACCOMMODATE ACTUAL STORM WATER TREATMENT REQUIREMENTS AND NATURAL SITE DISCHARGE POINTS.

c. THE SITE SHALL COMPLY WITH THE TREE ORDINANCE.

**8. LIGHTING:**

a. ALL NEW ATTACHED AND DETACHED LIGHTING SHALL BE FULLY SHIELDED DOWNWARDLY DIRECTED AND FULL CUT OFF FIXTURE TYPE LIGHTING EXCLUDING LOWER, DECORATIVE LIGHTING THAT MAY BE INSTALLED ALONG THE DRIVEWAYS, SIDEWALKS, AND PARKING AREAS.

b. DETACHED LIGHTING ON THE SITE, EXCEPT STREETLIGHTS LOCATED ALONG PUBLIC STREETS, WILL BE LIMITED TO 22 FEET IN HEIGHT.

**9. AMENDMENTS TO THE REZONING PLAN:**

a. FUTURE AMENDMENTS TO THE REZONING PLAN (WHICH INCLUDES THESE DEVELOPMENT STANDARDS) MAY BE APPLIED FOR BY THE THEN OWNER OR OWNERS OF THE APPLICABLE DEVELOPMENT AREA OR PORTION OF THE SITE AFFECTED BY SUCH AMENDMENT IN ACCORDANCE WITH THE PROVISIONS HEREIN AND OF CHAPTER 6 OF THE ORDINANCE.

**10. BINDING EFFECT OF THE REZONING APPLICATION:**


a. IF THIS REZONING PETITION IS APPROVED, ALL CONDITIONS APPLICABLE TO THE DEVELOPMENT OF THE SITE IMPOSED UNDER THE REZONING PLAN WILL, UNLESS AMENDED IN THE MANNER PROVIDED HEREIN AND UNDER THE ORDINANCE, BE BINDING UPON AND INURE TO THE BENEFIT OF THE PETITIONER AND SUBSEQUENT OWNERS OF THE SITE OR DEVELOPMENT AREAS, AS APPLICABLE, AND THEIR RESPECTIVE HEIRS, DEVISEES, PERSONAL REPRESENTATIVES, SUCCESSORS IN INTEREST OR ASSIGNS.

C:\Users\jg3000\Documents\029-651-003 - FLOURNOY - JOHN ADAMS PROPERTY - RZ - RZ-02 - SHEETS - RZ-02.DWG



LANDSCAPE ARCHITECTURE  
CIVIL ENGINEERING  
TRANSPORTATION PLANNING

2459 Wilkinson Blvd, Ste 200 Charlotte, NC 28208  
704.343.0608  
www.drgp.com

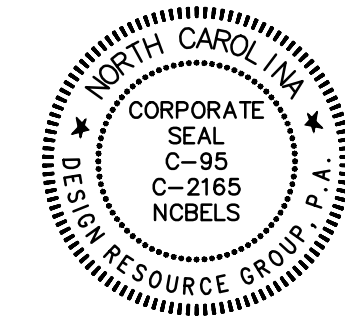

REZONING PETITION  
FOR PUBLIC HEARING  
2020-048  
REZONING PETITION

JOHN ADAMS PROPERTY  
CHARLOTTE, NORTH CAROLINA  
FLOURNOY DEVELOPMENT GROUP  
1100 BROOKSTONE CENTRE PARKWAY  
COLUMBUS, GA 31904

**DEVELOPMENT STANDARDS**




PROJECT #: 501-003  
DRAWN BY: JO  
CHECKED BY: NB

MARCH 5, 2020

REVISIONS:  
1. 05/11/20 - PER REVIEW COMMENTS  
2. 07/27/20 - PER REVIEW COMMENTS

RZ 3.0



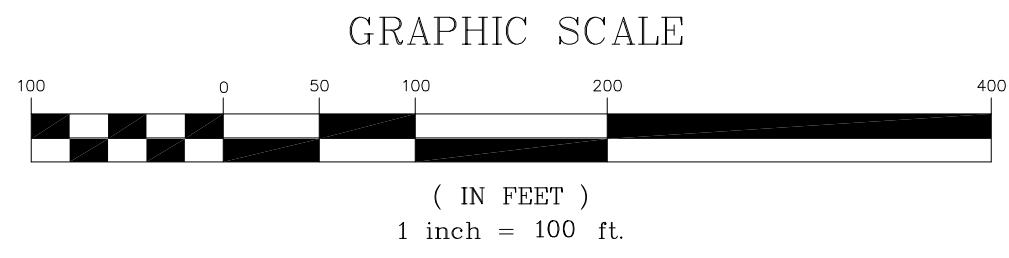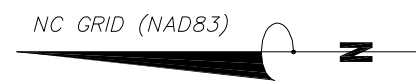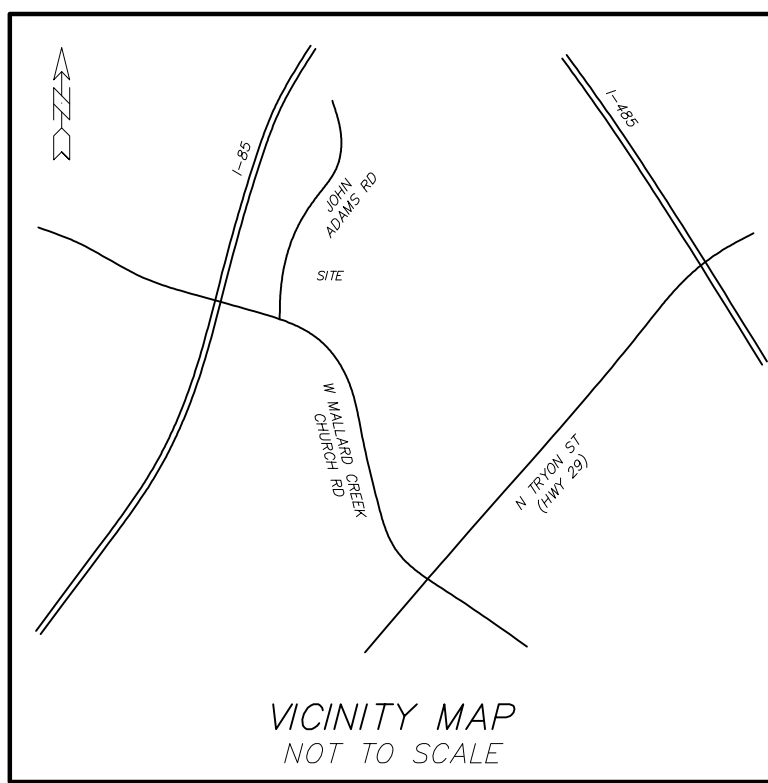

LINE	BEARING	LENGTH
L1	N60°02'53"W	40.14
L2	N60°02'53"W	244.52
L3	N37°20'24"W	82.53
L4	N08°00'03"E	182.65
L5	N19°44'18"W	66.58
L6	N38°31'17"E	286.62
L7	S75°58'13"E	60.44

CURVE	RADIUS	LENGTH	BEARING	CHORD
C1	1502.39	369.50	N55°48'00"W	368.57
C2	2261.83	76.23	S06°25'23"W	76.22
C3	2261.83	1229.01	S22°57'18"W	1213.95
C4	984.83	78.63	N36°14'04"E	78.61


21 NCAC 56 .1604 - MAP CERTIFICATION

I CERTIFY THAT THIS MAP WAS DRAWN UNDER MY SUPERVISION FROM AN ACTUAL SURVEY MADE UNDER MY SUPERVISION (TITLE REFERENCES AS SHOWN ON PLAT); THAT THE BOUNDARIES NOT SURVEYED ARE INDICATED AS DRAWN FROM TITLE REFERENCES AS SHOWN ON PLAT; THAT THE RATIO OF PRECISION OR POSITIONAL ACCURACY MEETS OR EXCEEDS 1:10,000; AND THAT THIS MAP MEETS THE REQUIREMENTS OF THE STANDARDS OF PRACTICE FOR LAND SURVEYING IN NORTH CAROLINA (21 NCAC 56 .1600).

THIS \_\_\_\_\_ DAY OF \_\_\_\_\_ 20\_\_\_\_

PROFESSIONAL LAND SURVEYOR

REVISIONS:	SCALE: 1" = 100'
DATE	2017/04/11 W MALLARD (ADAMS)
	2017 W M MALLARD (ADAMS)
	DRAWN BY: NB
	CHECKED BY: HW
	FIELD WORK: BC/GW
	MAY 11, 2017

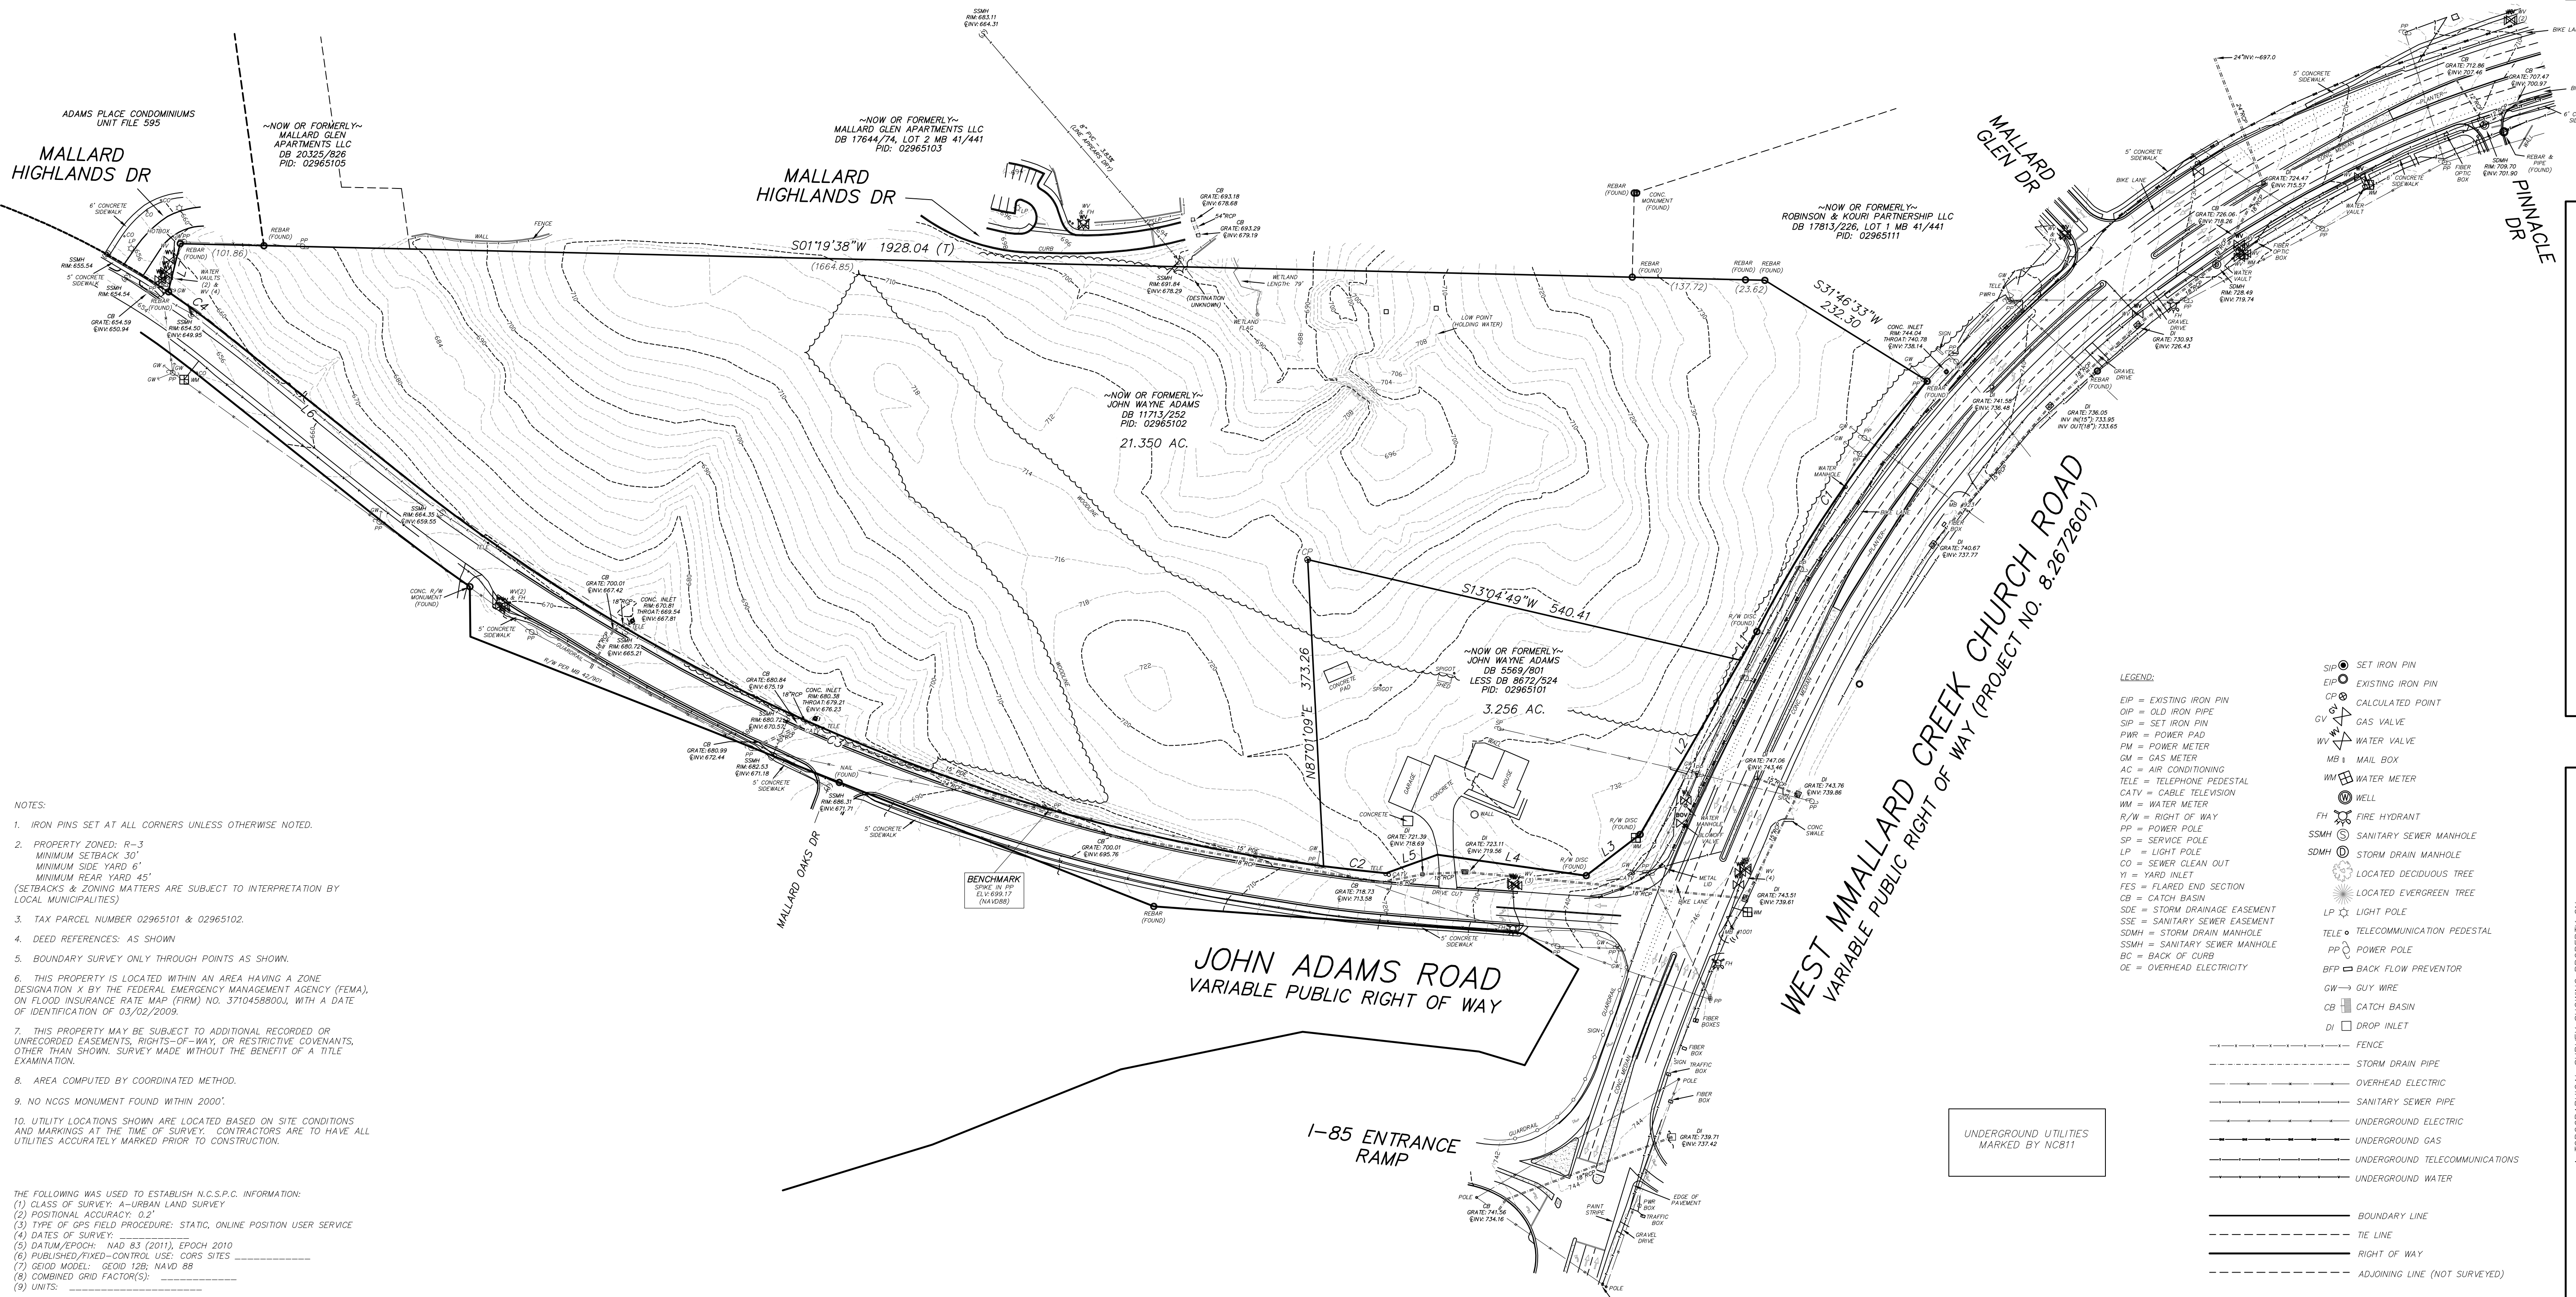

- NOTES:
- IRON PINS SET AT ALL CORNERS UNLESS OTHERWISE NOTED.
  - PROPERTY ZONED: R-3  
MINIMUM SETBACK 30'  
MINIMUM SIDE YARD 6'  
MINIMUM REAR YARD 45'  
(SETBACKS & ZONING MATTERS ARE SUBJECT TO INTERPRETATION BY LOCAL MUNICIPALITIES)
  - TAX PARCEL NUMBER 02965101 & 02965102.
  - DEED REFERENCES: AS SHOWN
  - BOUNDARY SURVEY ONLY THROUGH POINTS AS SHOWN.
  - THIS PROPERTY IS LOCATED WITHIN AN AREA HAVING A ZONE DESIGNATION X BY THE FEDERAL EMERGENCY MANAGEMENT AGENCY (FEMA), ON FLOOD INSURANCE RATE MAP (FIRM) NO. 3710458800J, WITH A DATE OF IDENTIFICATION OF 03/02/2009.
  - THIS PROPERTY MAY BE SUBJECT TO ADDITIONAL RECORDED OR UNRECORDED EASEMENTS, RIGHTS-OF-WAY, OR RESTRICTIVE COVENANTS, OTHER THAN SHOWN. SURVEY MADE WITHOUT THE BENEFIT OF A TITLE EXAMINATION.
  - AREA COMPUTED BY COORDINATED METHOD.
  - NO NCDS MONUMENT FOUND WITHIN 2000'.
  - UTILITY LOCATIONS SHOWN ARE LOCATED BASED ON SITE CONDITIONS AND MARKINGS AT THE TIME OF SURVEY. CONTRACTORS ARE TO HAVE ALL UTILITIES ACCURATELY MARKED PRIOR TO CONSTRUCTION.

THE FOLLOWING WAS USED TO ESTABLISH N.C.S.P.C. INFORMATION:  
 (1) CLASS OF SURVEY: A-URBAN LAND SURVEY  
 (2) POSITIONAL ACCURACY: 0.2"  
 (3) TYPE OF GPS FIELD PROCEDURE: STATIC, ONLINE POSITION USER SERVICE  
 (4) DATES OF SURVEY:  
 (5) DATUM/EPOCH: NAD 83 (2011), EPOCH 2010  
 (6) PUBLISHED/PKED-CONTROL USE: CORS SITES  
 (7) GEIOD MODEL: GEIOD 12B; NAVD 88  
 (8) COMBINED GRID FACTOR(S):  
 (9) UNITS: \_\_\_\_\_

- LEGEND:
- SP - SET IRON PIN
  - EP - EXISTING IRON PIN
  - OP - OLD IRON PIPE
  - SIP - SET IRON PIPE
  - PMR - POWER PAD
  - FM - POWER METER
  - GM - GAS METER
  - AC - AIR CONDITIONING
  - TELE - TELEPHONE PEDESTAL
  - CATV - CABLE TELEVISION
  - WM - WATER METER
  - R/W - RIGHT OF WAY
  - PP - POWER POLE
  - SP - SERVICE POLE
  - LP - LIGHT POLE
  - CD - SEWER CLEAN OUT
  - YI - YARD INLET
  - FES - FLARED END SECTION
  - SDE = STORM DRAINAGE EASEMENT
  - SSE = SANITARY SEWER EASEMENT
  - SDMH = STORM DRAIN MANHOLE
  - SSMH = SANITARY SEWER MANHOLE
  - BC = BACK OF CURB
  - OE = OVERHEAD ELECTRICITY
  - ST - SET IRON PIN
  - EP - EXISTING IRON PIN
  - CP - CALCULATED POINT
  - GV - GAS VALVE
  - WV - WATER VALVE
  - MB - MAIL BOX
  - WM - WATER METER
  - WH - WELL
  - FH - FIRE HYDRANT
  - SSMH - SANITARY SEWER MANHOLE
  - SDMH - STORM DRAIN MANHOLE
  - CD - SEWER CLEAN OUT
  - YI - YARD INLET
  - FES - FLARED END SECTION
  - SDE = STORM DRAINAGE EASEMENT
  - SSE = SANITARY SEWER EASEMENT
  - SDMH = STORM DRAIN MANHOLE
  - SSMH = SANITARY SEWER MANHOLE
  - BC = BACK OF CURB
  - OE = OVERHEAD ELECTRICITY
  - STORM DRAIN PIPE
  - OVERHEAD ELECTRIC
  - SANITARY SEWER PIPE
  - UNDERGROUND ELECTRIC
  - UNDERGROUND GAS
  - UNDERGROUND TELECOMMUNICATIONS
  - UNDERGROUND WATER
  - BOUNDARY LINE
  - TIE LINE
  - RIGHT OF WAY
  - ADJOINING LINE (NOT SURVEYED)

UNDERGROUND UTILITIES MARKED BY NC811

CAROLINA SURVEYORS, INC.  
 P.O. BOX 267 PINEVILLE, N.C. 28134 - 0267  
 HUGH E. WHITE, JR., N.C.R.L.S. & S.C.R.L.S. 889 - 7601  
 CERTIFICATE OF AUTHORIZATION N.C.G.-1242 SC1886

WEST MALLARD CREEK CHURCH ROAD  
 A TOPOGRAPHICAL SURVEY SHOWING PROPERTY ON  
 SURVEYED FOR:  
 TOTAL AREA: 24.606 ACRES  
 CITY OF CHARLOTTE, MECKLENBURG COUNTY, NORTH CAROLINA